


13+260

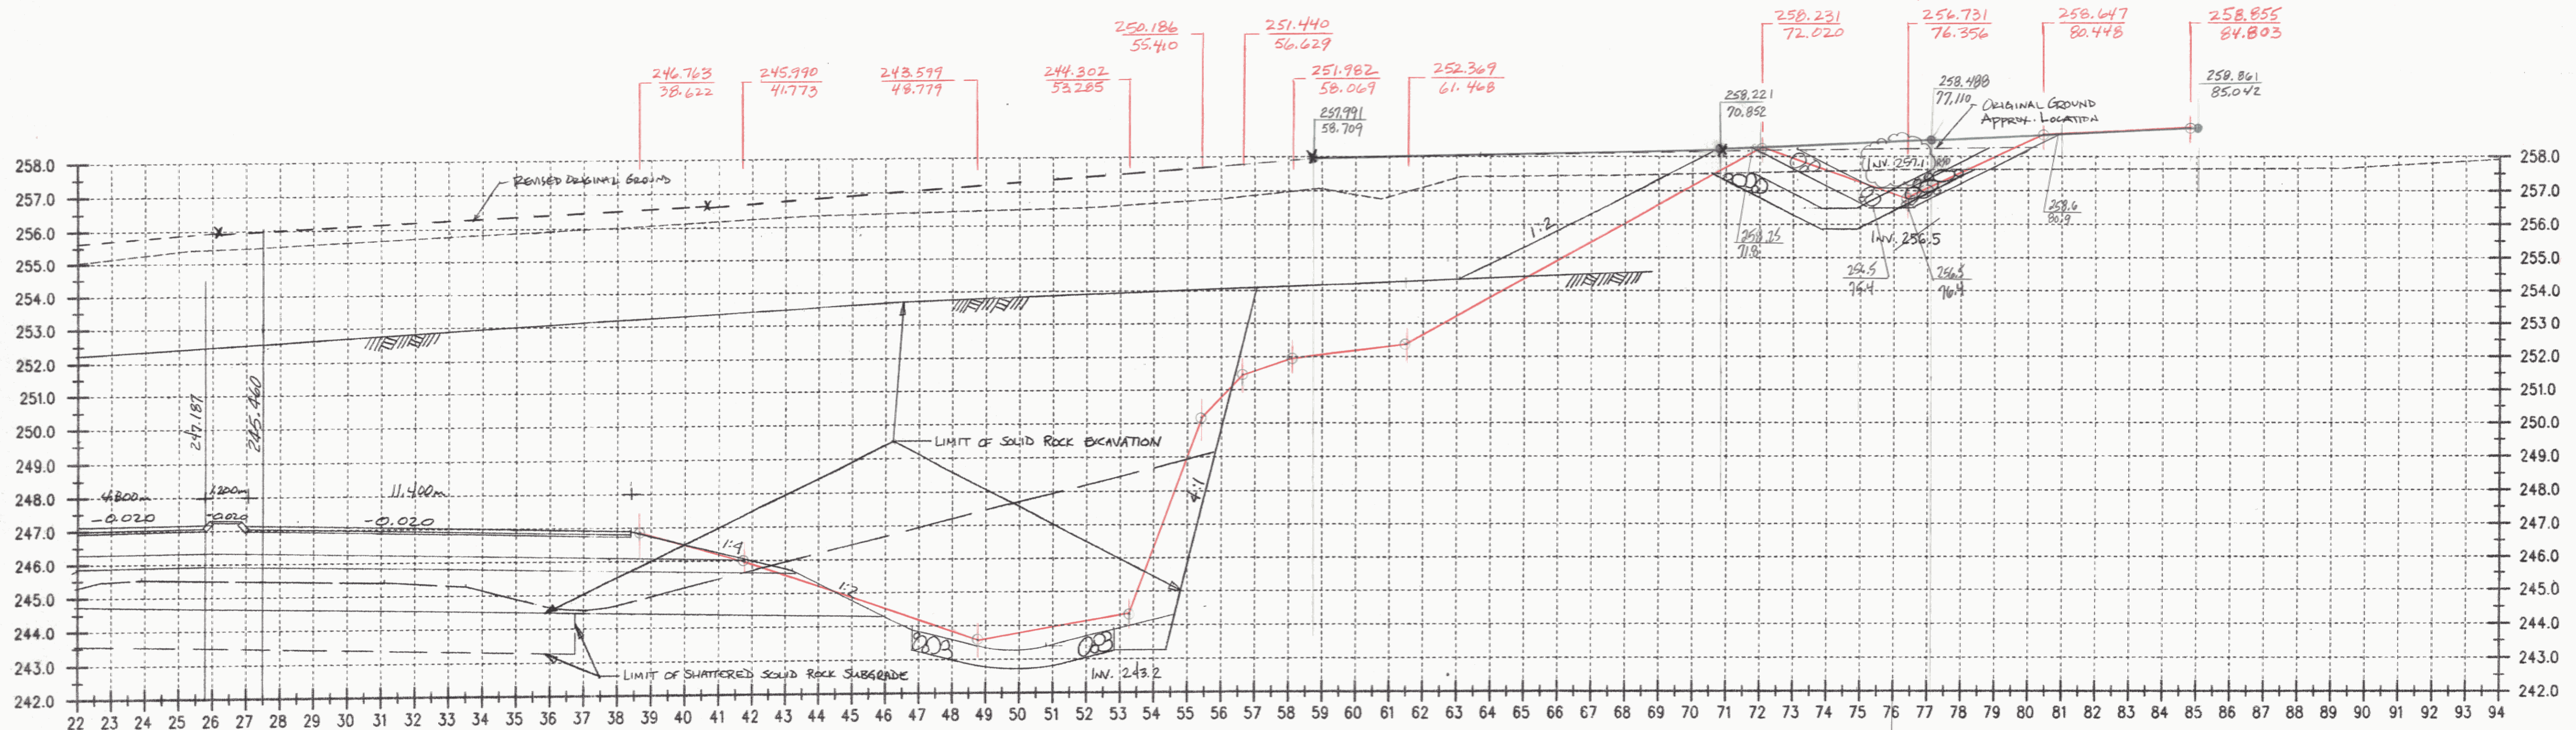


13+260

C = 760  
F = 45  
R = 517

FG. RMT 11/3/05

ALL DIMENSIONS IN MILLIMETERS EXCEPT AS INDICATED

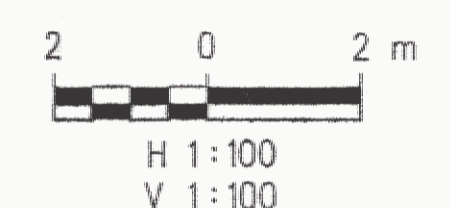

|            |           |
|------------|-----------|
| DATUM      |           |
| VERTICAL   | NAVD 1988 |
| HORIZONTAL | N/A       |

|                 |   |              |       |
|-----------------|---|--------------|-------|
| SURVEYED BY     | C.H.A. & V.S.E.                         | DATE         |       |
| DRAWN BY        | J.S.L.                                  | DATE         |       |
| SQUAD LEADER    | T.P.K.                                  | Rev.         | 0/0/0 |
| DESIGN FILE NO. | N/A                                     |              |       |
| IPARM FILE      |   | DATE PLOTTED |       |
| PROJ. NAME      | BENNINGTON - HOOSICK D.P.I. 0146(1) c/3 |              |       |
| PROJ. NO.       | P.I.N. 1306.60.201                      |              |       |
| SHEET           | 241 OF 473 SHEETS                       |              |       |

RSD