


SEE REVISED SHEET #352, DATED 01/03 (ATTACHED) RMT 11/24/05

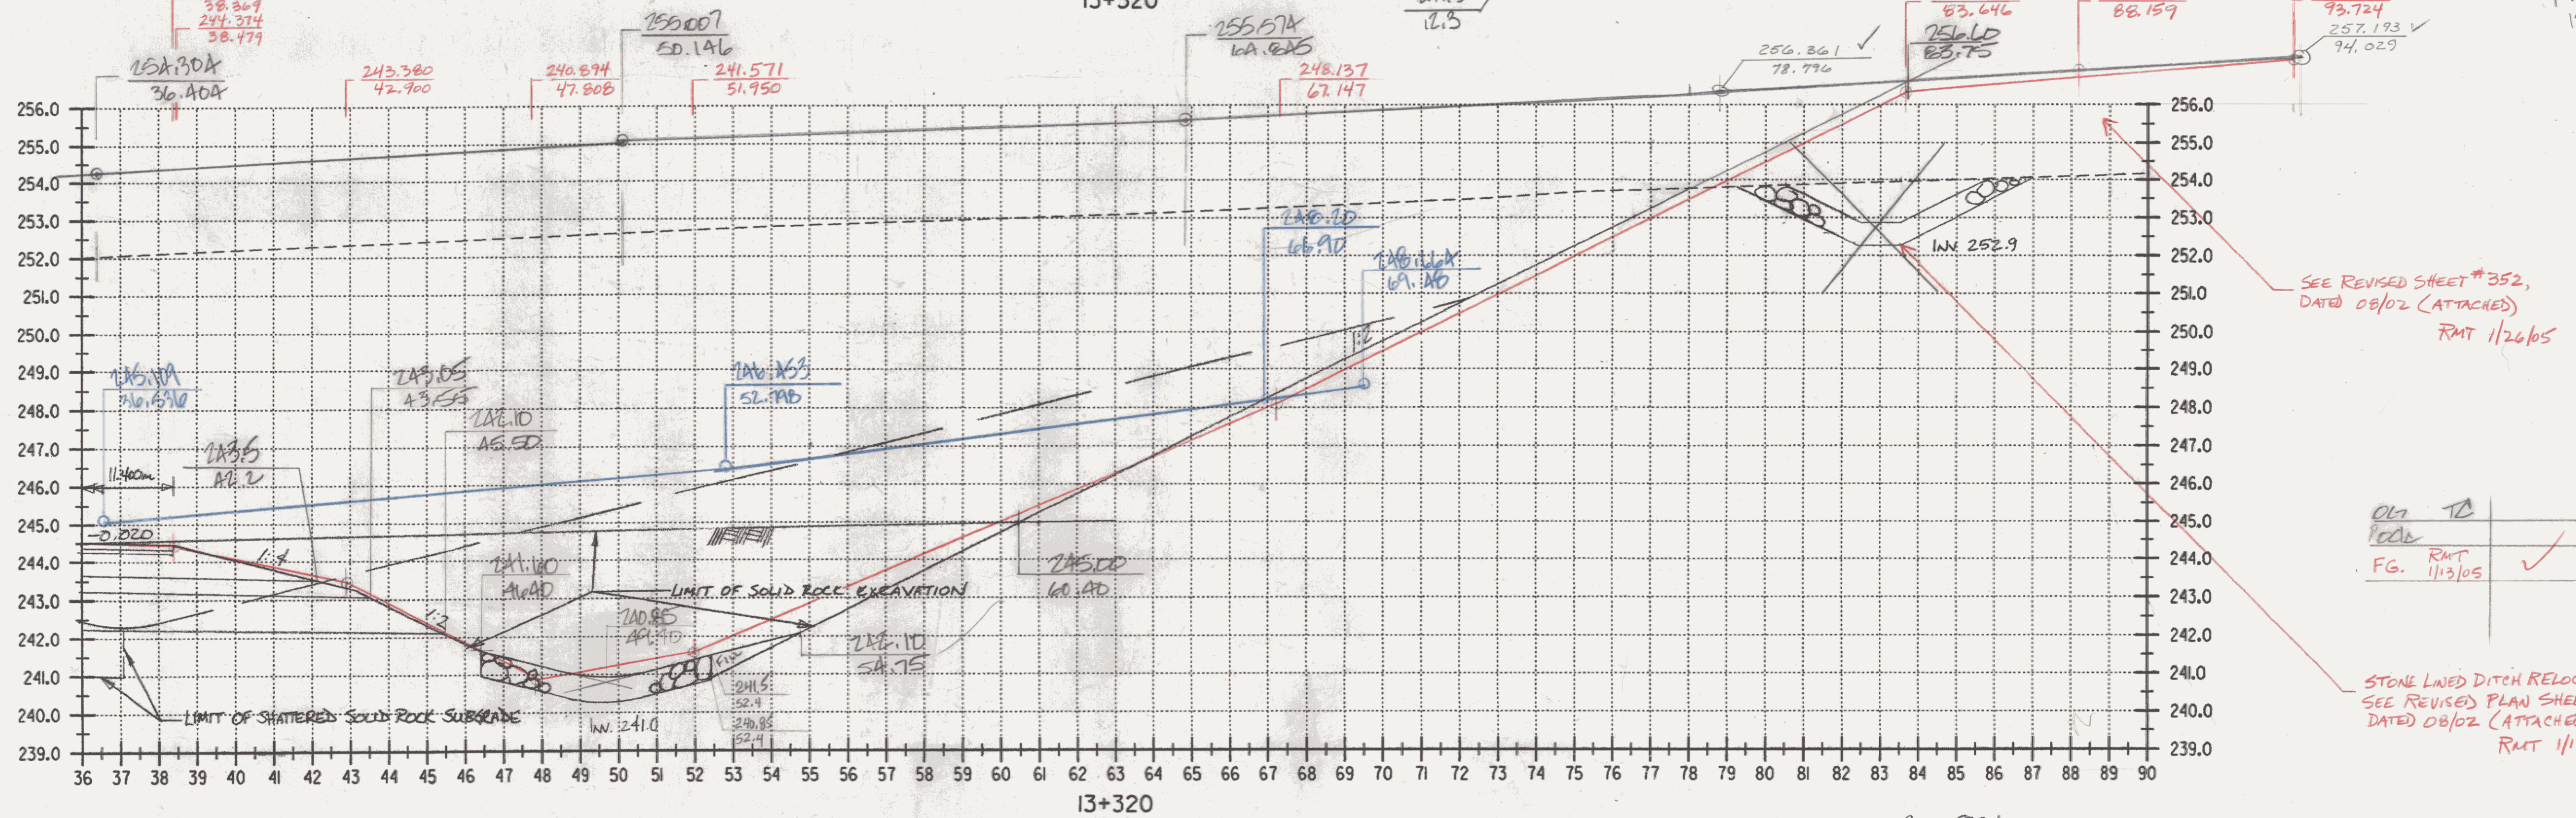

SEE REVISED SHEET #352, DATED 08/02 (ATTACHED) RMT 11/26/05

CGI TO PCDL FG. RMT 11/3/05 ✓

STONE LINED DITCH RELOCATED. SEE REVISED PLAN SHEET #77, DATED 08/02 (ATTACHED) RMT 11/3/05

$C = 821$
 $F = 32.70 + 32.99 + 1.34 = 35.09m^2$
 $R = 142 \quad 246.03$

DATUM	
VERTICAL	NAVD 88
HORIZONTAL	NAD 83 (1992)

ALL DIMENSIONS IN MILLIMETERS EXCEPT AS INDICATED

2 0 2 m

H 1:100
V 1:100

SURVEYED BY	C.H.A. & V.S.E.	DATE	12/93
DRAWN BY	J.S.L.	DATE	7/01
SQUAD LEADER	T.P.K.		
DESIGN FILE NO.	/5116/VAOT/VTSECT4.D		
IFIRM		DATE PLOTTED	
PROJ. NAME	BENNINGTON - HOOSICK D.P.L. 0146(1) C/3 SFA 13+320		
PROJ. NO.	P.J.N. 1306.60		
SHEET	352 OF 473 SHEETS		