


FG. RMT  
1/24/05

C = 821  
F = 32  
R = 142

DATUM	
VERTICAL	NAVD 88
HORIZONTAL	NAD 83 (1992)

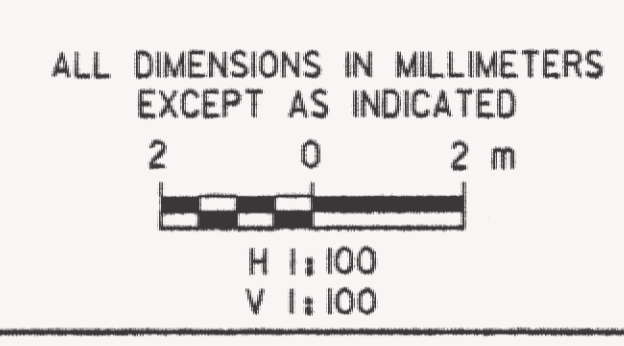

SURVEYED BY	C.H.A. & V.S.E.	DATE	12/93
DRAWN BY	J.S.L.	DATE	7/01
SQUAD LEADER	T.P.K.	REV.	08/02
DESIGN FILE NO.	/5116/VAOT/VTSECT4.D		
IPARM FILE	DATE PLOTTED		
PROJ. NAME	BENNINGTON - HOOSICK		
PROJ. NO.	P.I.N. 1306.60		
SHEET	382 OF 473 SHEETS		