


SEE REVISED SHEET # 353, DATED 01/03 (ATTACHED) RMT 11/24/05

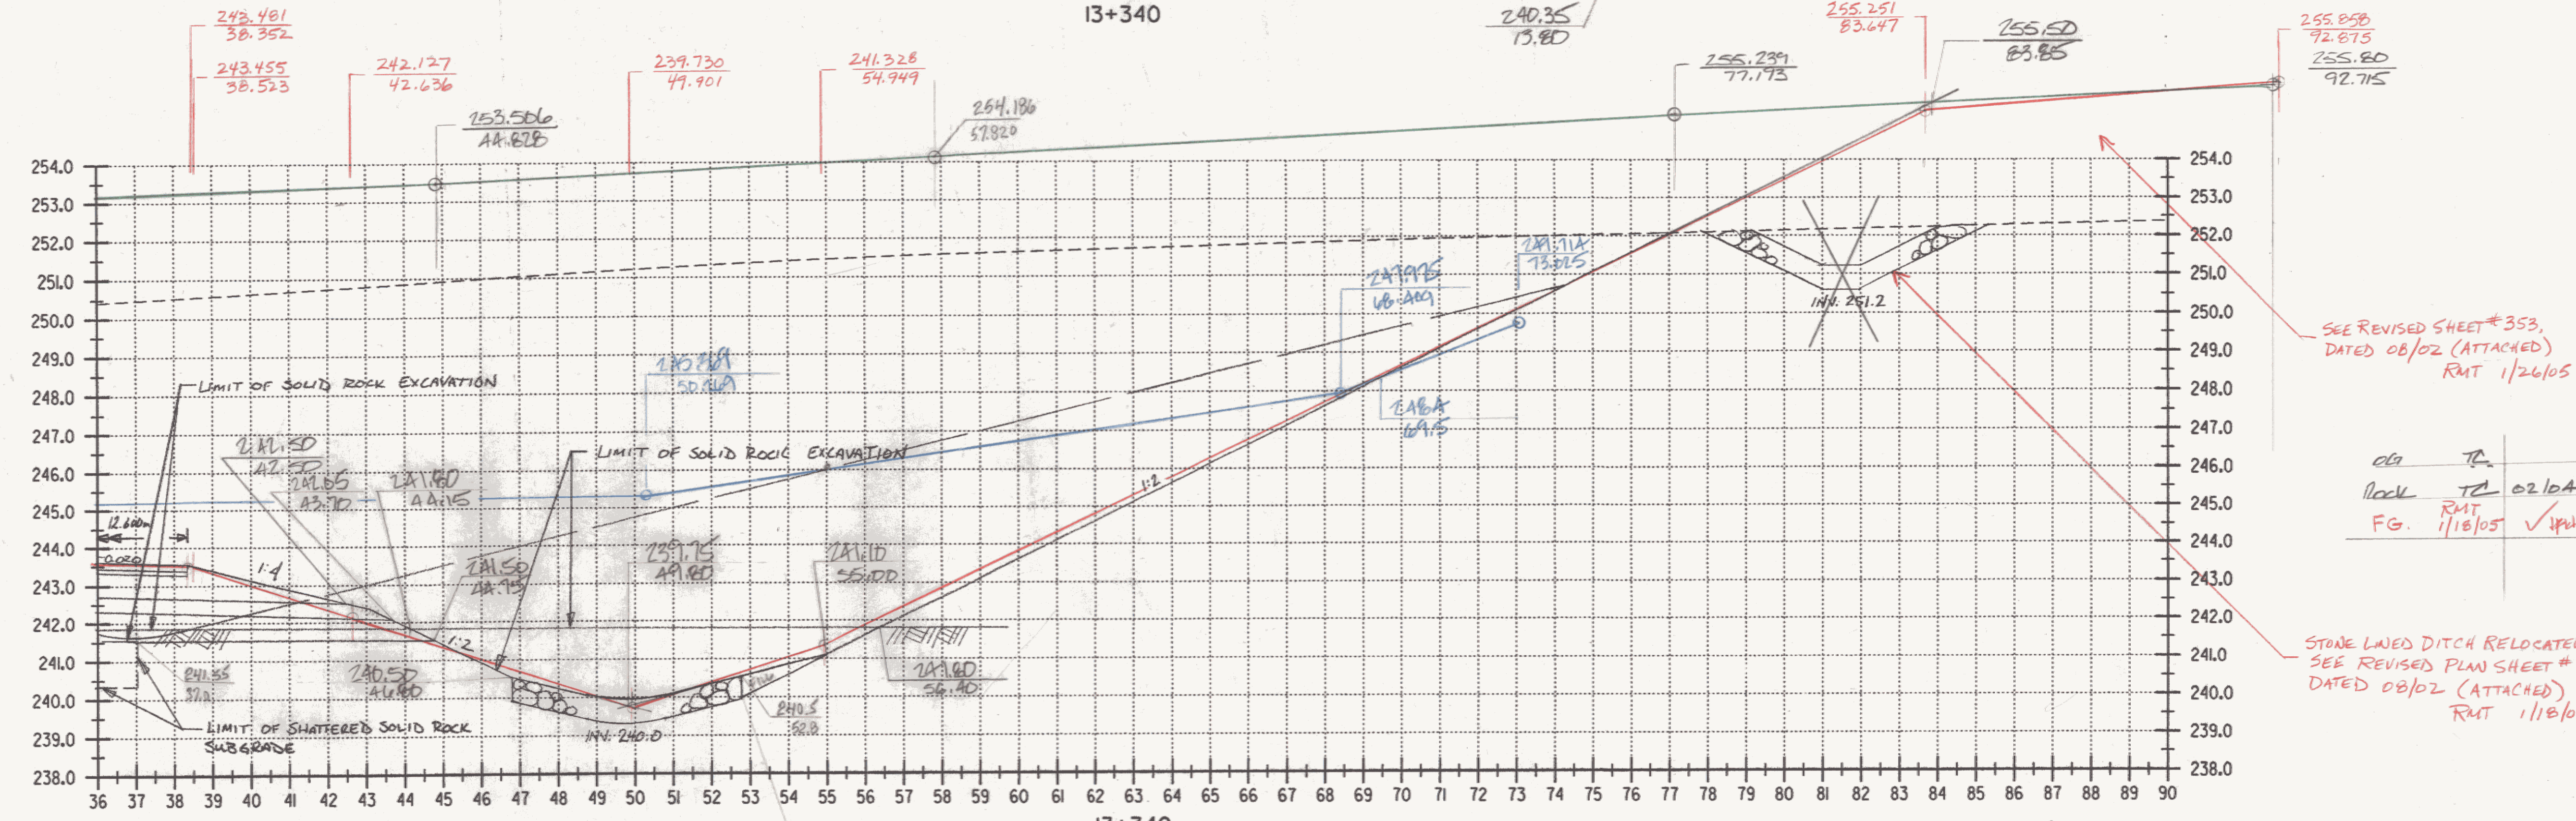


SEE REVISED SHEET # 353, DATED 08/02 (ATTACHED) RMT 1/26/05

CG TD
Rock TD 02/0A
FG RMT 1/18/05 ✓ 1/18/05

STONE LINED DITCH RELOCATED. SEE REVISED PLAN SHEET # 77, DATED 08/02 (ATTACHED) RMT 1/18/05

C = 732
F = 23
R = 61 207.14

DATUM	
VERTICAL	NAVD 88
HORIZONTAL	NAD 83 (1992)

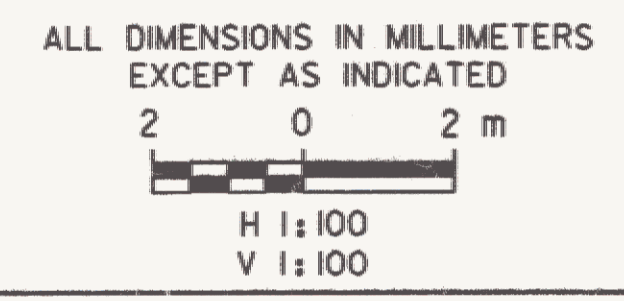

SURVEYED BY	C.H.A. & V.S.E.	DATE	12/93
DRAWN BY	J.S.L.	DATE	7/01
SQUAD LEADER	T.P.K.		
DESIGN FILE NO.	/5116/VAOT/VTSECT4.D		
IPARM FILE		DATE PLOTTED	
PROJ. NAME	BENNINGTON - HOOSICK D.P.L. 0146(1) C/3		
PROJ. NO.	P.I.N. 1306.60		
SHEET	353 OF 473 SHEETS		