


SEE REVISED SHEET # 356,  
DATED 01/03 (ATTACHED)  
RMT 1/21/05

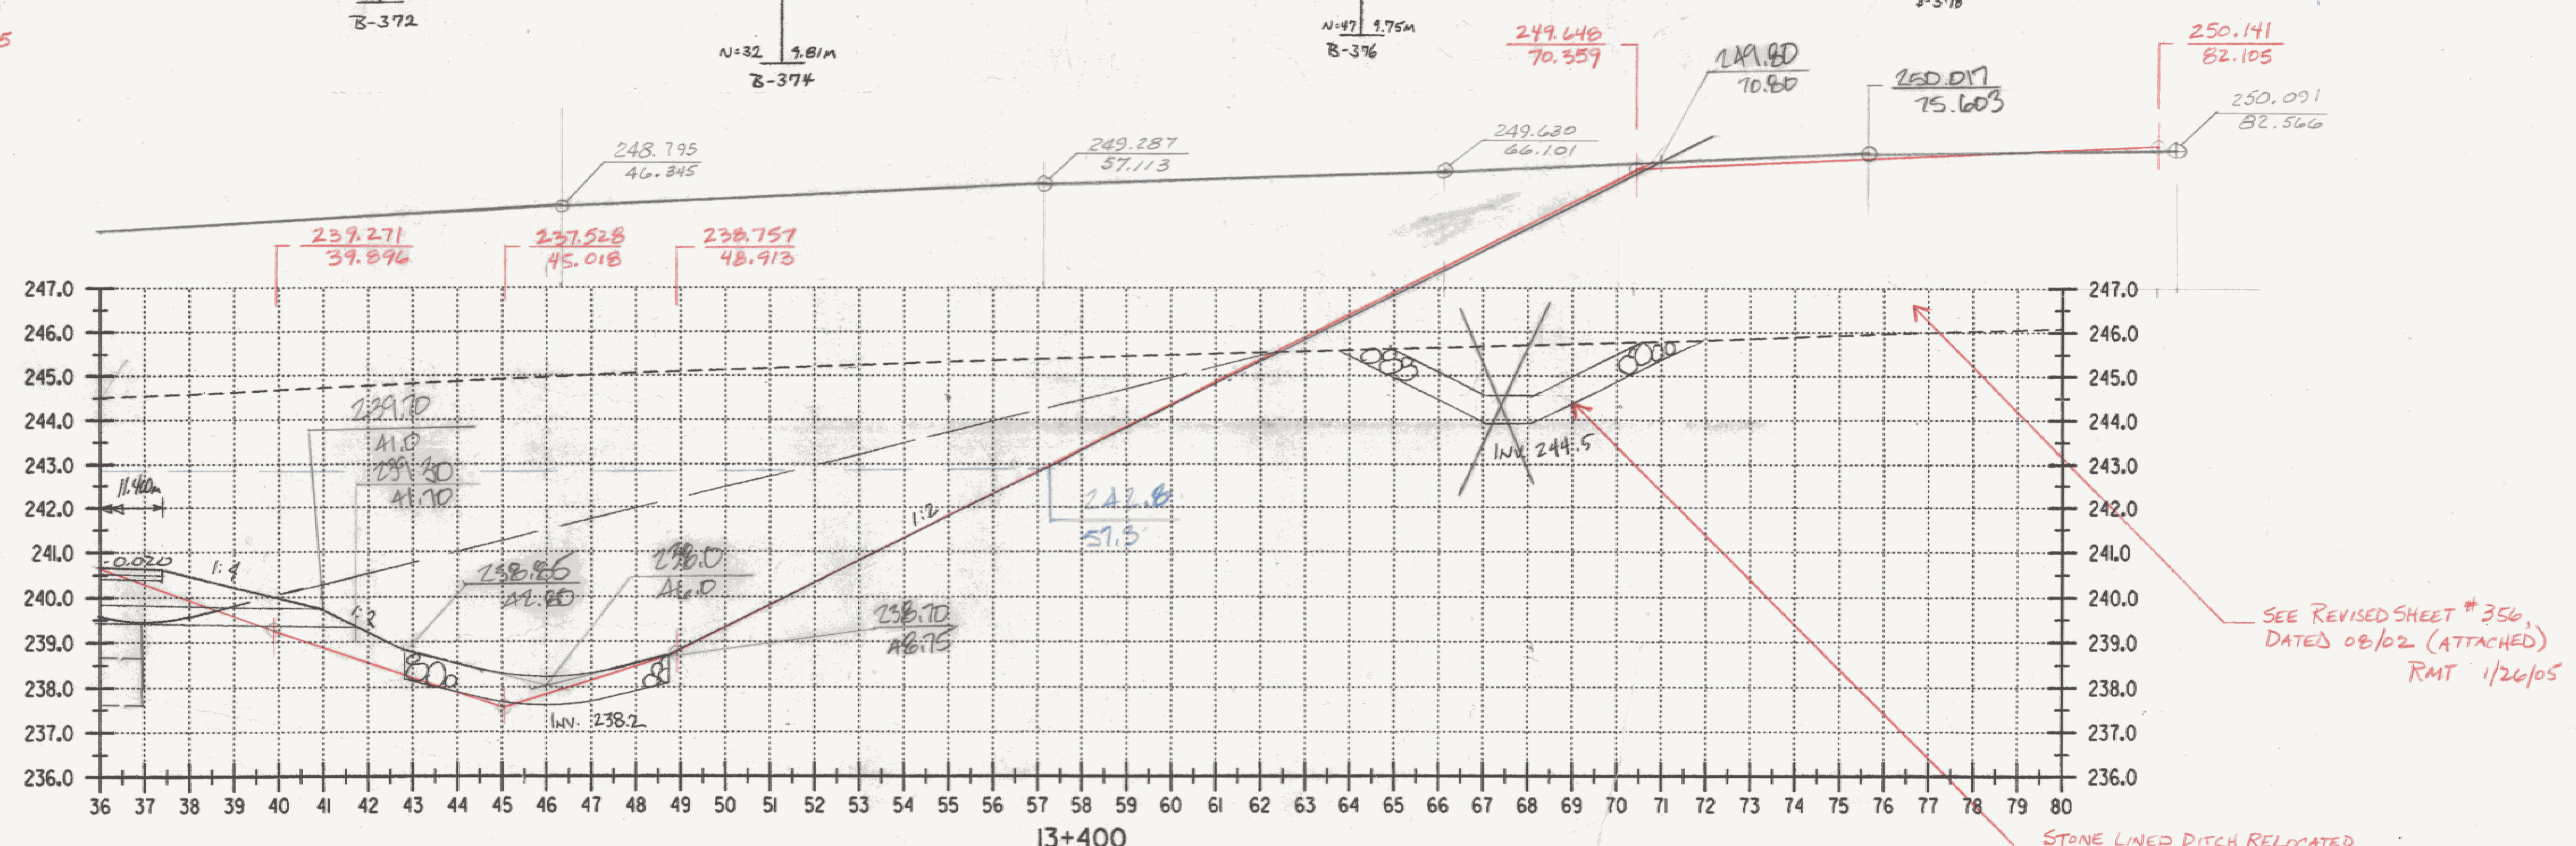

SEE REVISED SHEET # 356,  
DATED 08/02 (ATTACHED)  
RMT 1/26/05

C = 323  
F = 0 0.0m  
R = 0 145.63 SM

STONE LINED DITCH RELOCATED.  
SEE REVISED PLAN SHEET # 77,  
DATED 08/02 (ATTACHED).  
RMT 1/20/04

OG Plot by J.M. 10/23/02  
Chk by FG. RMT 1/20/05  
CHECKED ✓

DATUM	
VERTICAL	NAVD 88
HORIZONTAL	NAD 83 (1992)

ALL DIMENSIONS IN MILLIMETERS  
EXCEPT AS INDICATED  
2 0 2 m  
H 1:100  
V 1:100

SURVEYED BY	C.H.A. & V.S.E.	DATE	12/93
DRAWN BY	J.S.L.	DATE	7/01
SQUAD LEADER	T.P.K.		
DESIGN FILE NO.	/5116/VAOT/VTSECT4.D		
IPARM FILE		DATE PLOTTED	
PROJ. NAME	BENNINGTON - HOOSICK		
	D.P.I. 0146(1) C/3		
PROJ. NO.	P.I.N. 1306.60	STA	13+400
SHEET	356	OF 473 SHEETS	