



C = 91  
F = 0  
R = 0

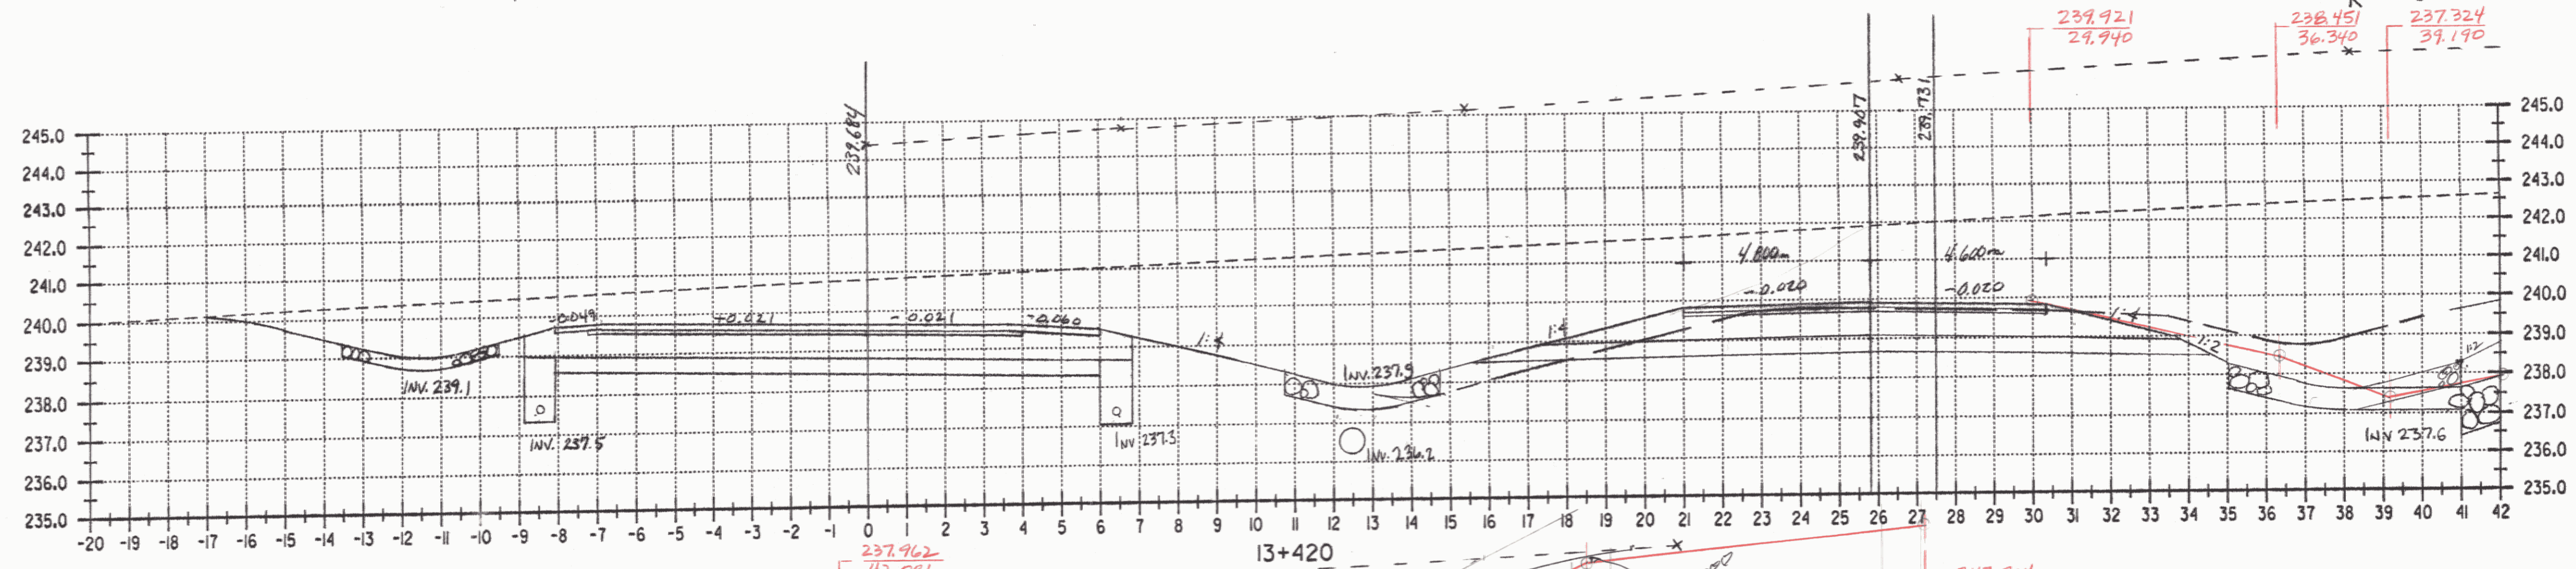

C = 91  
F = 0  
R = 0

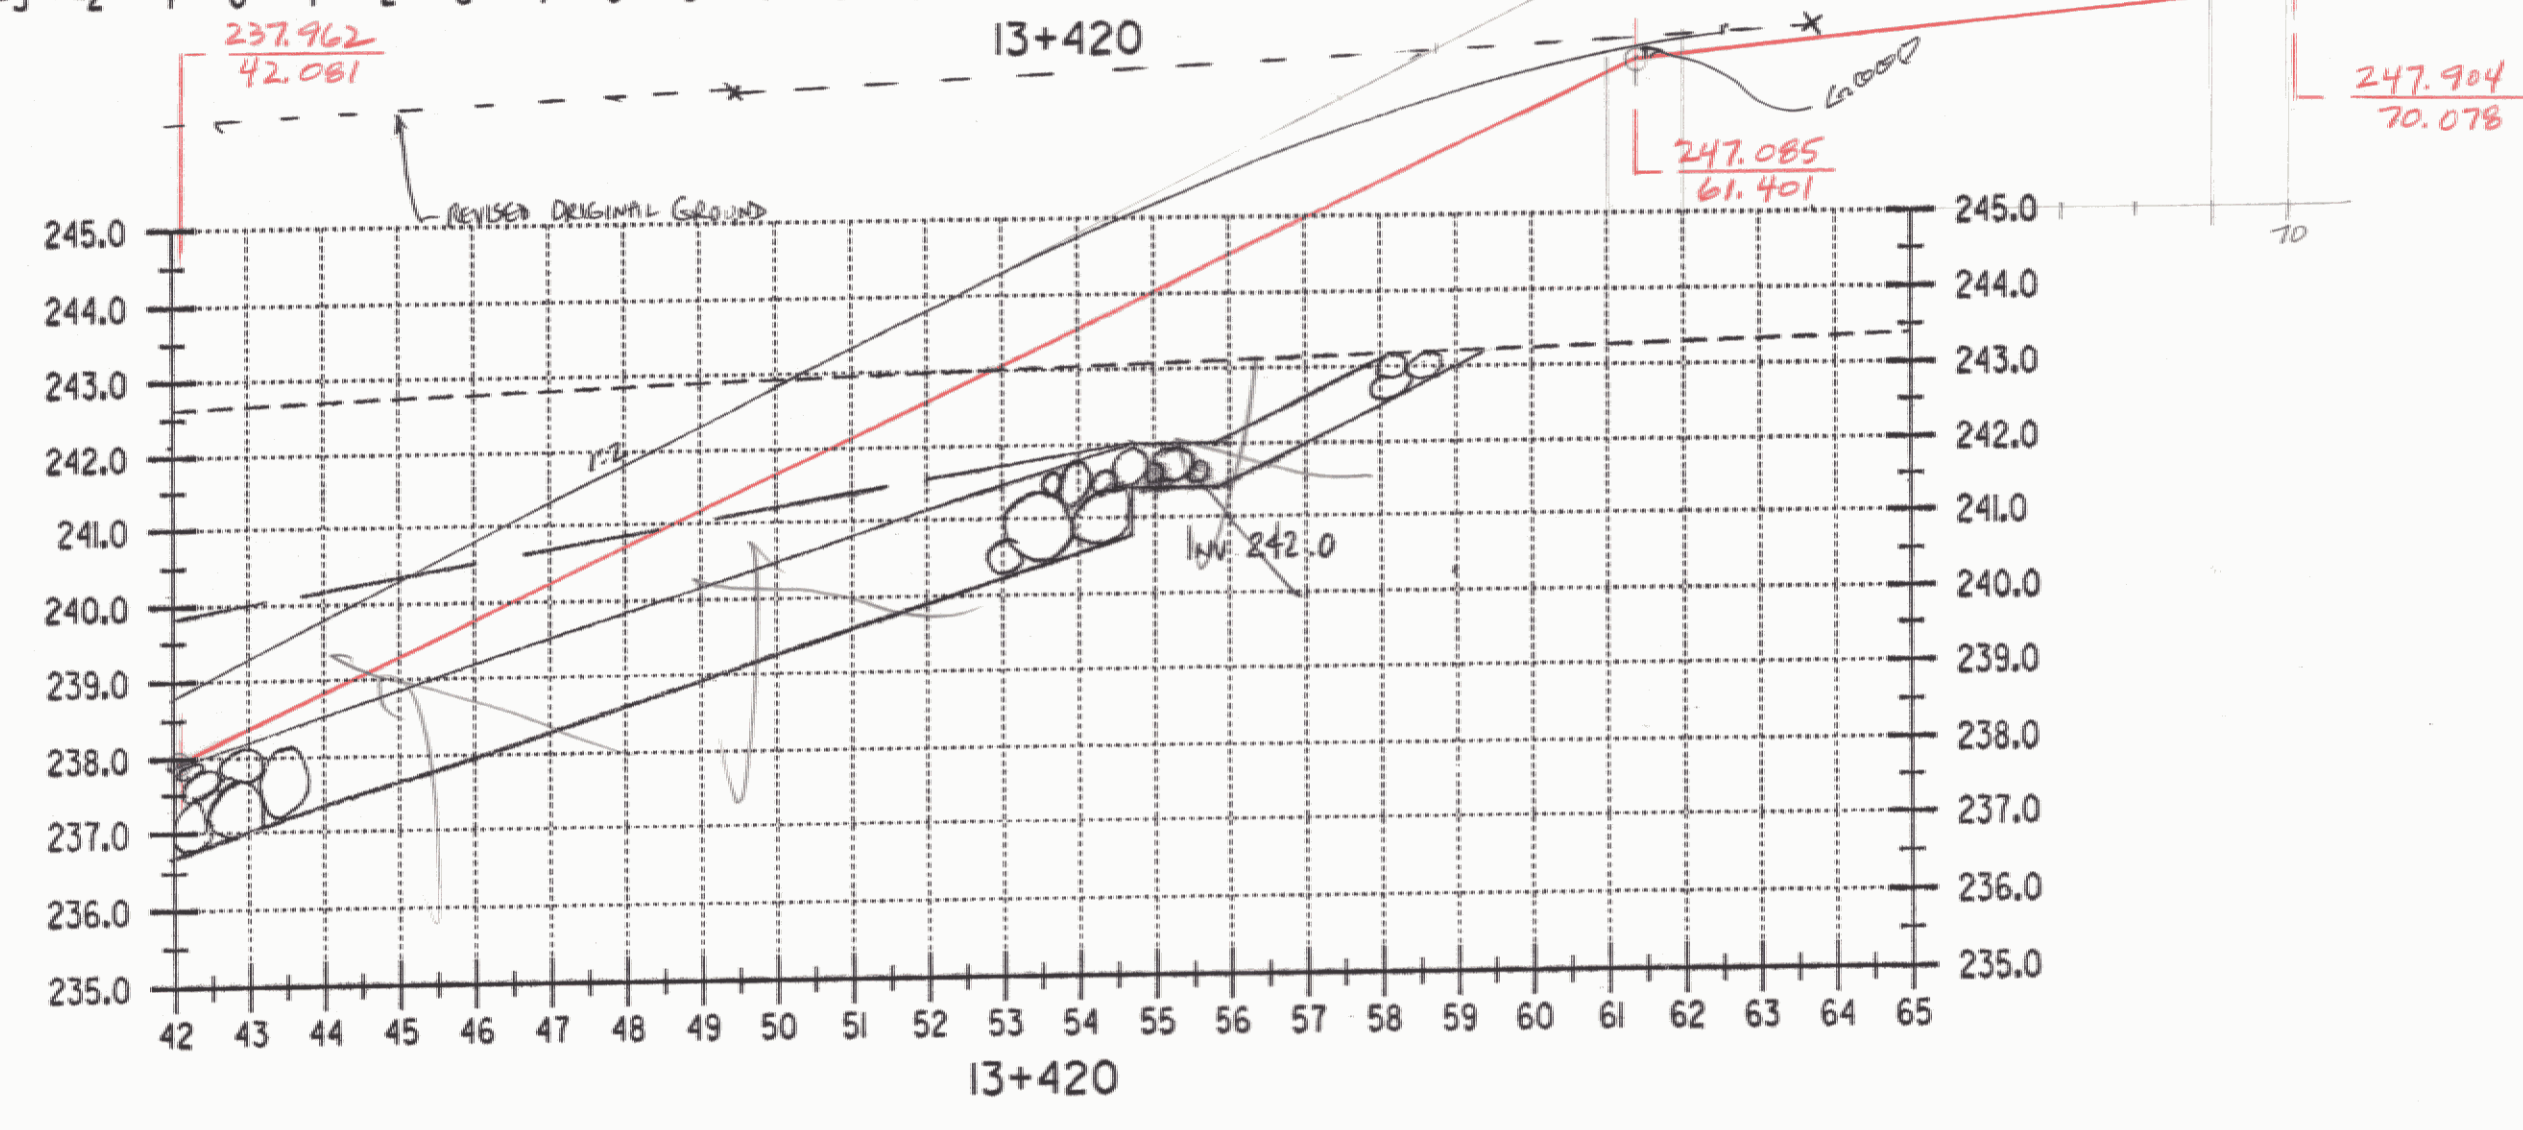

C = 203  
F = 0  
R = 0

FG. RMT  
1/26/05

DATUM	
VERTICAL	NAVD 88
HORIZONTAL	NAD 83 (1992)

ALL DIMENSIONS IN MILLIMETERS  
EXCEPT AS INDICATED  
2 0 2 m  
H 1:100  
V 1:100

SURVEYED BY	C.H.A. & V.S.E.	DATE	12/93
DRAWN BY	J.S.L.	DATE	7/01
SQUAD LEADER	T.P.K.		
DESIGN FILE NO.	/5116/VAOT/VTSECT4.D		
IPARM FILE		DATE PLOTTED	
PROJ. NAME	BENNINGTON - HOOSICK D.P.I. 0146(1) C/3		
PROJ. NO.	P.I.N. 1306.60		
SHEET	357 OF 473 SHEETS		

RSD