



FG. RMT 1/21/05
 C = 66
 F = 6
 R = 0

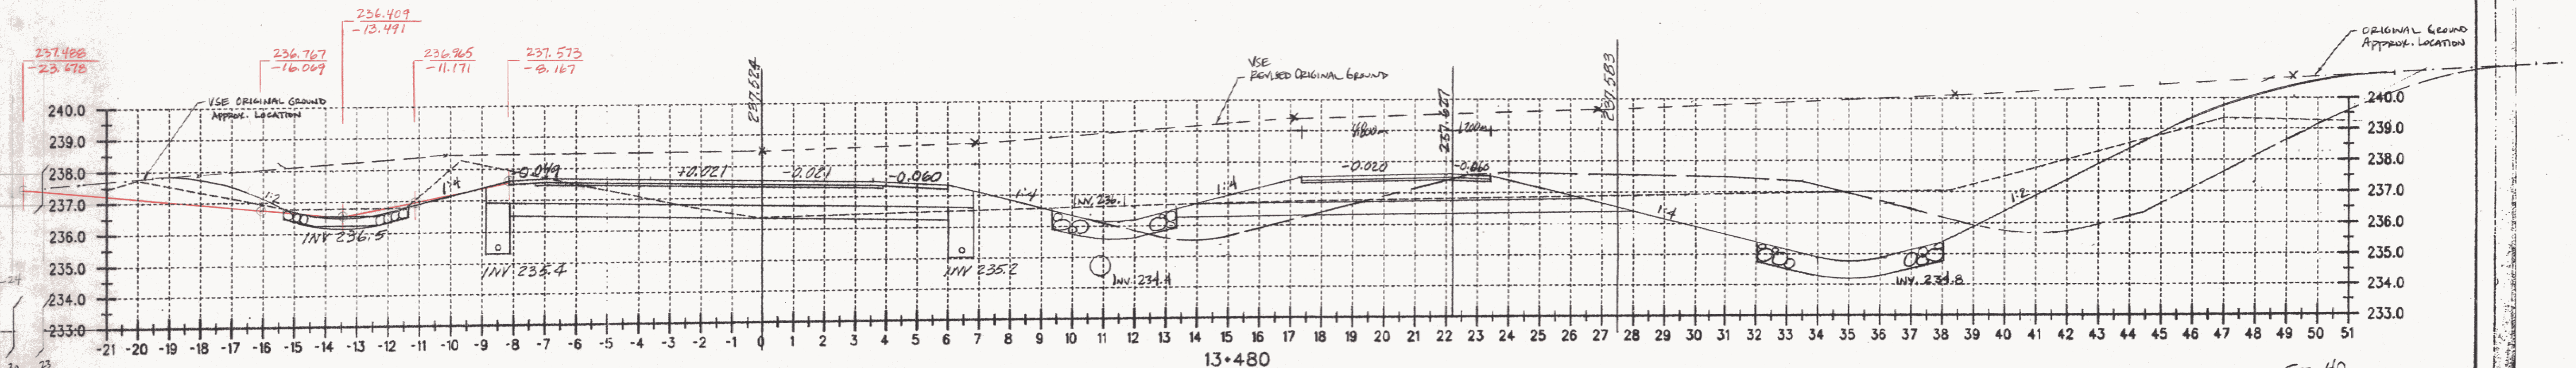

C = 40
 F = 1
 R = 0

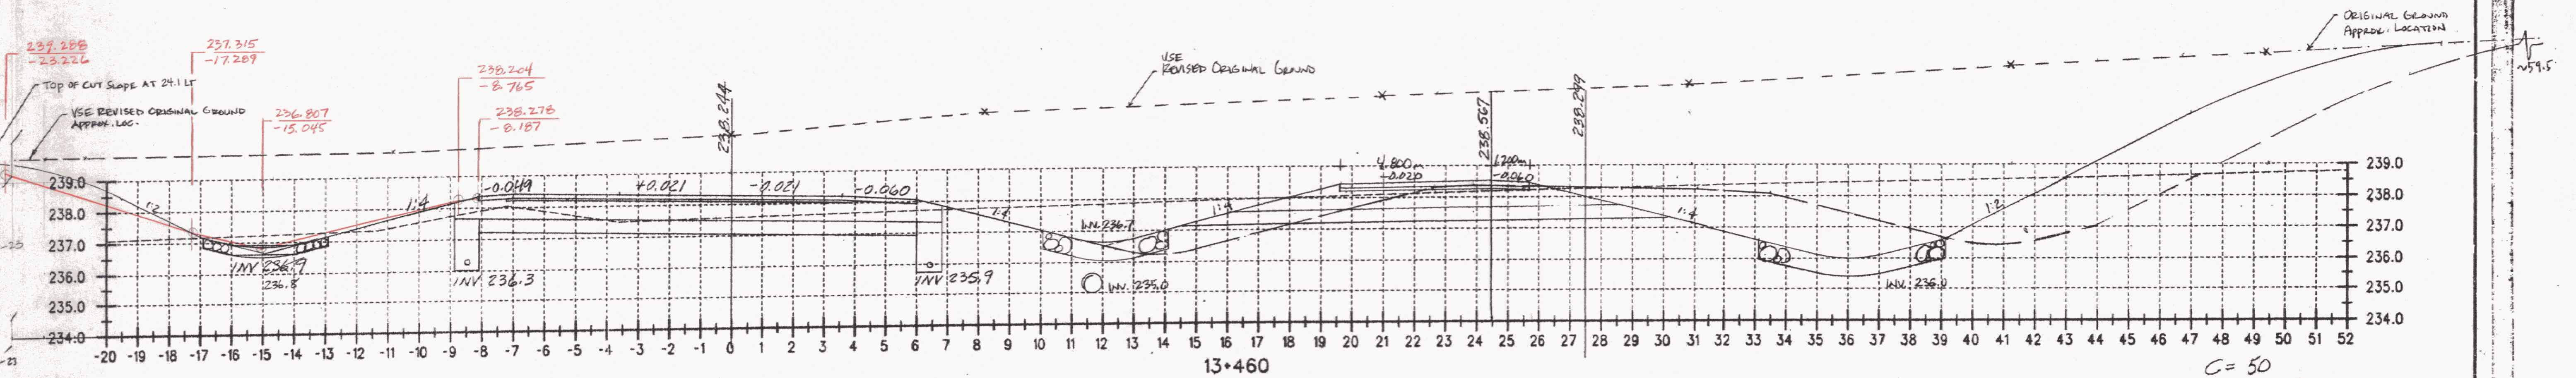

C = 50
 F = 1
 R = 0

DATUM
 VERTICAL NAD 88
 HORIZONTAL NAD 83 (1992)

ALL DIMENSIONS IN MILLIMETERS EXCEPT AS INDICATED
 2 0 2 m
 H 1:100
 V 1:100

SURVEYED BY C.H.A. & V.S.E. DATE
 DRAWN BY J.S.L. DATE
 SQUAD LEADER T.P.K. Rev. 08/02
 DESIGN FILE NO. N/A Rev. 01/03 RMT 1/21/05
 PARM FILE DATE PLOTTED
 PROJ. NAME BENNINGTON - HOOSICK D.P.I. 0146(1) C/3
 PROJ. NO. P.I.N. 1306.60.201
 SHEET 358 OF 473 SHEETS