


DATUM
 VERTICAL NAVD 88
 HORIZONTAL NAD 83 (1992)

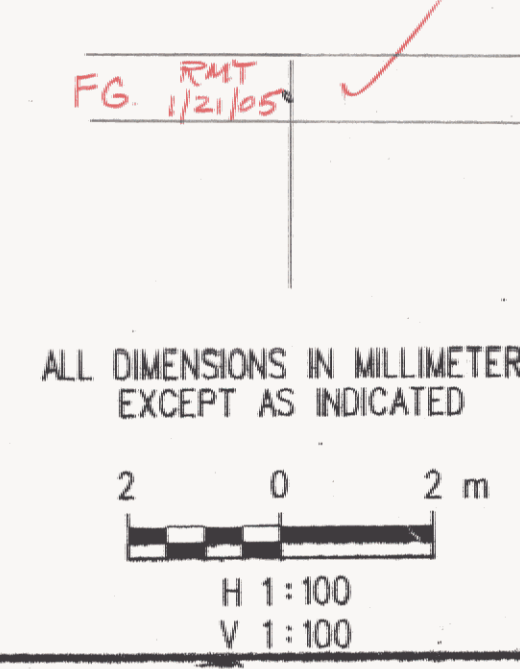

SURVEYED BY	C.H.A. & V.S.E.	DATE	
DRAWN BY	J.S.L.	DATE	
SQUAD LEADER	T.P.K.		
DESIGN FILE NO.	N/A		
IPARM FILE		DATE PLOTTED	
PROJ. NAME	BENNINGTON - HOOSICK		
	D.P.I. 0146(1) C/3		
PROJ. NO.	P.I.N. 1306.60.201	REV.	01/03
SHEET	359 OF 473 SHEETS	RMT	1/21/05