



C=4 14.50  
F=19 0  
R=0 27.35SM

SEE REVISED SHEET # 360,  
DATED 01/03 (ATTACHED)  
RMT 1/27/05

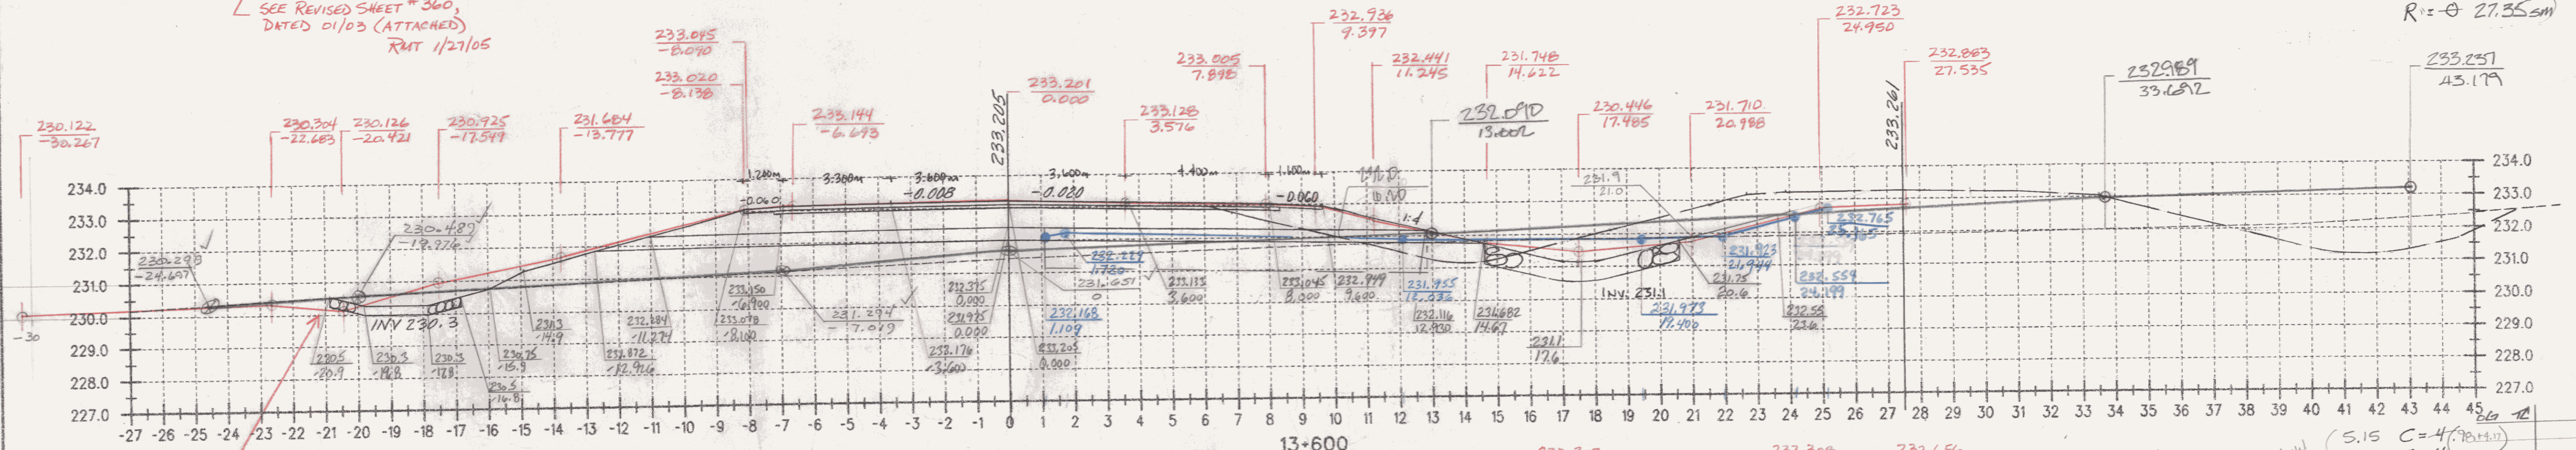

5.15 C=4.70SM  
F=16 9.79  
R=0 2.57SM

SEE REVISED SHEET # 360  
DATED 01/03 (ATTACHED)  
RMT 1/27/05

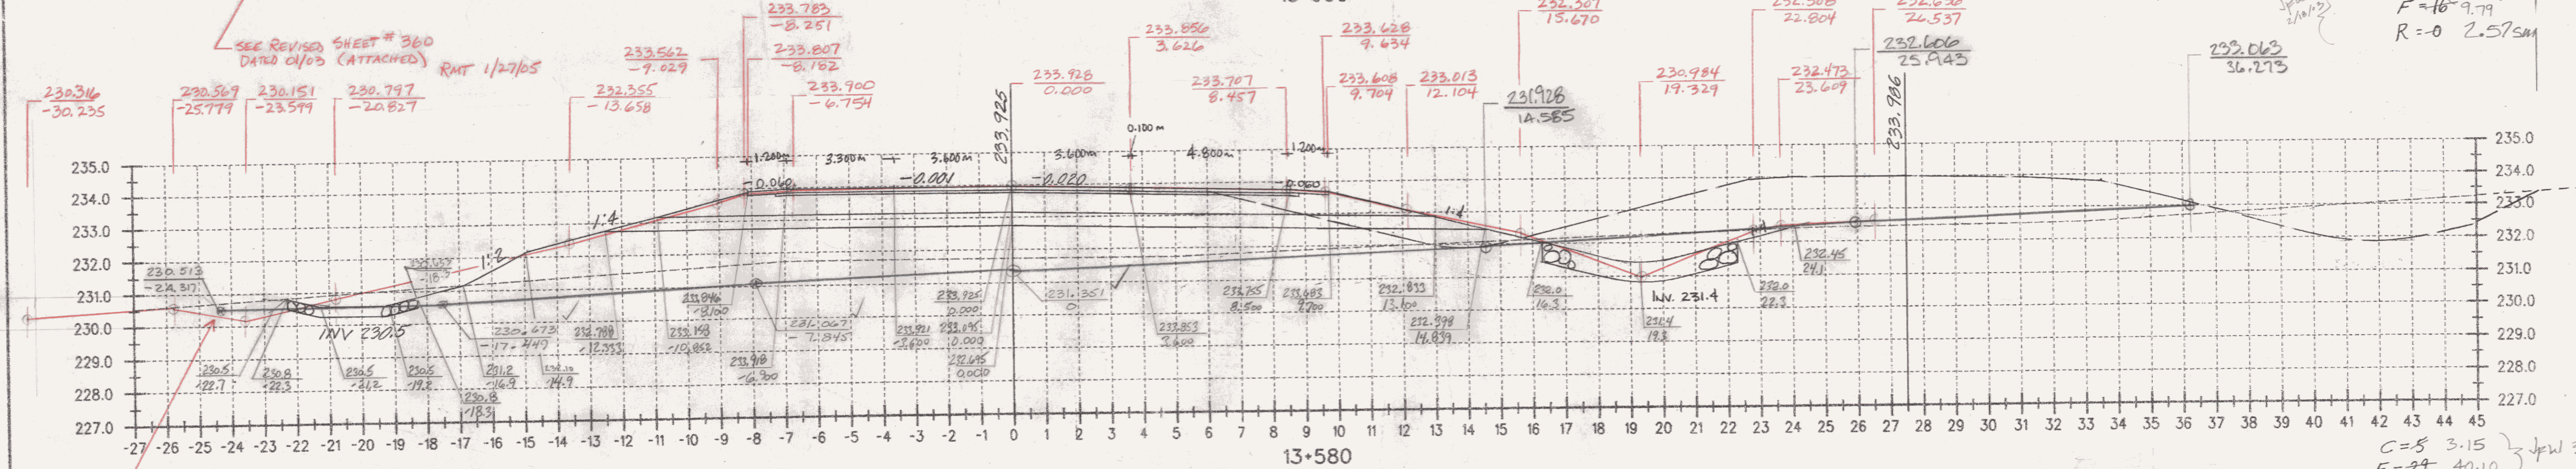


C=5 3.15  
F=27 40.10  
R=0

SEE REVISED SHEET # 360,  
DATED 01/03 (ATTACHED)  
RMT 1/26/05

Q.B.  
Rock on 1/16/02  
TEMP  
FG. RMT 1/26/05

**DATUM**

VERTICAL	NAVD 88
HORIZONTAL	NAD 83 (1992)

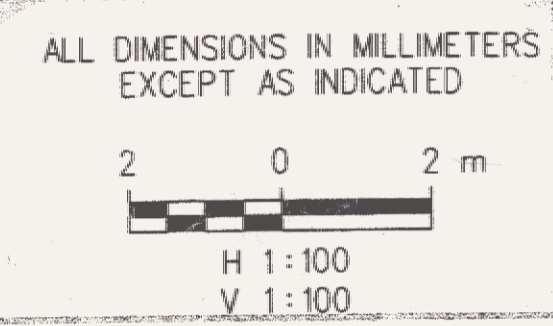

SURVEYED BY	C.H.A. & V.S.E.	DATE	
DRAWN BY	J.S.L.	DATE	
SQUAD LEADER	T.P.K.		
DESIGN FILE NO.	N/A		
IPARM FILE		DATE PLOTTED	
PROJ. NAME	BENNINGTON - HOOSICK		
	D.P.I. 0146(1) C/3		
PROJ. NO.	P.I.N. 1306.60.201		
SHEET	360 OF 473 SHEETS		

END SAND  
T.P.K. 1/11/03