


$C = 164$   
 $F = 0 \text{ } 0m^*$   
 $R = 126 \text{ } 122.23 \text{ SM}$

NOTE: SEE REVISED SHEETS # 70 & 304, DATED 01/03 (ATTACHED), FOR REVISED EARTHWORK LIMITS - LEFT, RMT 4/11/05

SAND -  $(9.25 + 11.00) \times 0.45 \text{ m} = 9.112 \text{ SM}$  FORWARD ✓  
 SAND -  $20.25 \text{ m} \times 0.075 = 1.519 \text{ SM}$  BACK ✓  
 FG -  $20.25 \text{ m}$  ✓  
 GRAVEL -  $12.72 \text{ SM}$

FG RMT 4/11/05 ✓

DATUM	
VERTICAL	NAVD 88
HORIZONTAL	NAD 83 (1992)

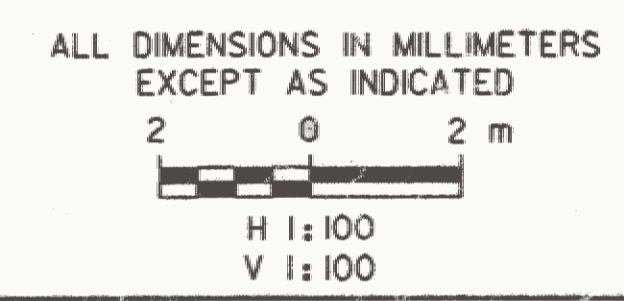

SURVEYED BY	C.H.A. & V.S.E.	DATE	12/93
DRAWN BY	J.S.L.	DATE	7/01
SQUAD LEADER	T.P.K.		
DESIGN FILE NO.	/5116/VAOT/VTSECT4.D		
IPARM FILE		DATE PLOTTED	
PROJ. NAME	BENNINGTON - HOOSICK D.P.L. 0146(1) C/3		
PROJ. NO.	P.I.N. 1306.60		
SHEET	364 OF 473 SHEETS		