


SEE REVISED SHEET # 365,
DATED 01/03 (ATTACHED)
RMT 1/31/05

$$C = 6 \text{ 8.91M}^2$$

$$F = 48 \text{ 25.36M}^2$$

$$R = 0 \text{ 25.32 SM}$$

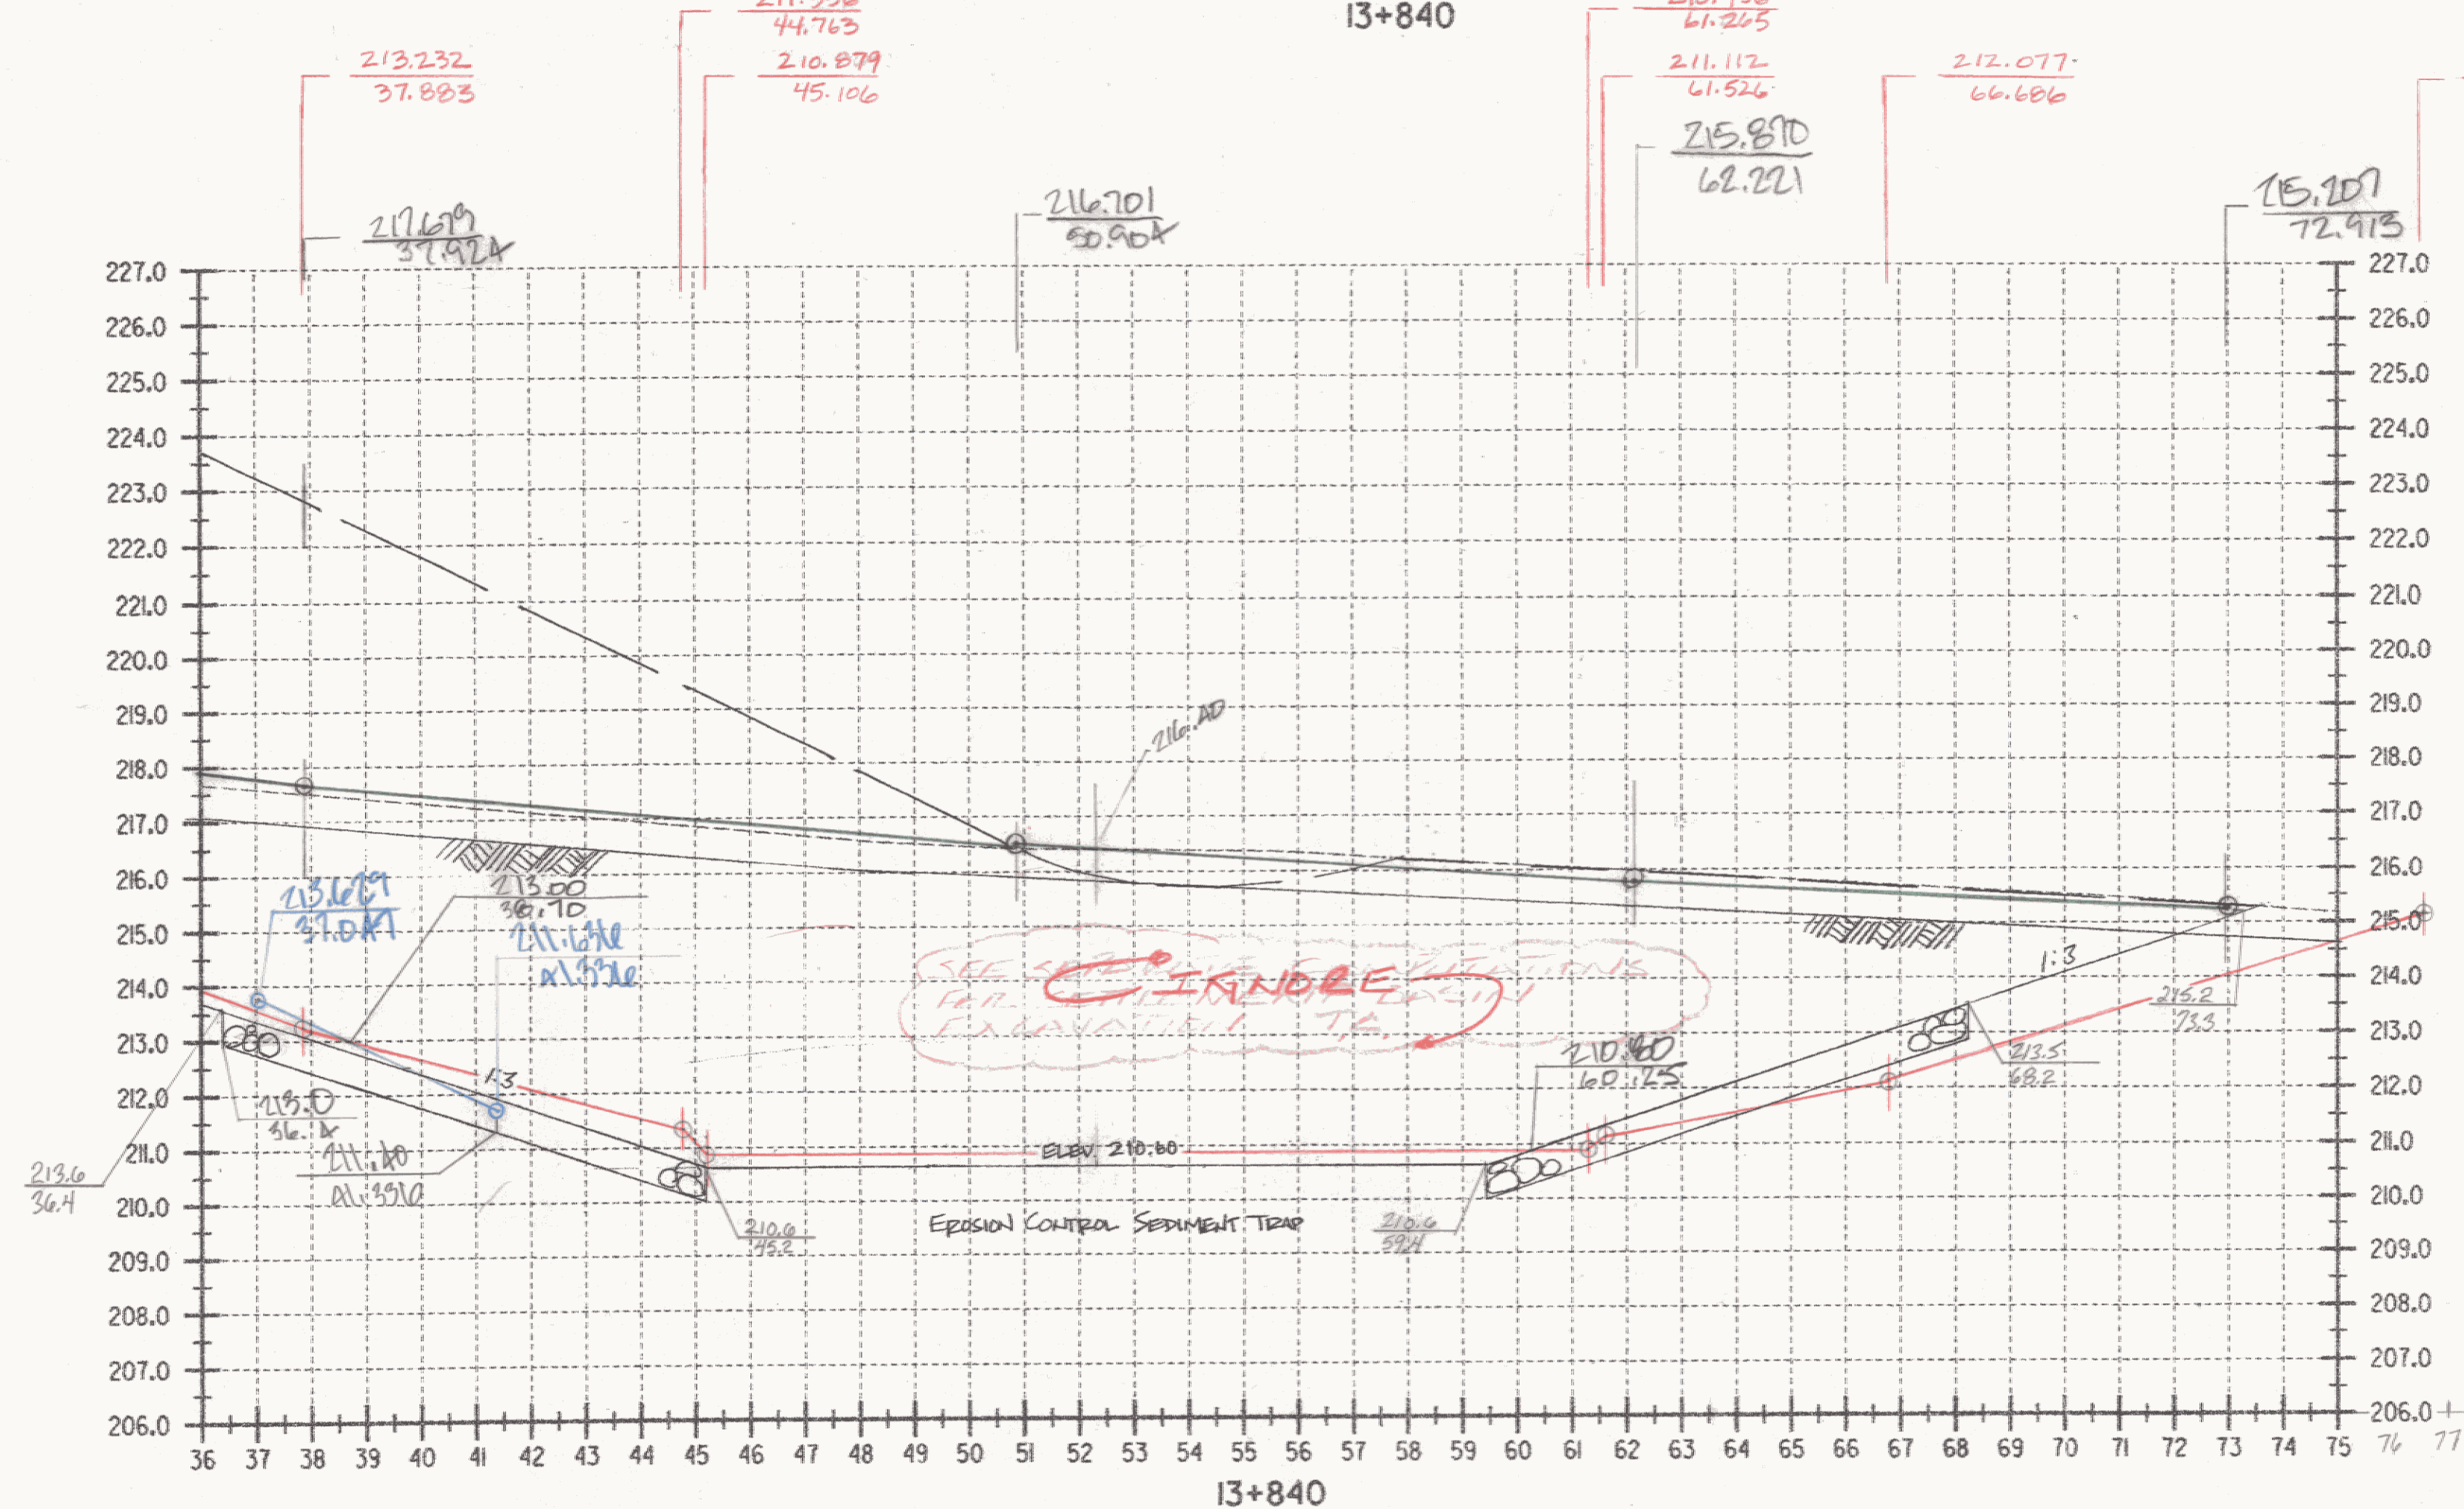

FG RMT 1/4/05

DATUM	
VERTICAL	NAVD 88
HORIZONTAL	NAD 83 (1992)

ALL DIMENSIONS IN MILLIMETERS
EXCEPT AS INDICATED

2 0 2 m

H 1:100
V 1:100

SURVEYED BY	C.H.A. & V.S.E.	DATE	12/93
DRAWN BY	J.S.L.	DATE	6/98
SQUAD LEADER	T.P.K.		
DESIGN FILE NO.	/516/VAOT/VTSECT3.D		
IPARM FILE		DATE PLOTTED	
PROJ. NAME	BENNINGTON - HOOSICK		
	D.P.I. 0146(I) C/3		
PROJ. NO.	P.I.N. 1306.60		
SHEET	365 OF 473 SHEETS		