


C = 6  
F = 48  
R = 0

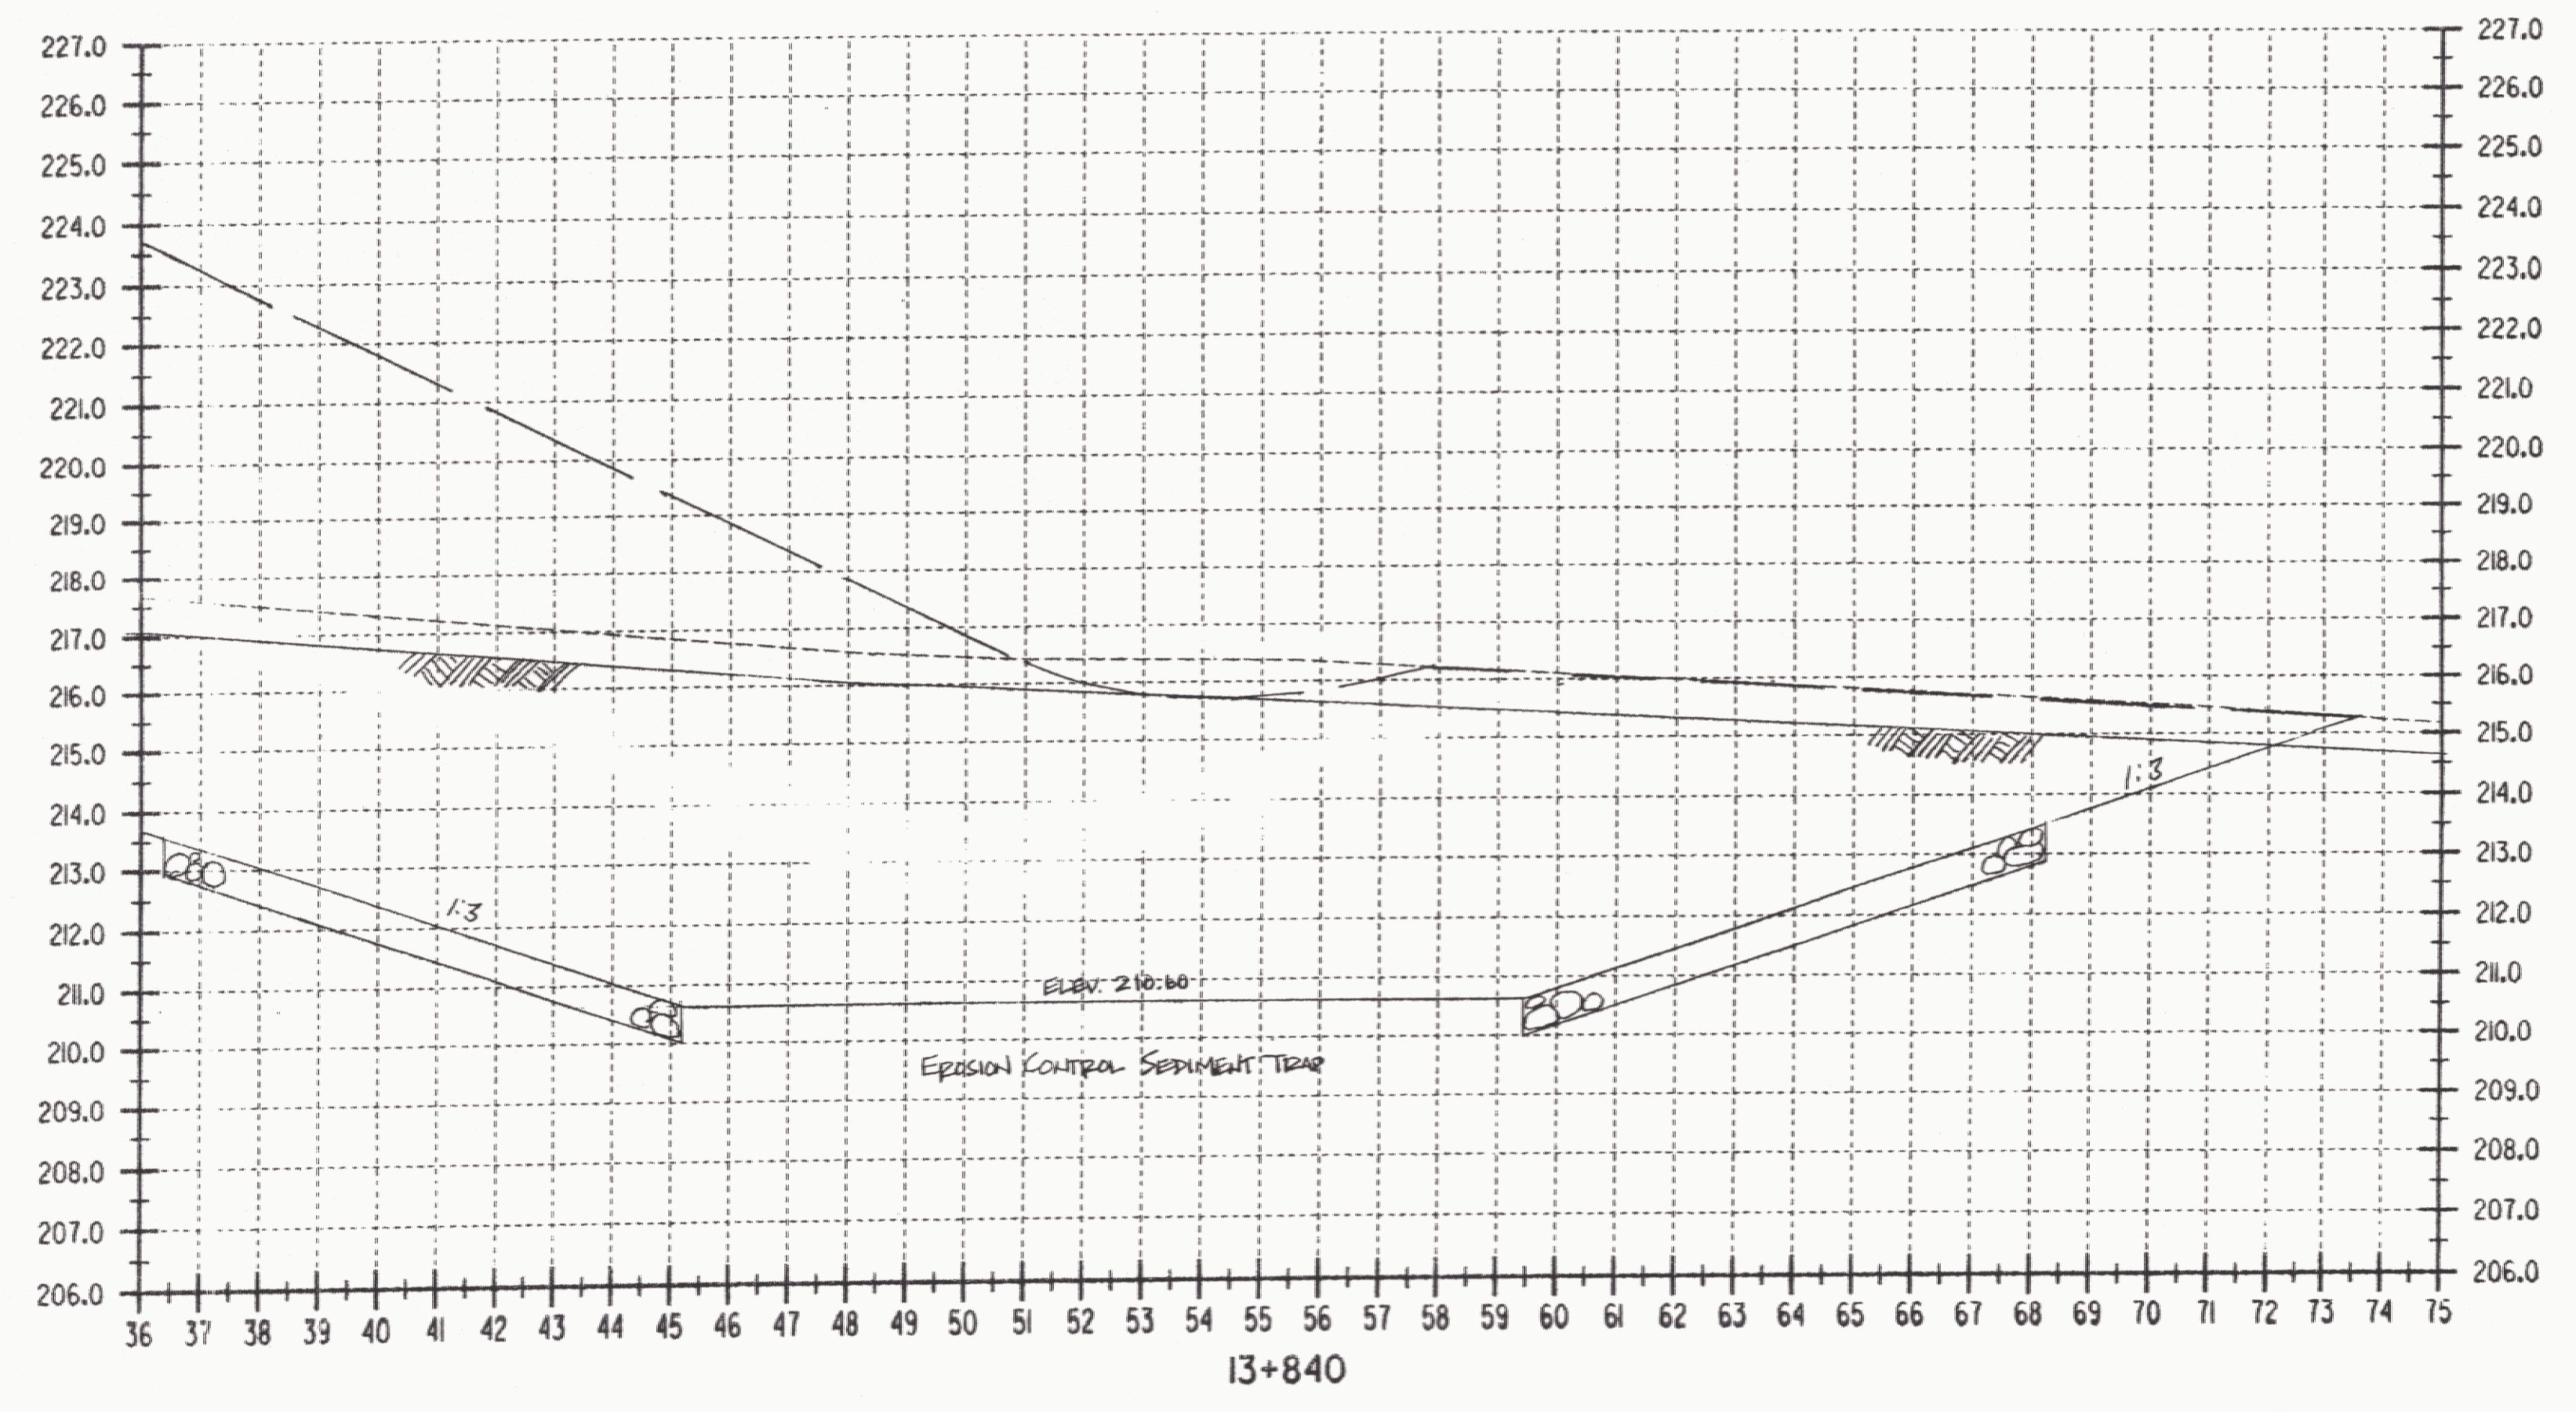

FG. RMT 1/31/05 ✓

DATUM	
VERTICAL	NAVD 88
HORIZONTAL	NAD 83 (1992)

ALL DIMENSIONS IN MILLIMETERS EXCEPT AS INDICATED  
  
 H 1:100  
 V 1:100

SURVEYED BY	C.H.A. & V.S.E.	DATE	12/93
DRAWN BY	J.S.L.	DATE	6/98
SQUAD LEADER	T.P.K.		
DESIGN FILE NO.	/5116/VAOT/VTSECT3.D		
IPARM FILE		DATE PLOTTED	
PROJ. NAME	BENNINGTON - HOOSICK D.P.I. 0146(II) C/3		
PROJ. NO.	P.I.N. 1306.60	REV.	01/03
SHEET	365 OF 473 SHEETS	RMT	1/31/05