


SEE REVISED SHEET # 346,  
DATED 01/03 (ATTACHED)  
RMT 1/31/05

C = 11  
F = 141 / 26.18 m<sup>2</sup> vs 152 (141)  
R = 0 4.235 m

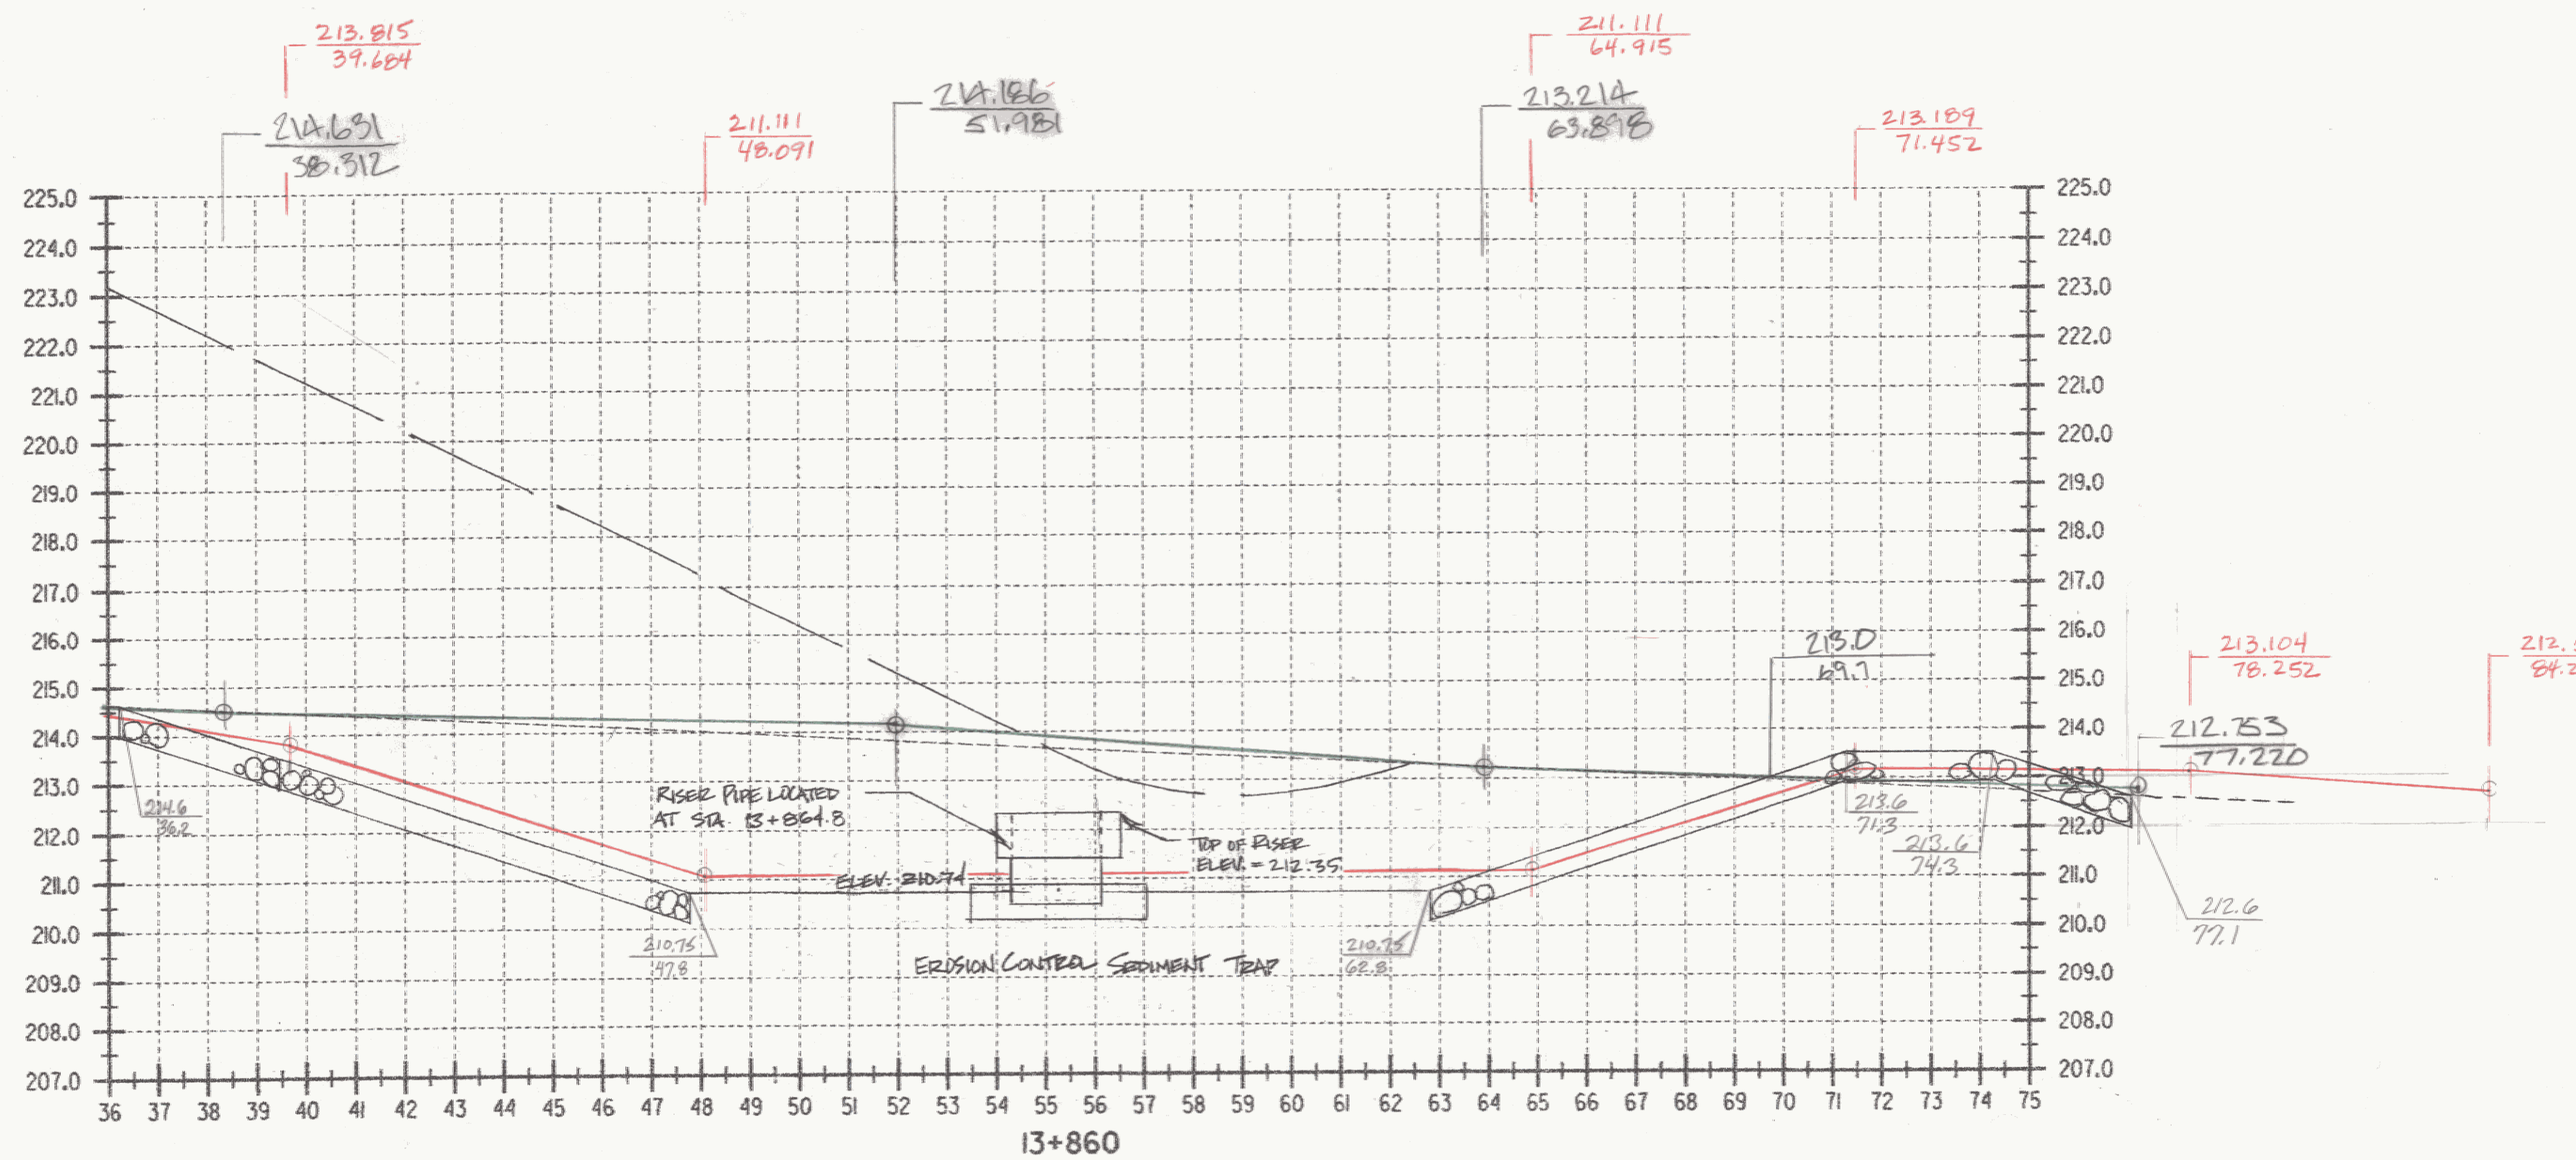

RMT 1/28/05 ✓  
FG. 128/05

DATUM	
VERTICAL	NAVD 88
HORIZONTAL	NAD 83 (1992)

ALL DIMENSIONS IN MILLIMETERS  
EXCEPT AS INDICATED  
2 0 2 m  
H 1:100  
V 1:100

SURVEYED BY	C.H.A. & V.S.E.	DATE	12/93
DRAWN BY	J.S.L.	DATE	6/98
SQUAD LEADER	T.P.K.		
DESIGN FILE NO.	/5116/VAOT/VTSECT3.D		
IPARM FILE		DATE PLOTTED	
PROJ. NAME	BENNINGTON - HOOSICK D.P.I. 0146(1) C/3		
PROJ. NO.	P.I.N. 1306.60		
SHEET	346 OF 473 SHEETS		

SAND & BASE TEMP CHECKED BY RL 1/15/04