


BEGIN REVISED DITCH LOCATION
PER REVISED PLAN SHEET # 79,
DATED 01/03 (ATTACHED) RMT 1/31/05

C = 7
F = 141
R = 0

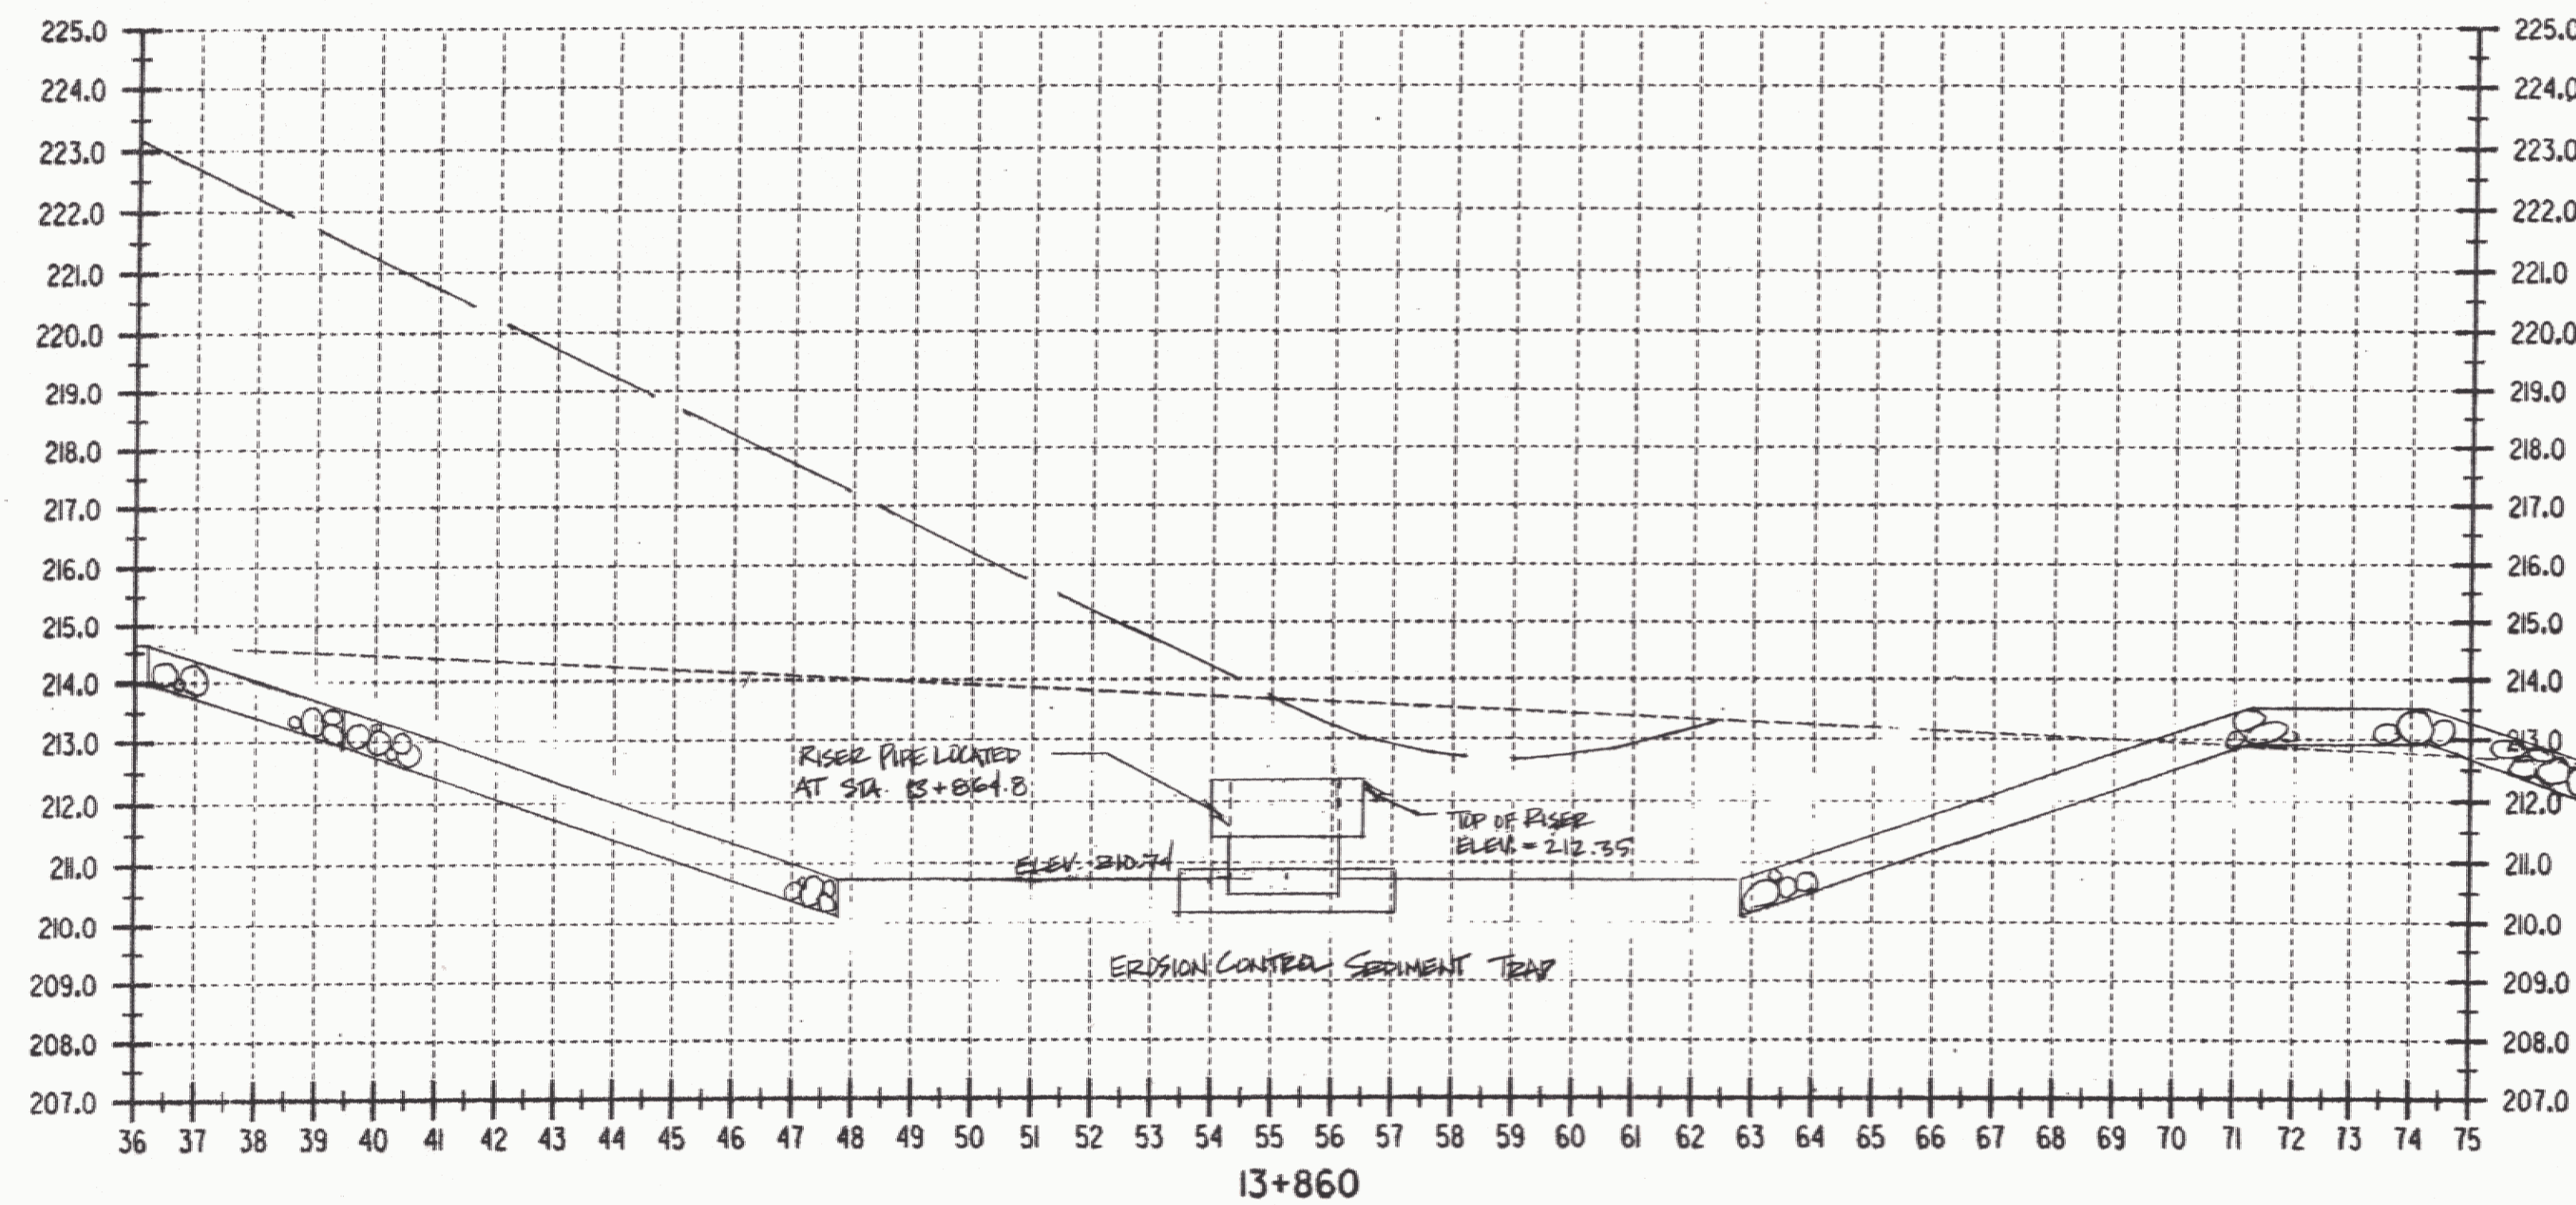

FG. RMT 1/31/05 ✓ 1/31/05

DATUM
VERTICAL NAVD 88
HORIZONTAL NAD 83 (1992)

ALL DIMENSIONS IN MILLIMETERS
EXCEPT AS INDICATED
2 0 2 m
H 1:100
V 1:100

SURVEYED BY C.H.A. & V.S.E. DATE 12/93
DRAWN BY J.S.L. DATE 6/98
SQUAD LEADER T.P.K.
DESIGN FILE NO. /5116/VAOT/VTSECT3.D
IPARM FILE DATE PLOTTED
PROJ. NAME BENNINGTON - HOOSICK
D.P.I. 0146(II) C/3
PROJ. NO. P.I.N. 1306.60
SHEET 366 OF 473 SHEETS
REV. 01/03
RMT 1/31/05