


END REVISED DITCH LOCATION
PER REVISED PLAN SHEET #79,
DATED 01/03 (ATTACHED)
RMT 1/31/05

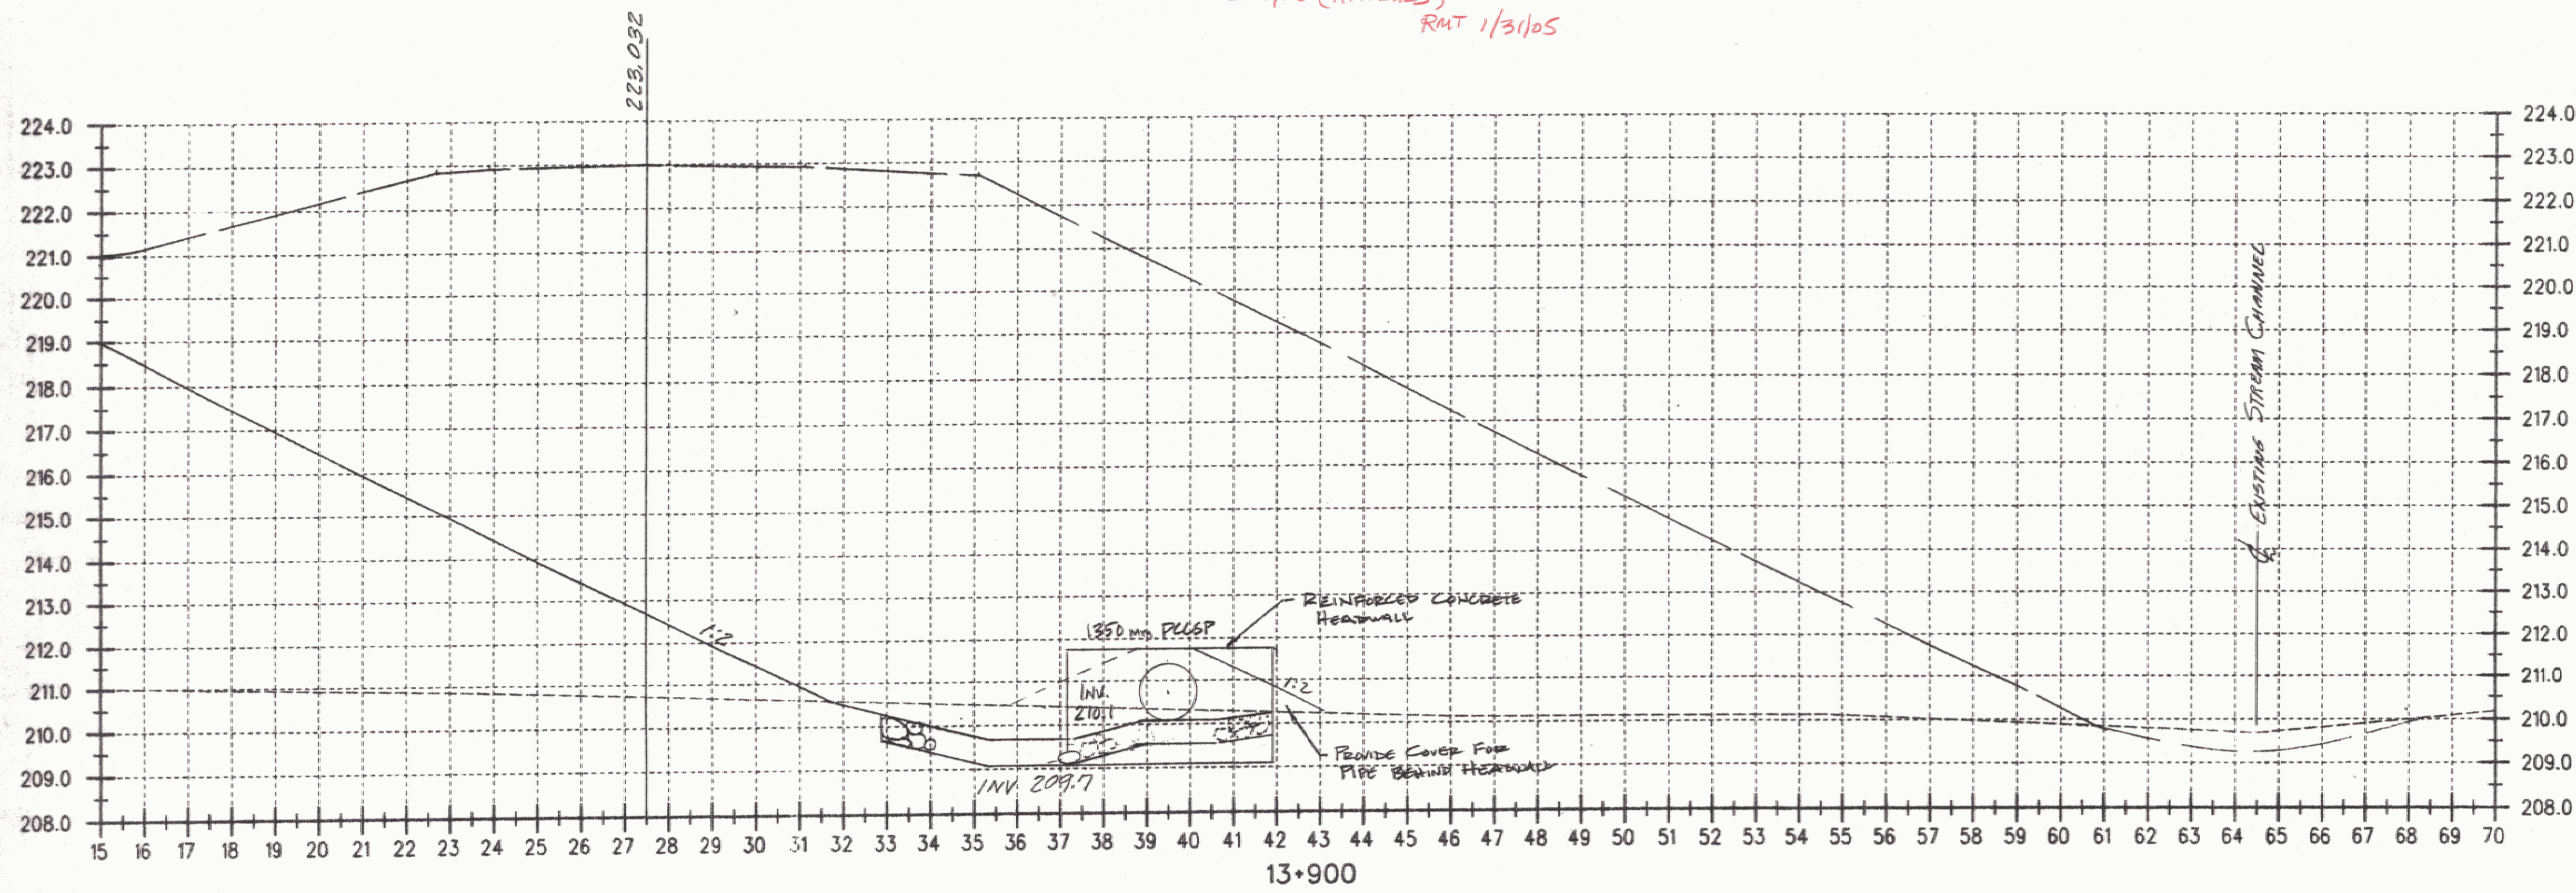

FG. RMT 1/31/05 ✓

C = 6
F = 368
R = 0

DATUM
VERTICAL NAVD 88
HORIZONTAL NAD 83 (1992)

ALL DIMENSIONS IN MILLIMETERS
EXCEPT AS INDICATED
2 0 2 m
H 1:100
V 1:100

SURVEYED BY C.H.A. & V.S.E. DATE _____
DRAWN BY J.S.L. DATE _____
SQUAD LEADER T.P.K. _____
DESIGN FILE NO. N/A _____
IPARM FILE _____ DATE PLOTTED _____
PROJ. NAME BENNINGTON - HOOSICK
D.P.I. 0146(1) c/3
PROJ. NO. P.I.N. 1306.60.201 REV. 01/03
SHEET 368 OF 473 SHEETS RMT 1/31/05