


DATUM
 VERTICAL NAVD 88
 HORIZONTAL NAD 83 (1992)

FG RMT 2/2/05

O.G. DRAWN BY: DH 1/15/03

Checked By:

ALL DIMENSIONS IN MILLIMETERS EXCEPT AS INDICATED

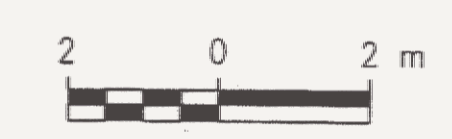

H 1:100
 V 1:100

SURVEYED BY	C.H.A. & V.S.E.	DATE	
DRAWN BY	J.S.L.	DATE	
SQUAD LEADER	T.P.K.		
DESIGN FILE NO.	N/A		
PARM FILE		DATE PLOTTED	
PROJ. NAME	BENNINGTON - HOOSICK		
	D.P.I. 0146(1) C/3		
PROJ. NO.	P.I.N. 1306.60.201		
SHEET	376	OF 477 SHEETS	

C=0
 F=669 657.33
 R=0
 JFW 2/19/03

SAND/SUBBASE TEMP CHECKED BY R/L 1/15/04