


SEE REVISED SHEET # 377, DATED 01/03-A (ATTACHED) RMT 2/2/05

FG. RMT 2/2/05 ✓ Jpw 2/2/05

O.G. Drawn By: JH 1/15/03  
 Checked By: RRM  
 C=0'  
 f=549 578.08 Jpw 2/19/03  
 R=0'  
 SLOTT SUBBASE TEMP CHECKED BY: BL 1/15/04

DATUM

VERTICAL	NAVD 88
HORIZONTAL	NAD 83 (1992)

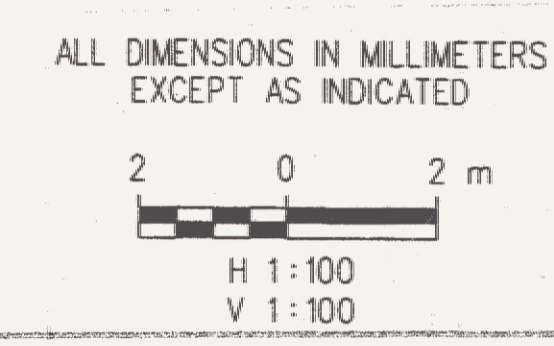

SURVEYED BY	C.H.A. & V.S.E.	DATE	
DRAWN BY	J.S.L.	DATE	
SQUAD LEADER	T.P.K.		
DESIGN FILE NO.	N/A		
IPARM FILE		DATE PLOTTED	
PROJ. NAME	BENNINGTON - HOOSICK		
PROJ. NO.	D.P.I. 0146(1) C/3		
SHEET	377 OF 473 SHEETS		