

FG. RMT 2/3/05 ✓


C = 0
F = 488 467.29 m²
R = 0

O.G. Drawn by
DH 1/15/03
Checked by: ✓

SEE REVISED SHEET #378,
DATED 01/03-A (ATTACHED)
RMT 2/3/05

DATUM

VERTICAL	NAVD 88
HORIZONTAL	NAD 83 (1992)

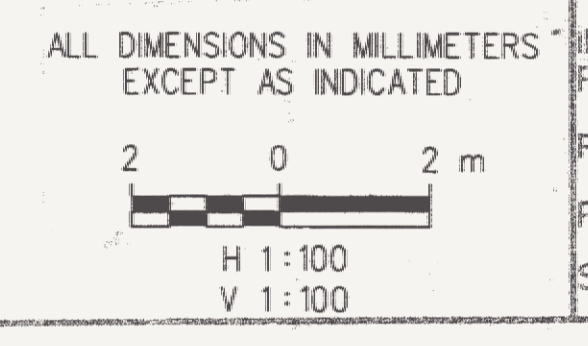

SURVEYED BY	C.H.A. & V.S.E.	DATE	
DRAWN BY	J.S.L.	DATE	
SQUAD LEADER	T.P.K.		
DESIGN FILE NO.	N/A		
FARM FILE		DATE PLOTTED	
PROJ. NAME	BENNINGTON - HOOSICK		
	D.P.I. 0146(1) C/3		
PROJ. NO.	P.I.N. 1306.60.201		
SHEET	378 OF 473 SHEETS		