


\* NO FG SURVEY DATA AVAILABLE  
RMT 2/3/05

$C = 0$   
 $F = 366 - 429.76m^2$   
 $R = 0$

D.G. Drawn By:  
DH 1/15/05

Checked By:  
BL 1/15/05

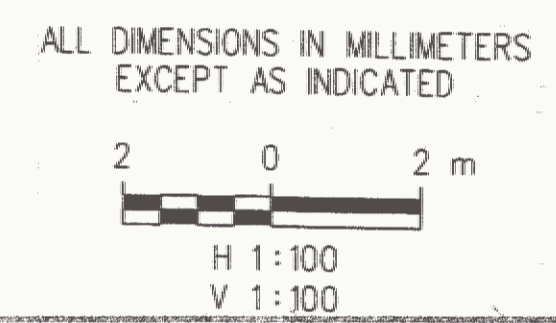

SURVEYED BY C.H.A. & V.S.E.	DATE
DRAWN BY J.S.L.	DATE
SQUAD LEADER T.P.K.	
DESIGN FILE NO. N/A	
IPARM	DATE PLOTTED
FILE	
PROJ. NAME BENNINGTON - HOOSICK	D.P.I. 0146(1) C/3
PROJ. NO. P.I.N. 1306.60.201	
SHEET 379	OF 473 SHEETS

DATUM

VERTICAL	NAVD 88
HORIZONTAL	NAD 83 (1992)

SEE REVISED SHEET #379,  
DATED 01/03 - A (ATTACHED)  
RMT 2/3/05