
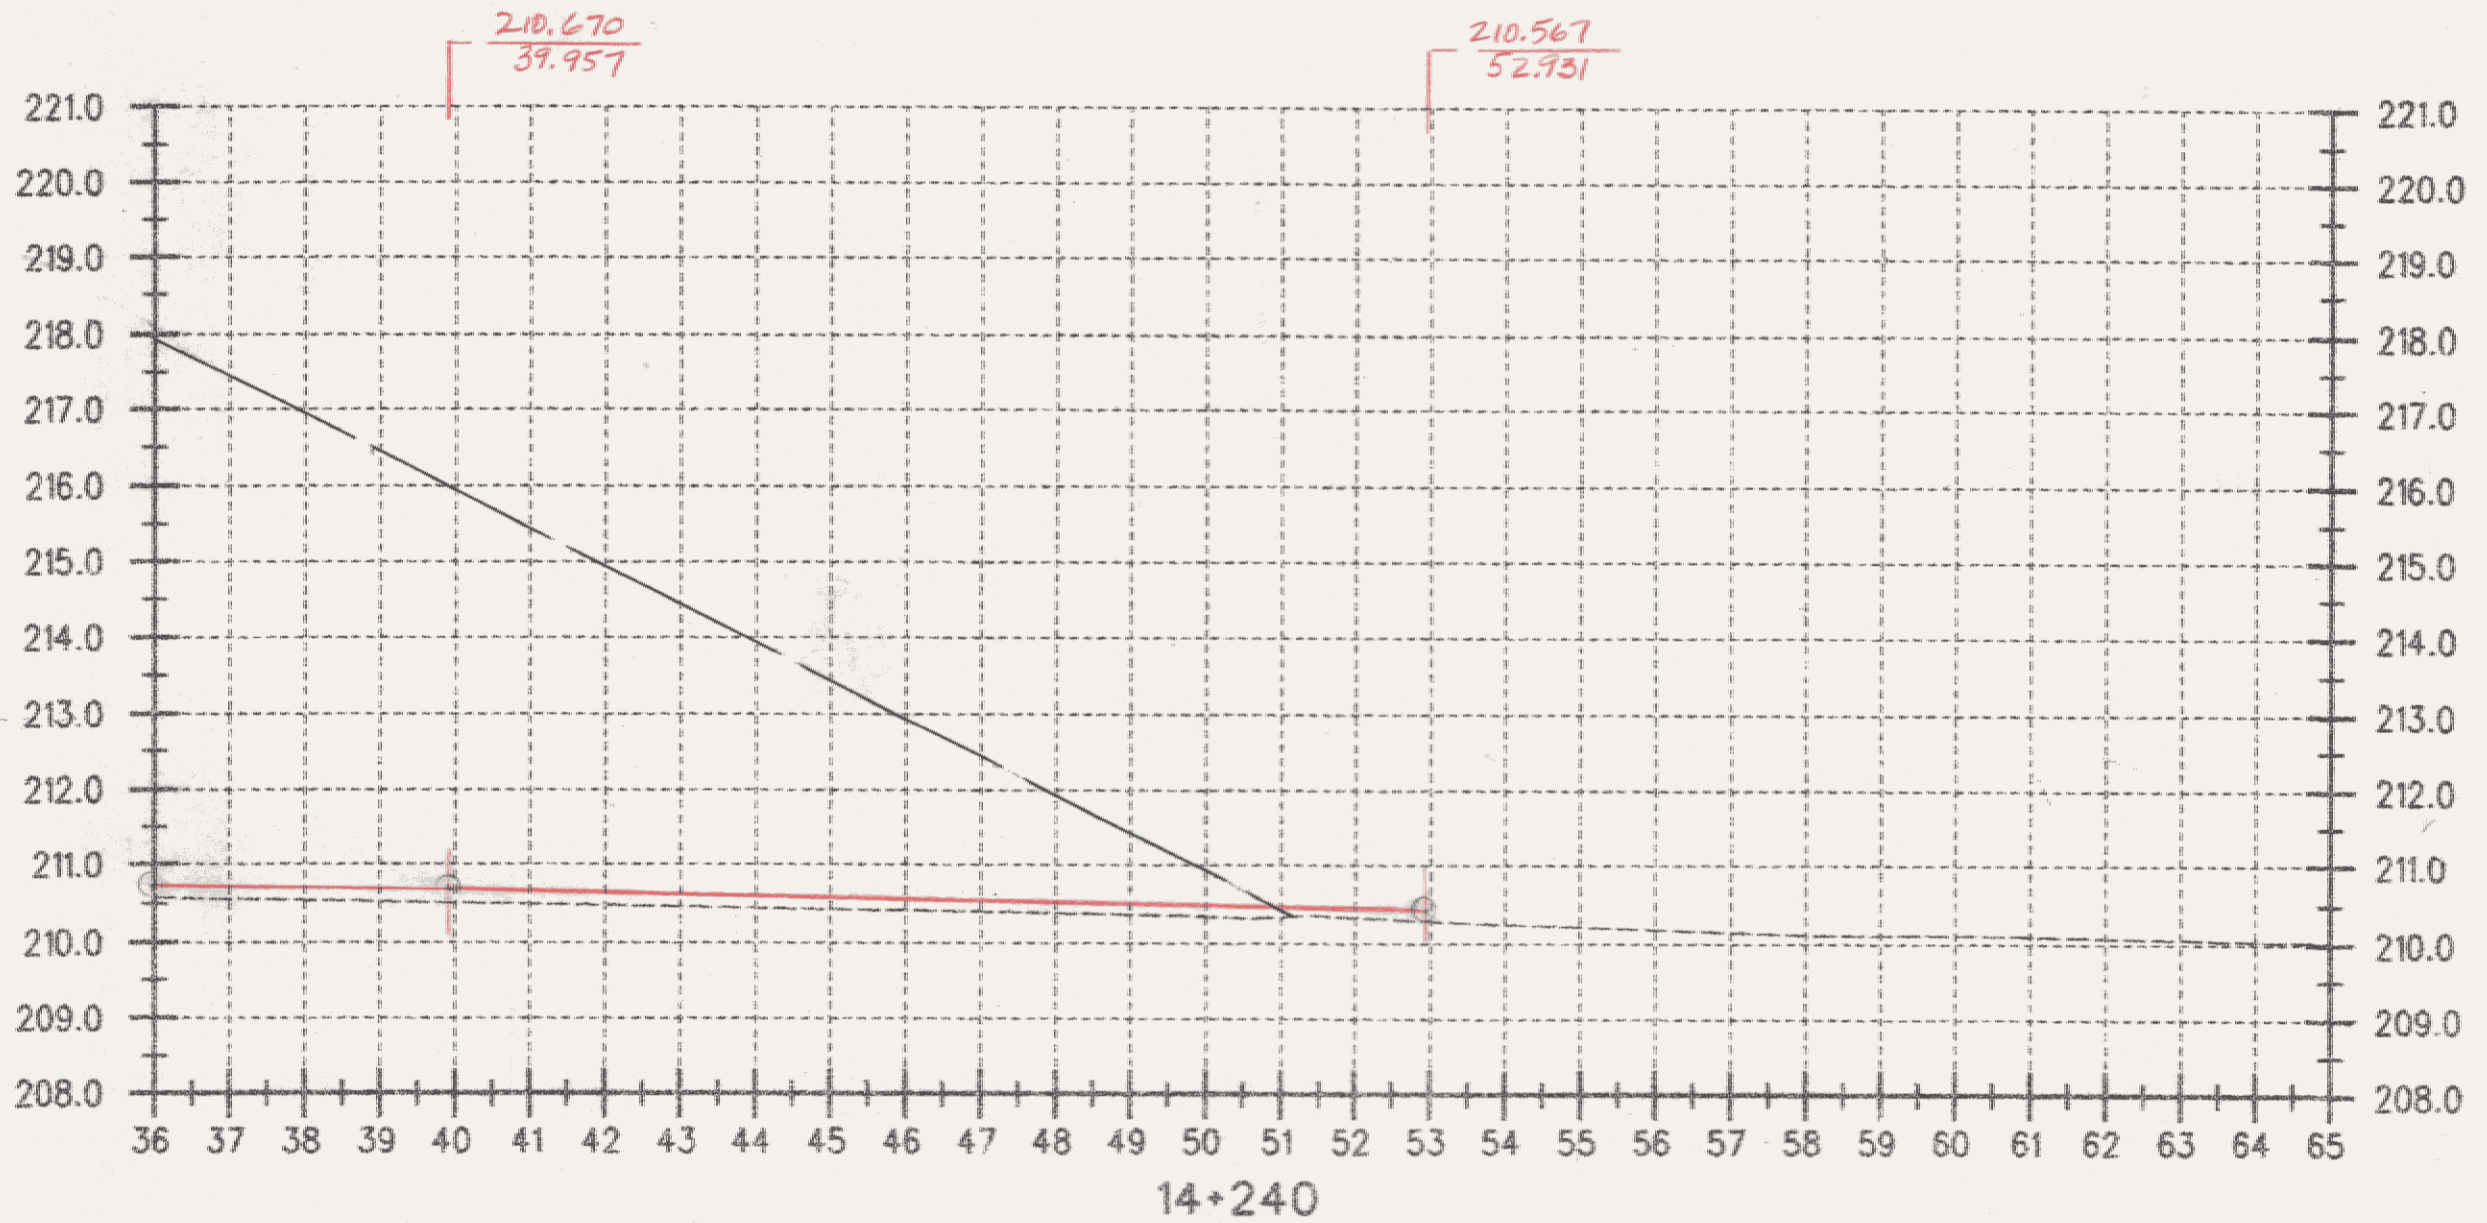


C=0 ✓
 F=120 109.94 BY RRM
 R=0 ✓
 2-10-03

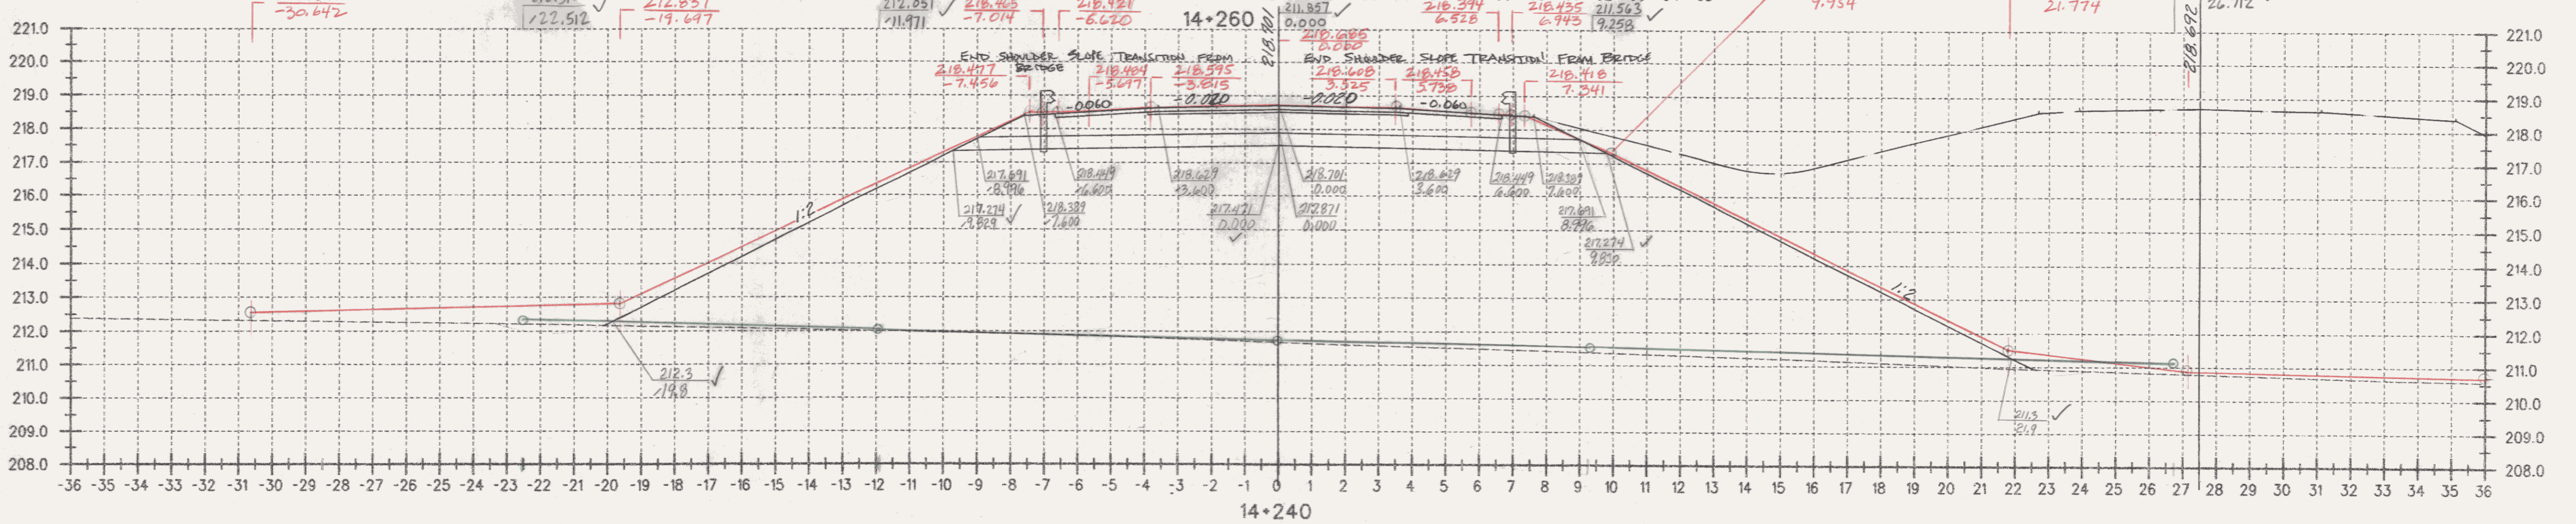

C=0 ✓
 F=176 170.06 BY RRM
 R=0 ✓
 2-10-03

DATUM
 VERTICAL NAVD 88
 HORIZONTAL NAD 83 (1992)

BOTH Sect's	BY	V BY	
O.C.	DM 1/15/03	RRM	2-12-03
TEMP ELV. +0/5	DM	RRM	2-12-03
FG.	RMT 2/1/05	JPM	2/1/05
SURVEYED BY C.H.A. & V.S.E. DATE			
DRAWN BY J.S.L. DATE			
SQUAD LEADER T.P.K.			
DESIGN FILE NO. n/a			
IPARM FILE		DATE PLOTTED	
ALL DIMENSIONS IN MILLIMETERS EXCEPT AS INDICATED			
H 1:100 V 1:100			
PROJ. NAME BENNINGTON - HOOSICK D.P.I. 0146(1) C/3			
PROJ. NO. P.I.N. 1306.60.201			
SHEET 385 OF 473 SHEETS			