
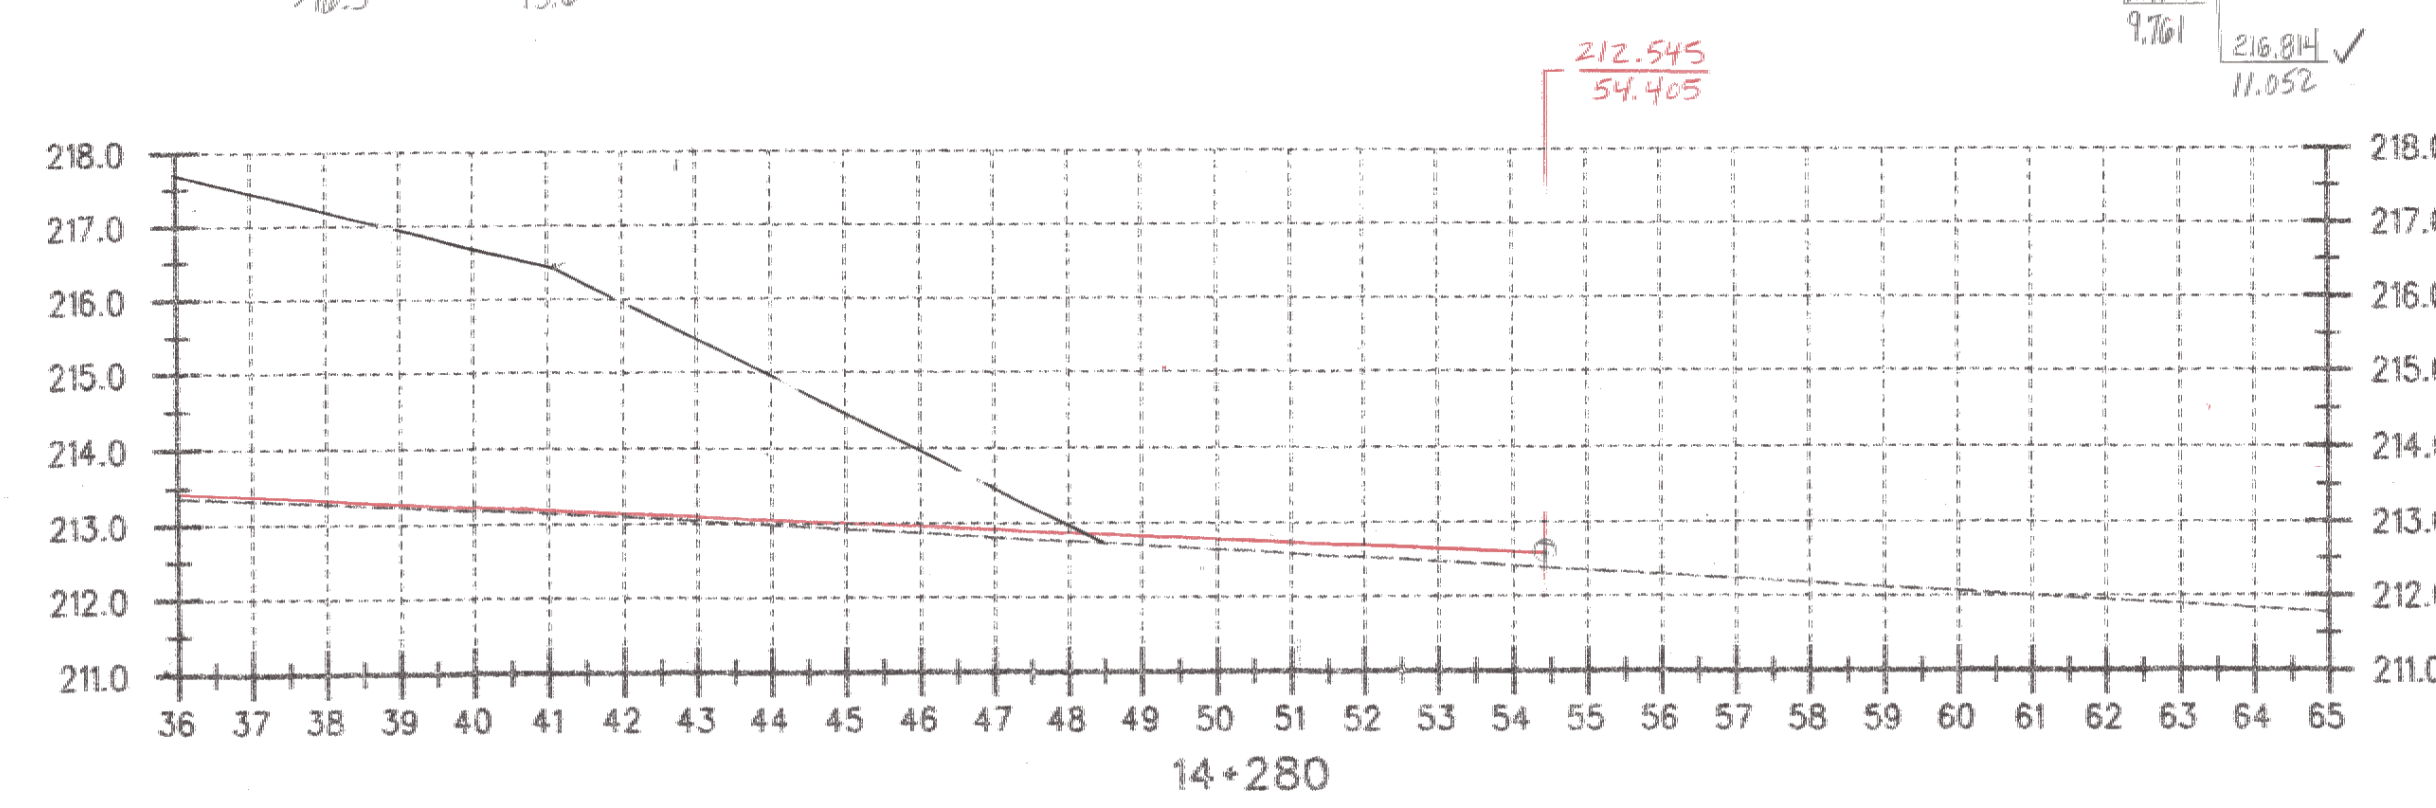


C=0
F=23 13.72 BY RRM
R=0 ✓ 2-10-03

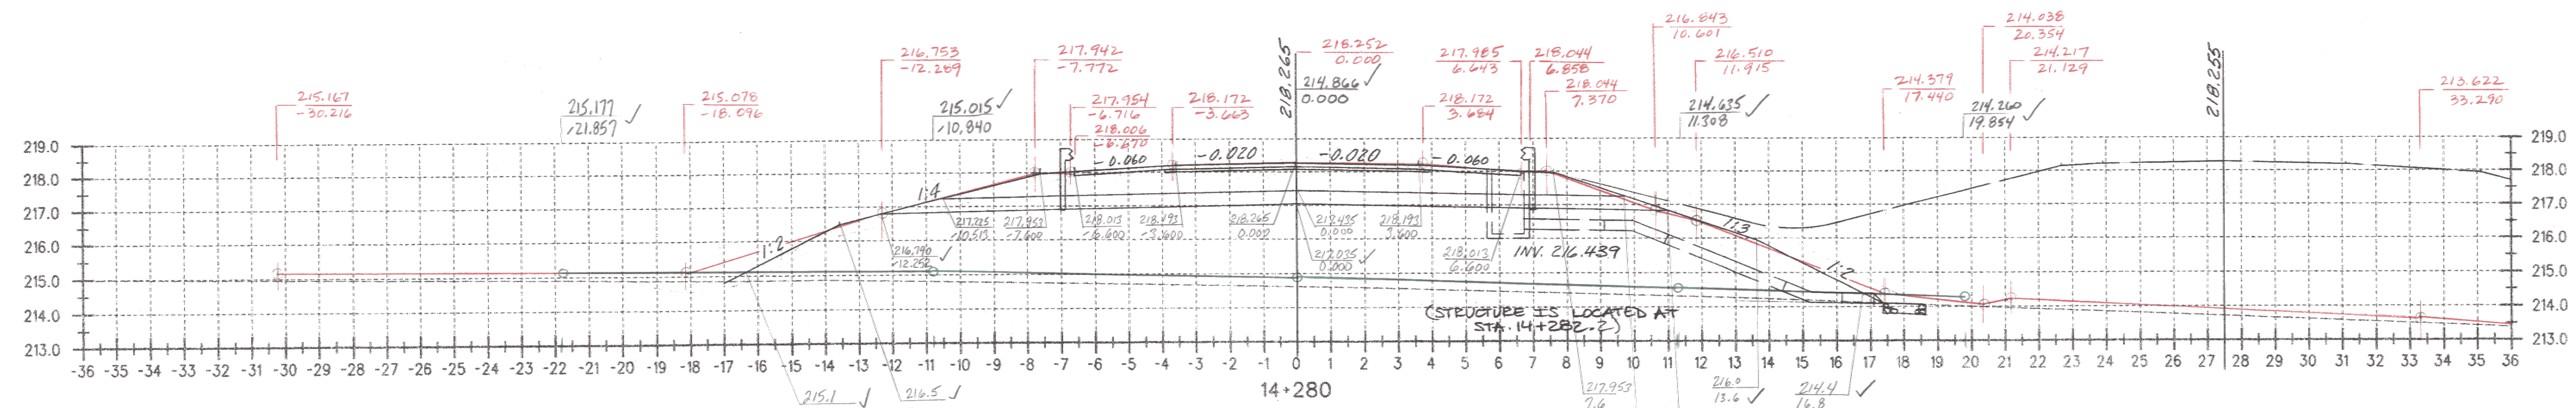

C=0
F=68 59.11 BY RRM
R=0 ✓ 2-10-03

DATUM
VERTICAL NAVD 88
HORIZONTAL NAD 83 (1992)

Both Sect's	BY	✓ BY
O.G.	DH 1/15/05	RRM 2-12-03
TEMP. ELV. ±0's	DH	RRM 2-12-03
FG	RM 2/9/05	Vpwr/1/05

ALL DIMENSIONS IN MILLIMETERS EXCEPT AS INDICATED

2 0 2 m

H 1:100
V 1:100

SURVEYED BY C.H.A. & V.S.E. DATE _____
DRAWN BY J.S.L. DATE _____
SQUAD LEADER T.P.K. _____
DESIGN FILE NO. n/a _____
IPARM FILE _____ DATE PLOTTED _____
PROJ. NAME BENNINGTON - HOOSICK
D.P.I. 0146(1) C/3
PROJ. NO. P.I.N. 1306.60.201
SHEET 386 OF 473 SHEETS