



C=+10 108.00
F=0
R=0

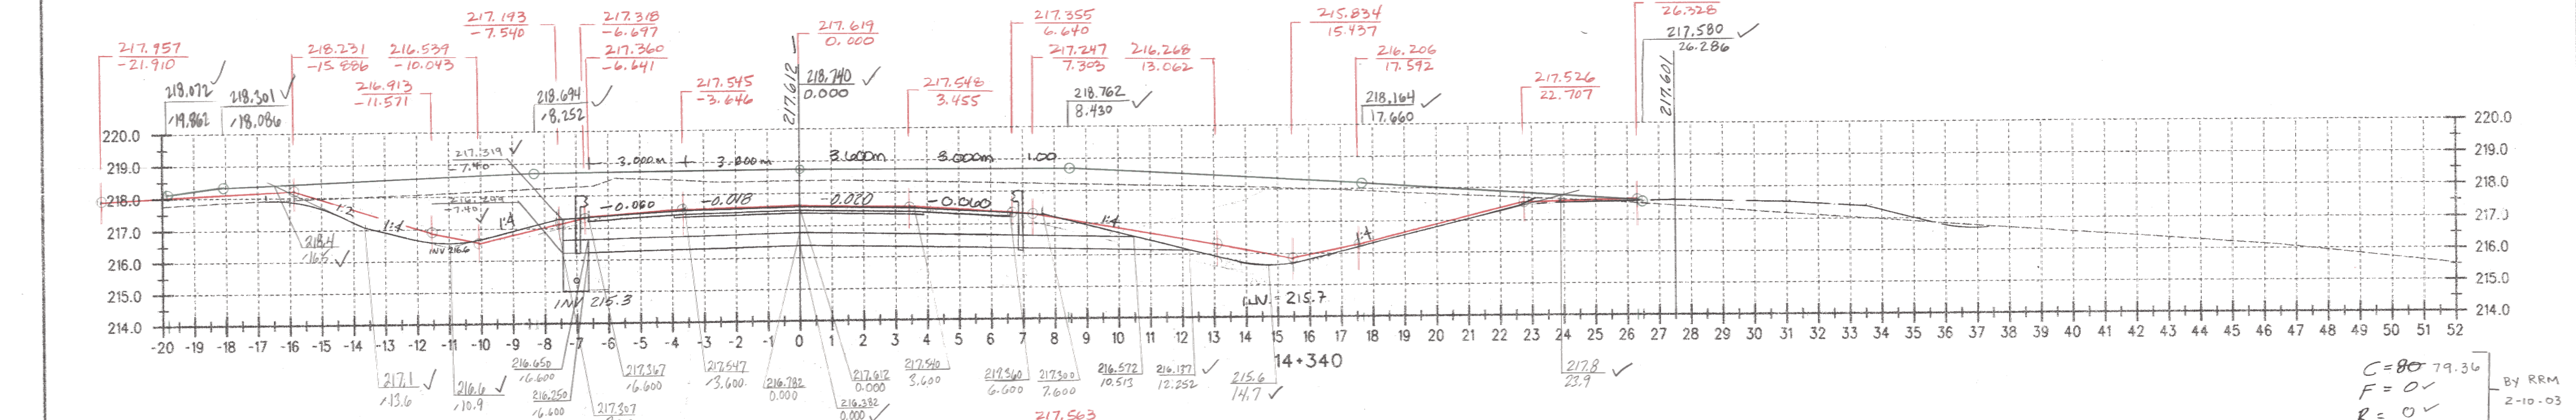

C=80 79.36
F=0
R=0

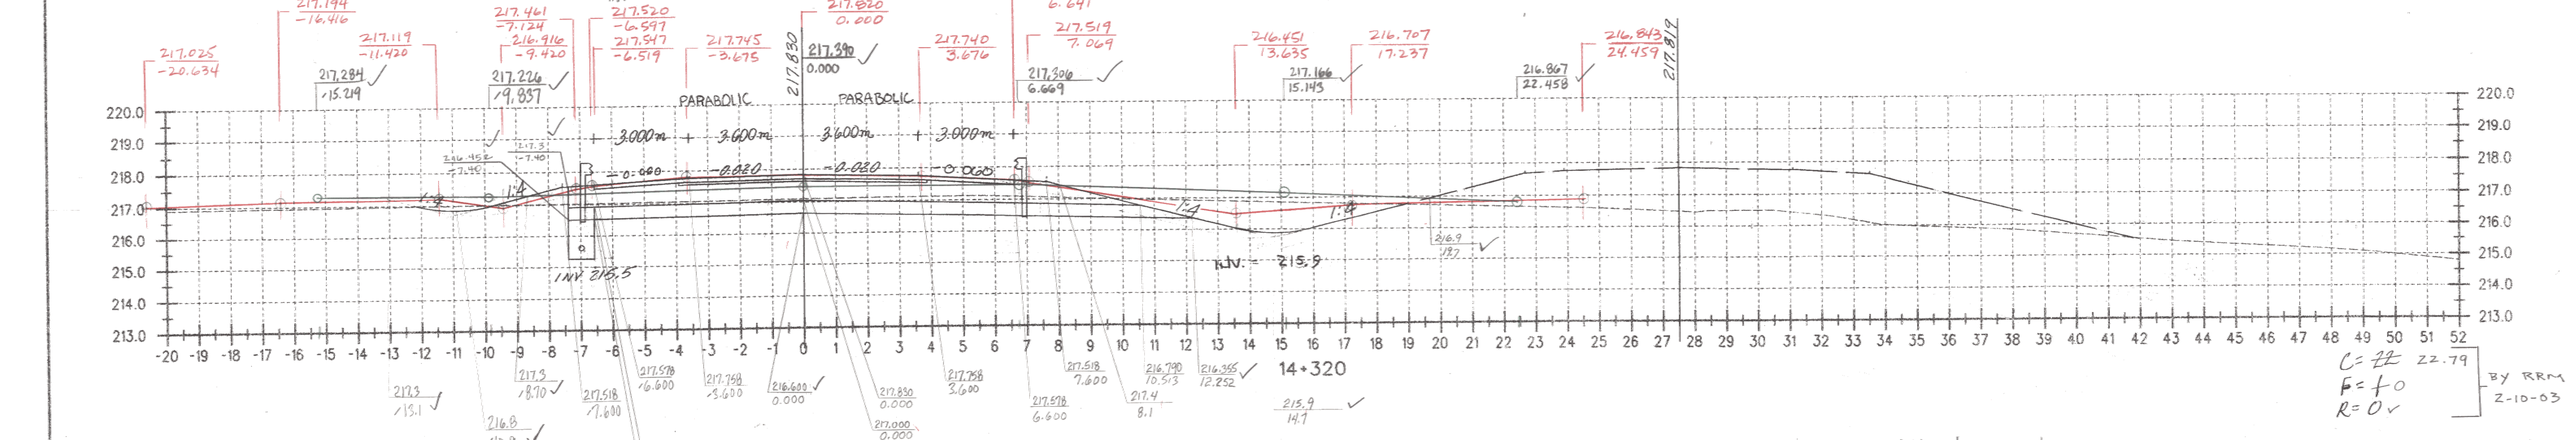


C=22 22.79
F=+0
R=0

DATUM
VERTICAL NAVD 88
HORIZONTAL NAD 83 (1992)

ALL	By	BY
SEC's		
O.G.	DH 1/15/03	RRM 2-12-03
TEMP	DH	RRM 2-12-03
ELV. ± 0/5		
F.G.	RRM 2/15/05	RRM 2/15/05

ALL DIMENSIONS IN MILLIMETERS EXCEPT AS INDICATED

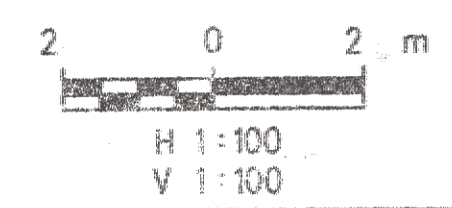

SURVEYED BY C.H.A. & V.S.E. DATE _____
DRAWN BY J.S.L. DATE _____
SQUAD LEADER T.P.K.
DESIGN FILE NO. n/a
IPARM _____ DATE PLOTTED _____
FILE _____
PROJ. NAME BENNINGTON - HOOSICK
D.P.I. 0146(1) c/3
PROJ. NO. P.I.N. 1306.60.201
SHEET 387 OF 473 SHEETS