



C=200 155.54
F=0
R=0
By RRM
2-10-03

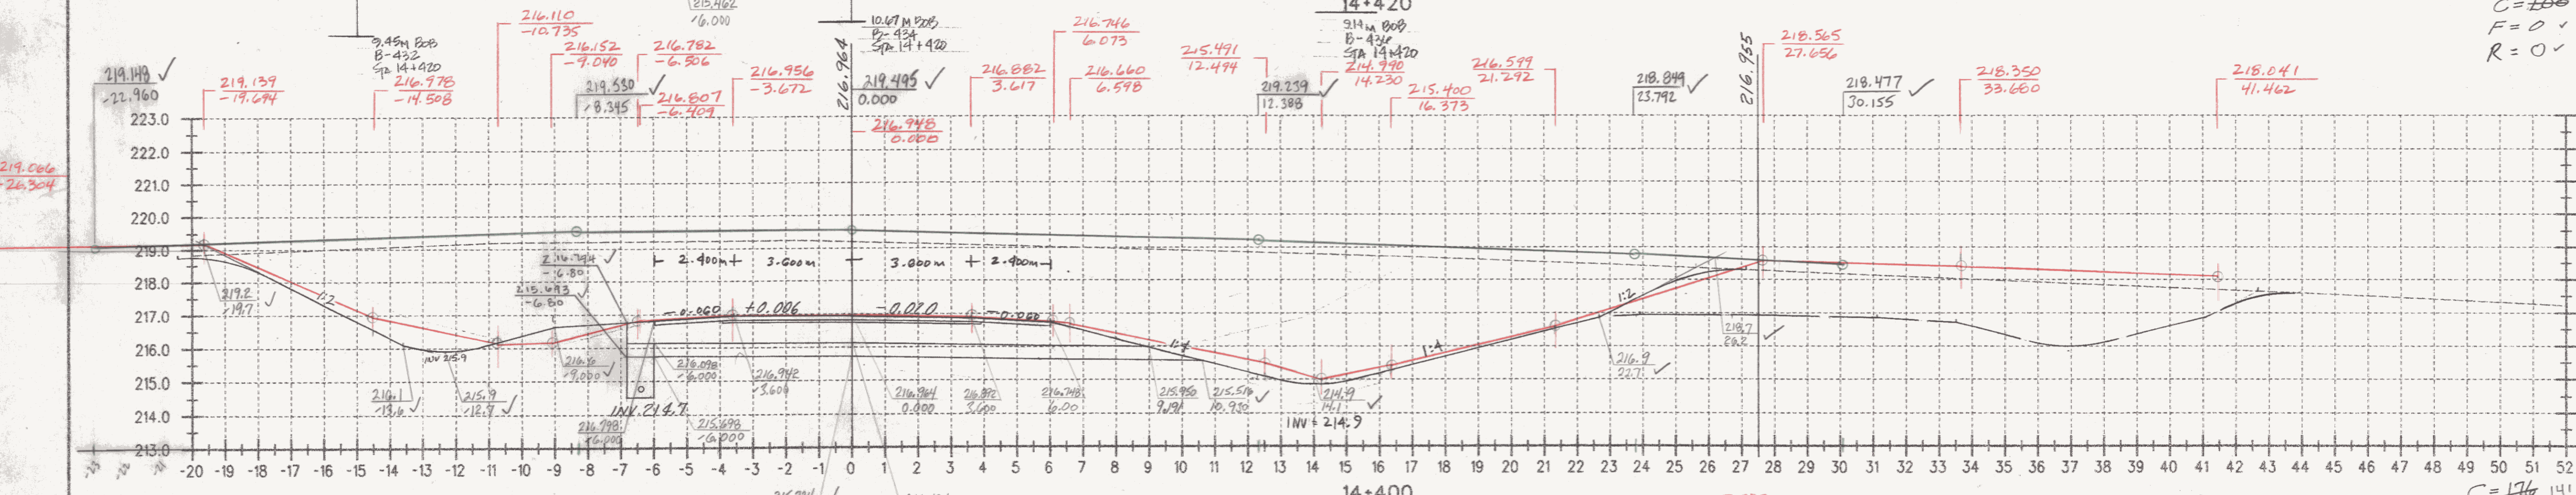

C=176 141.22
F=0
R=0
By RRM
2-10-03

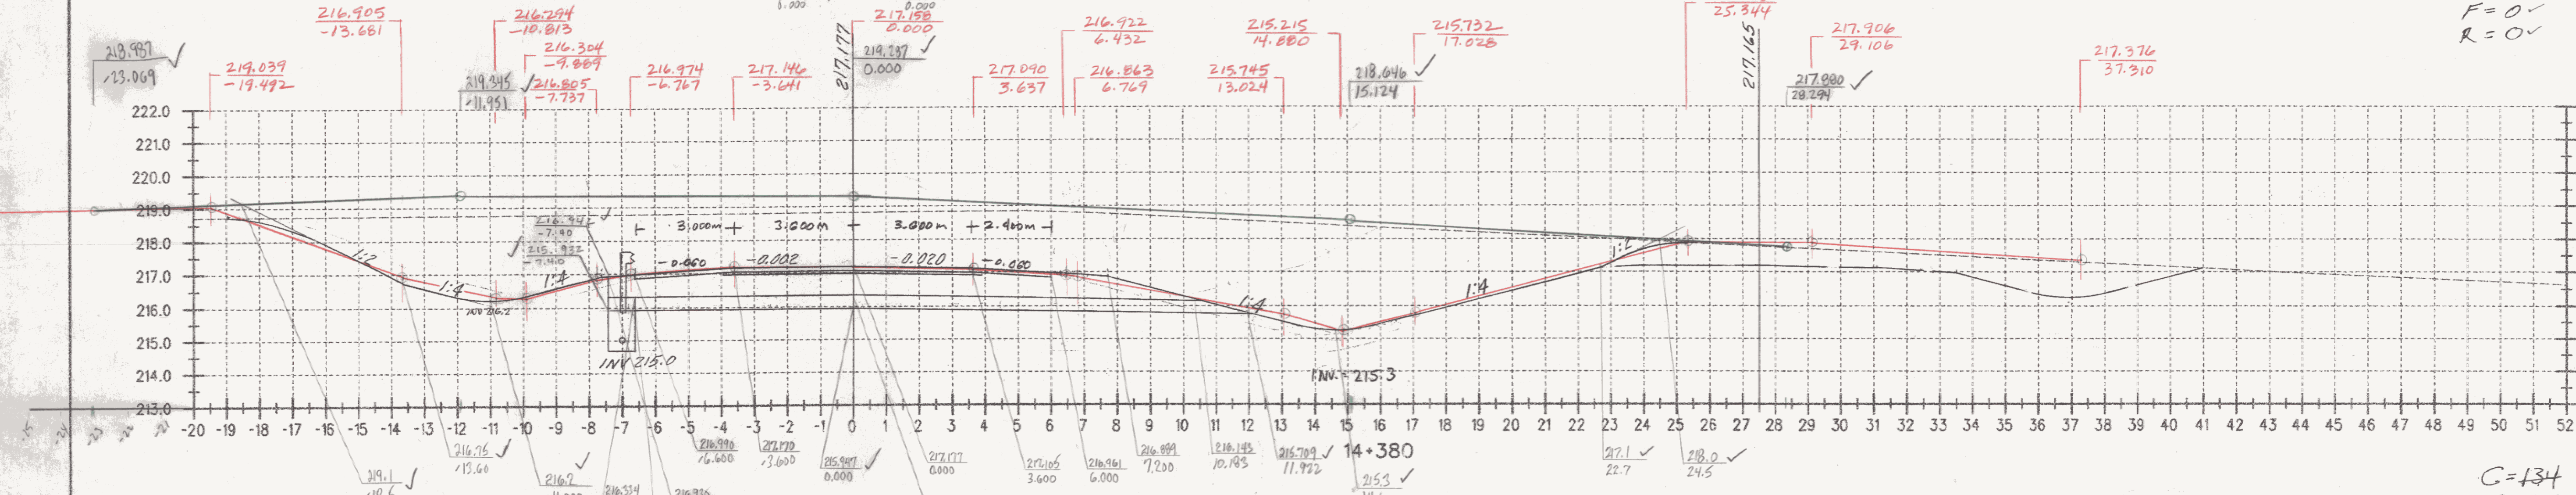


C=134 114.07
F=0
R=0
By RRM
2-10-03

DATUM

VERTICAL	NAVD 88
HORIZONTAL	NAD 83 (1992)

ALL SECT'S	By	v By
O.G.	DH 1/15/03	RRM 2-12-03
TEMP	DH	RRM 2-12-03
EW. + O/S	RRM	RRM
F.G.	Rut 2/17/05	Vp 2/17/05

ALL DIMENSIONS IN MILLIMETERS EXCEPT AS INDICATED

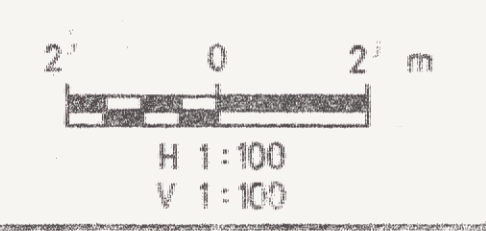

SURVEYED BY C.H.A. & V.S.E. DATE _____
DRAWN BY J.S.L. DATE _____
SQUAD LEADER T.P.K.
DESIGN FILE NO. n/a
IPARM FILE _____ DATE PLOTTED _____
PROJ. NAME BENNINGTON - HOOSICK D.P.I. 0146(1) C/3
PROJ. NO. P.I.N. 1306.60.201
SHEET 388 OF 473 SHEETS