



C=28 29.83
F=1.95
R=0 ✓

By RRM
2-10-03

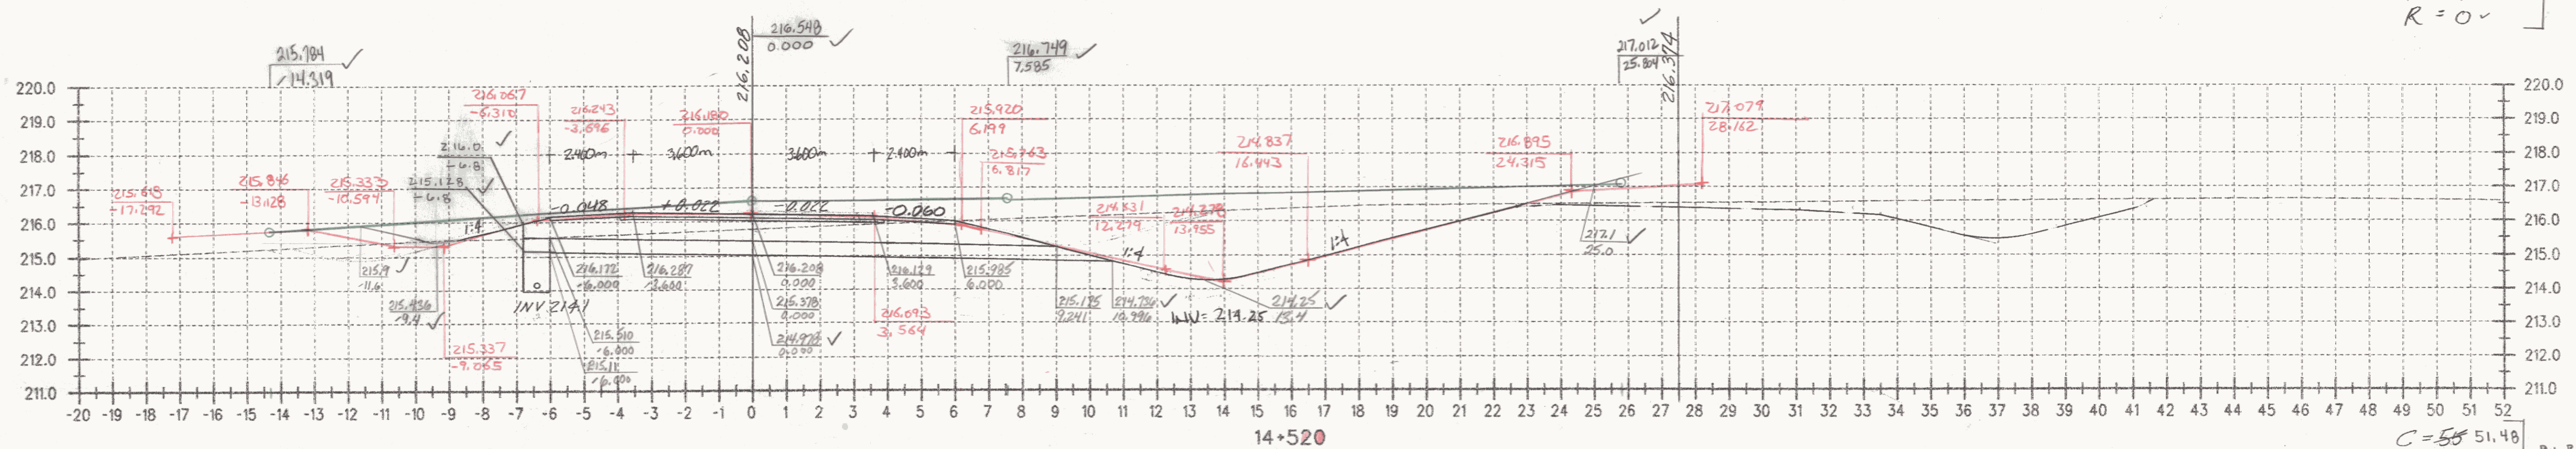

C=58 51.48
F=0
R=0 ✓

By RRM
2-10-03

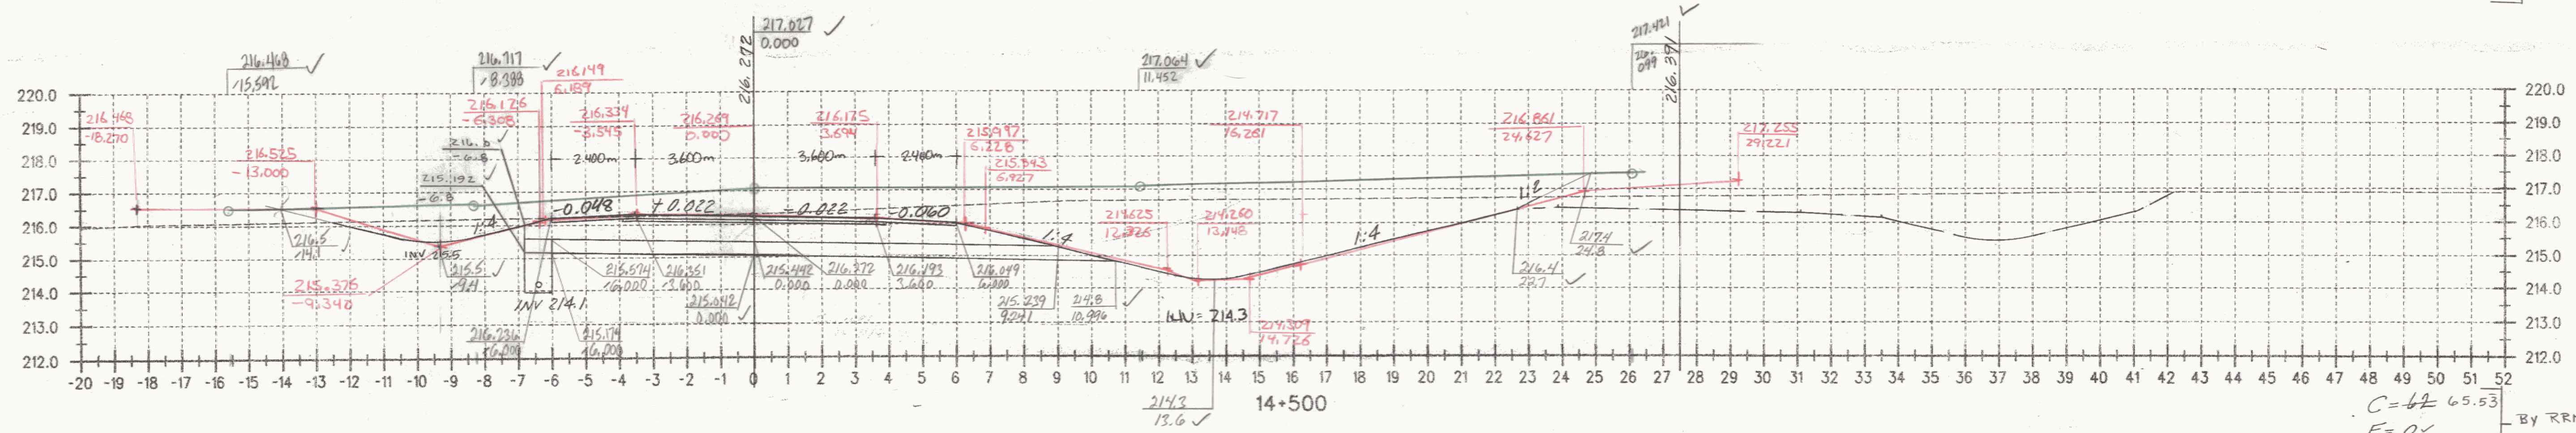

C=42 65.53
F=0
R=0 ✓

By RRM
2-10-03

DATUM
VERTICAL NAVD 88
HORIZONTAL NAD 83 (1992)

ALL SECT'S	BY	V BY
D.G.	DH	RRM
TEMP. ELV. + O/S	DH	RRM
F.G.	BL	4/8/05

ALL DIMENSIONS IN MILLIMETERS EXCEPT AS INDICATED

2 0 2 m

H 1:100
V 1:100

SURVEYED BY C.H.A. & V.S.E. DATE
DRAWN BY J.S.L. DATE
SQUAD LEADER T.P.K.
DESIGN FILE NO. n/a

IPARM FILE DATE PLOTTED

PROJ. NAME BENNINGTON - HOOSICK
D.P.I. 0146(1) C/B
PROJ. NO. P.I.N. 1306.60.201
SHEET 390 OF 473 SHEETS