
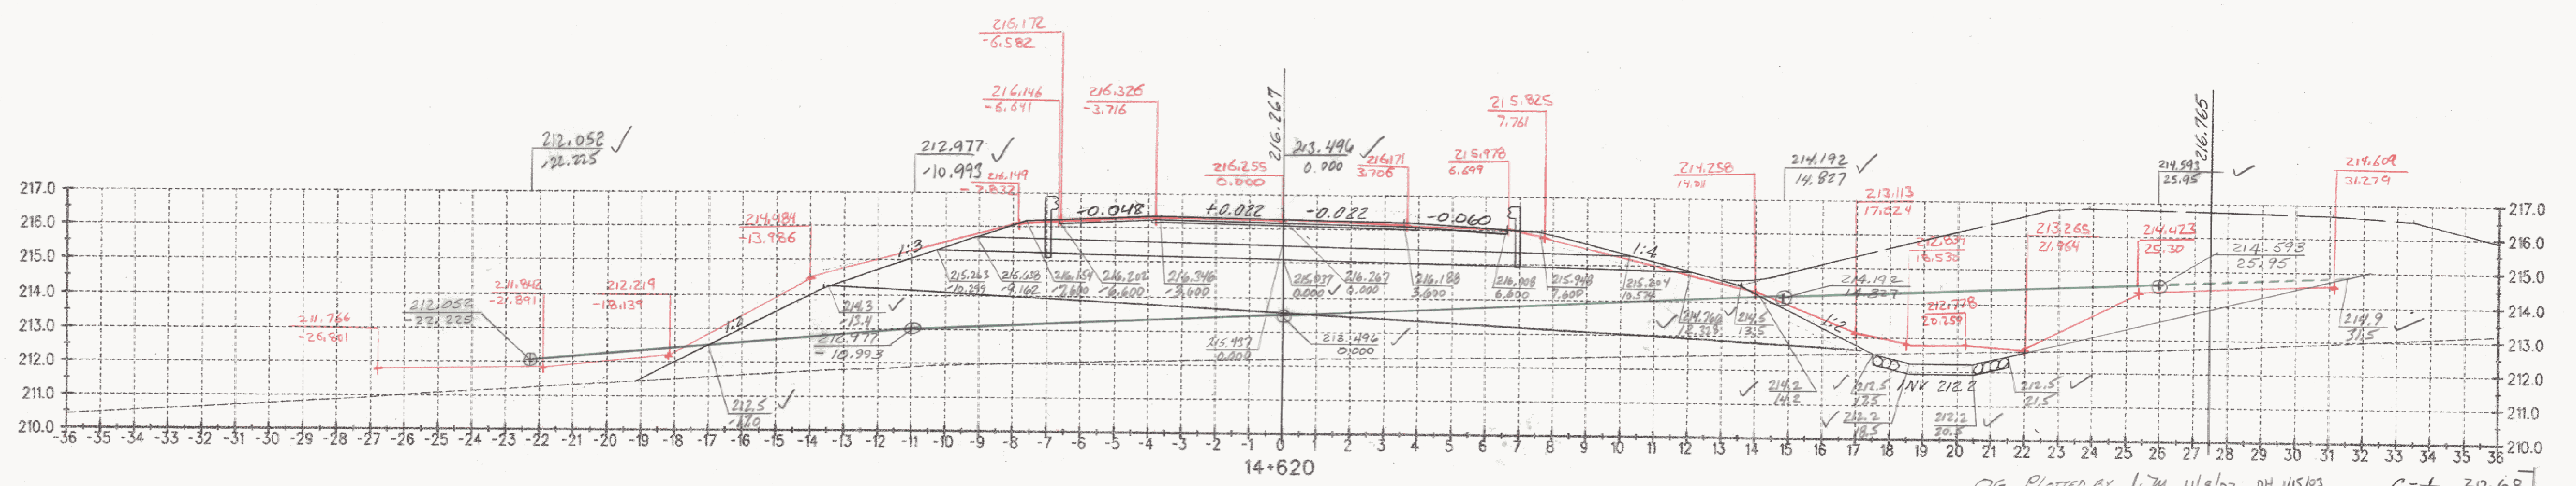


OG Plotted by JM 11/8/02, DH 11/15/03
 OG Checked by RRM Z-13-03
 TEMP ELV. + 0/s BY BB
 " v By RRM Z-13-03
 FG BL 4/11/05 ✓ Jpw 9/17/05

C = 8 11.39
 F = 130 55.72
 R = 0 ✓


BY RRM
 Z-10-03

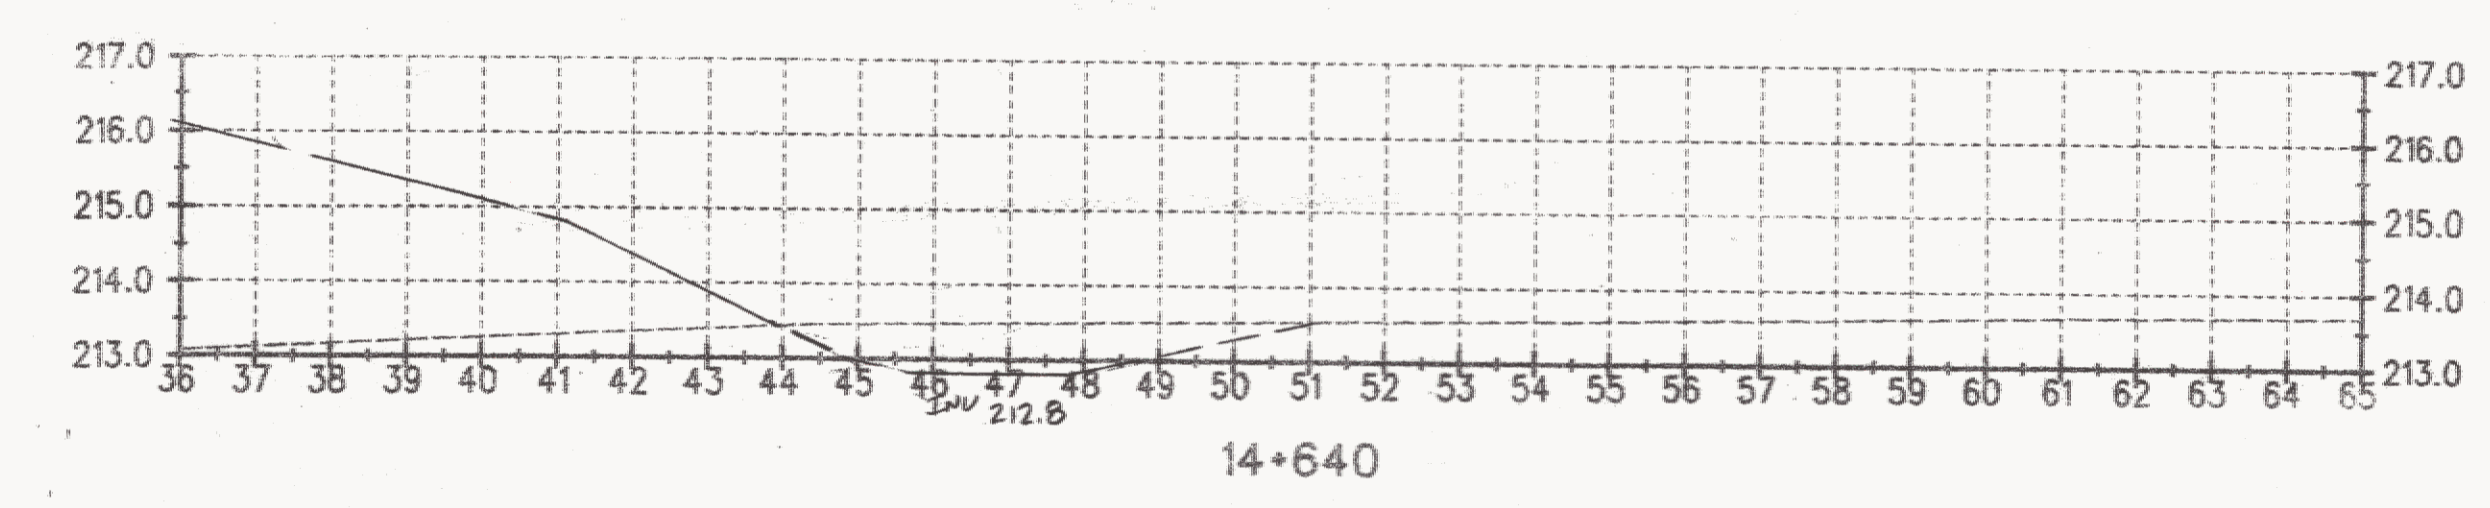

OG Plotted by JM 11/8/02, DH 11/15/03
 OG Checked by RRM Z-13-03
 TEMP ELV. + 0/s BY BB
 " v By Jpw 9/17/05

C = + 20.68
 F = 92 42.34
 R = 0 ✓

BY RRM
 Z-10-03

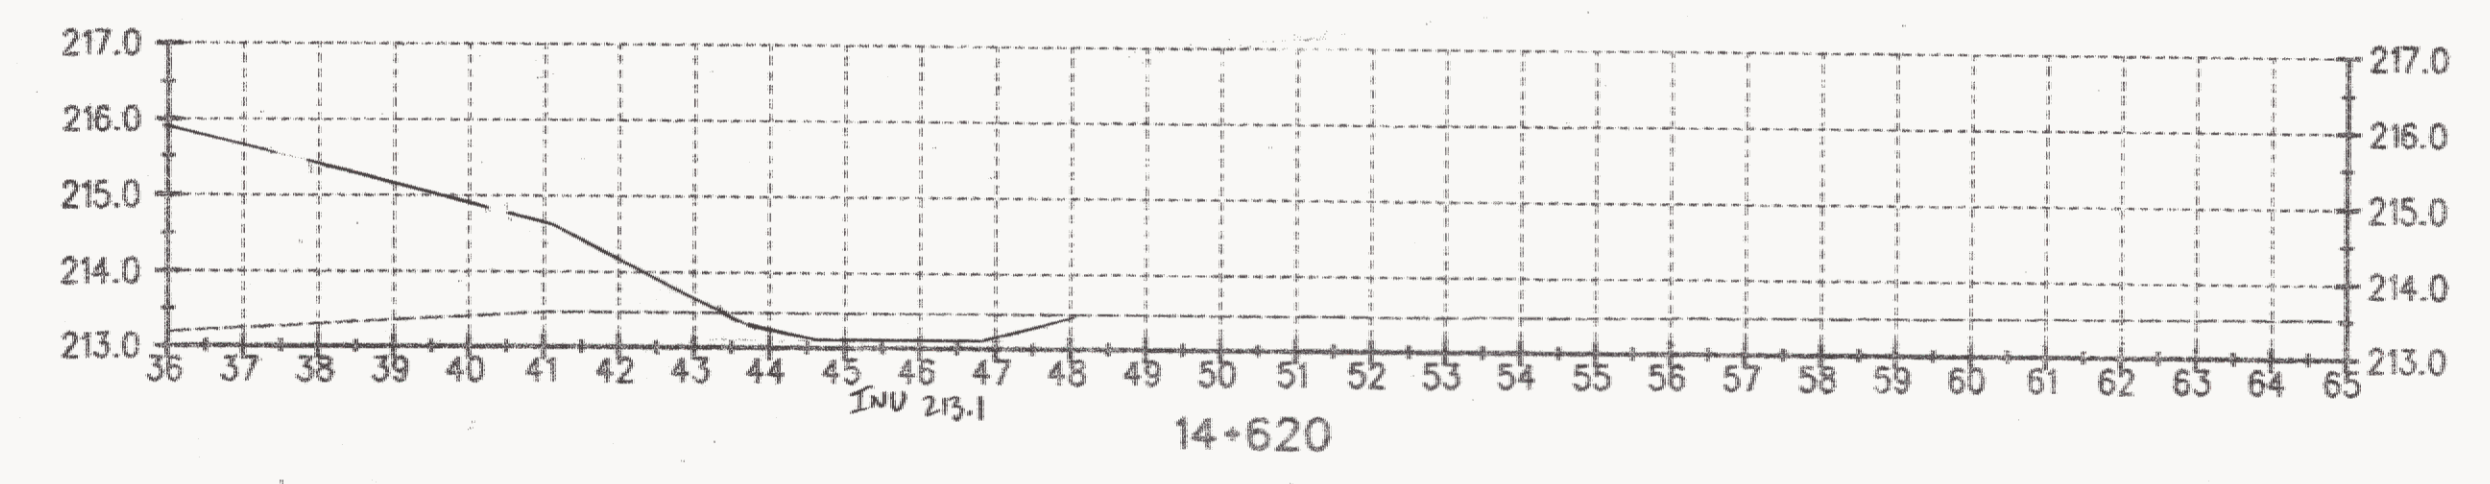

DATUM
 VERTICAL NAVD 88
 HORIZONTAL NAD 83 (1992)

ALL DIMENSIONS IN MILLIMETERS EXCEPT AS INDICATED
 2 0 2 m
 H 1:100
 V 1:100

SURVEYED BY C.H.A. & V.S.E. DATE
 DRAWN BY J.S.L. DATE
 SQUAD LEADER T.P.K.
 DESIGN FILE NO. N/A
 IPARM FILE DATE PLOTTED
 PROJ. NAME BENNINGTON - HOOSICK D.P.I. 0146(1) C/3 STA
 PROJ. NO. P.I.N. 1306.60.201 14+640
 SHEET 32 OF 473 SHEETS 14+620