

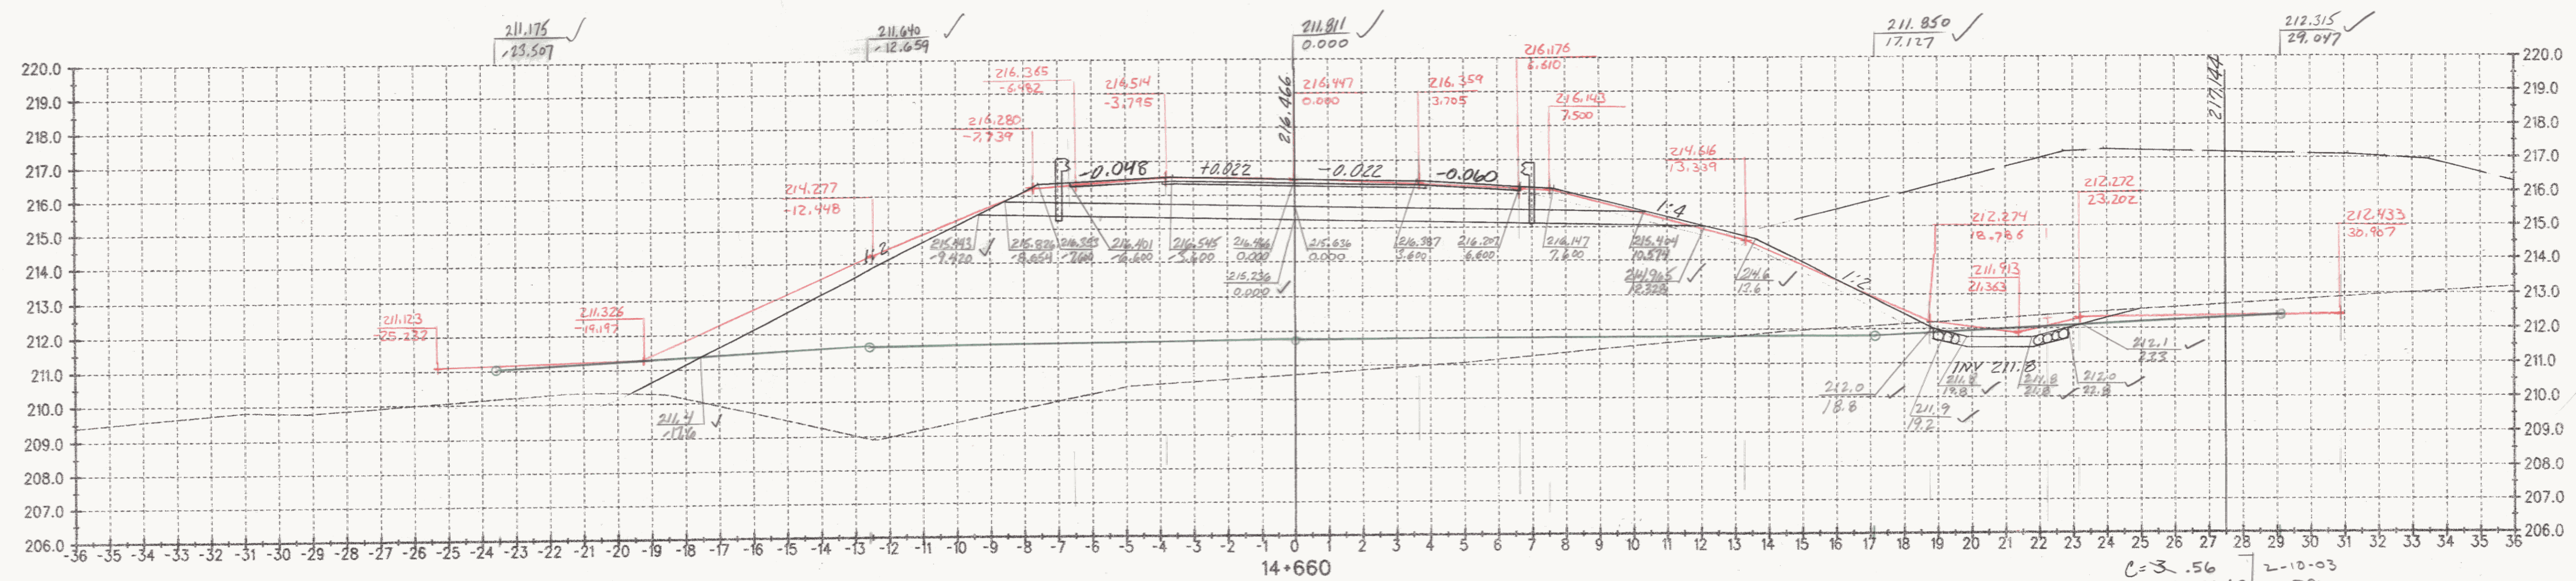


$C = 2.123$
 $F = 146.168.60$ BY RRM
 $R = 0$ ✓
 2-10-03
 ✓ JWS 11/13/05

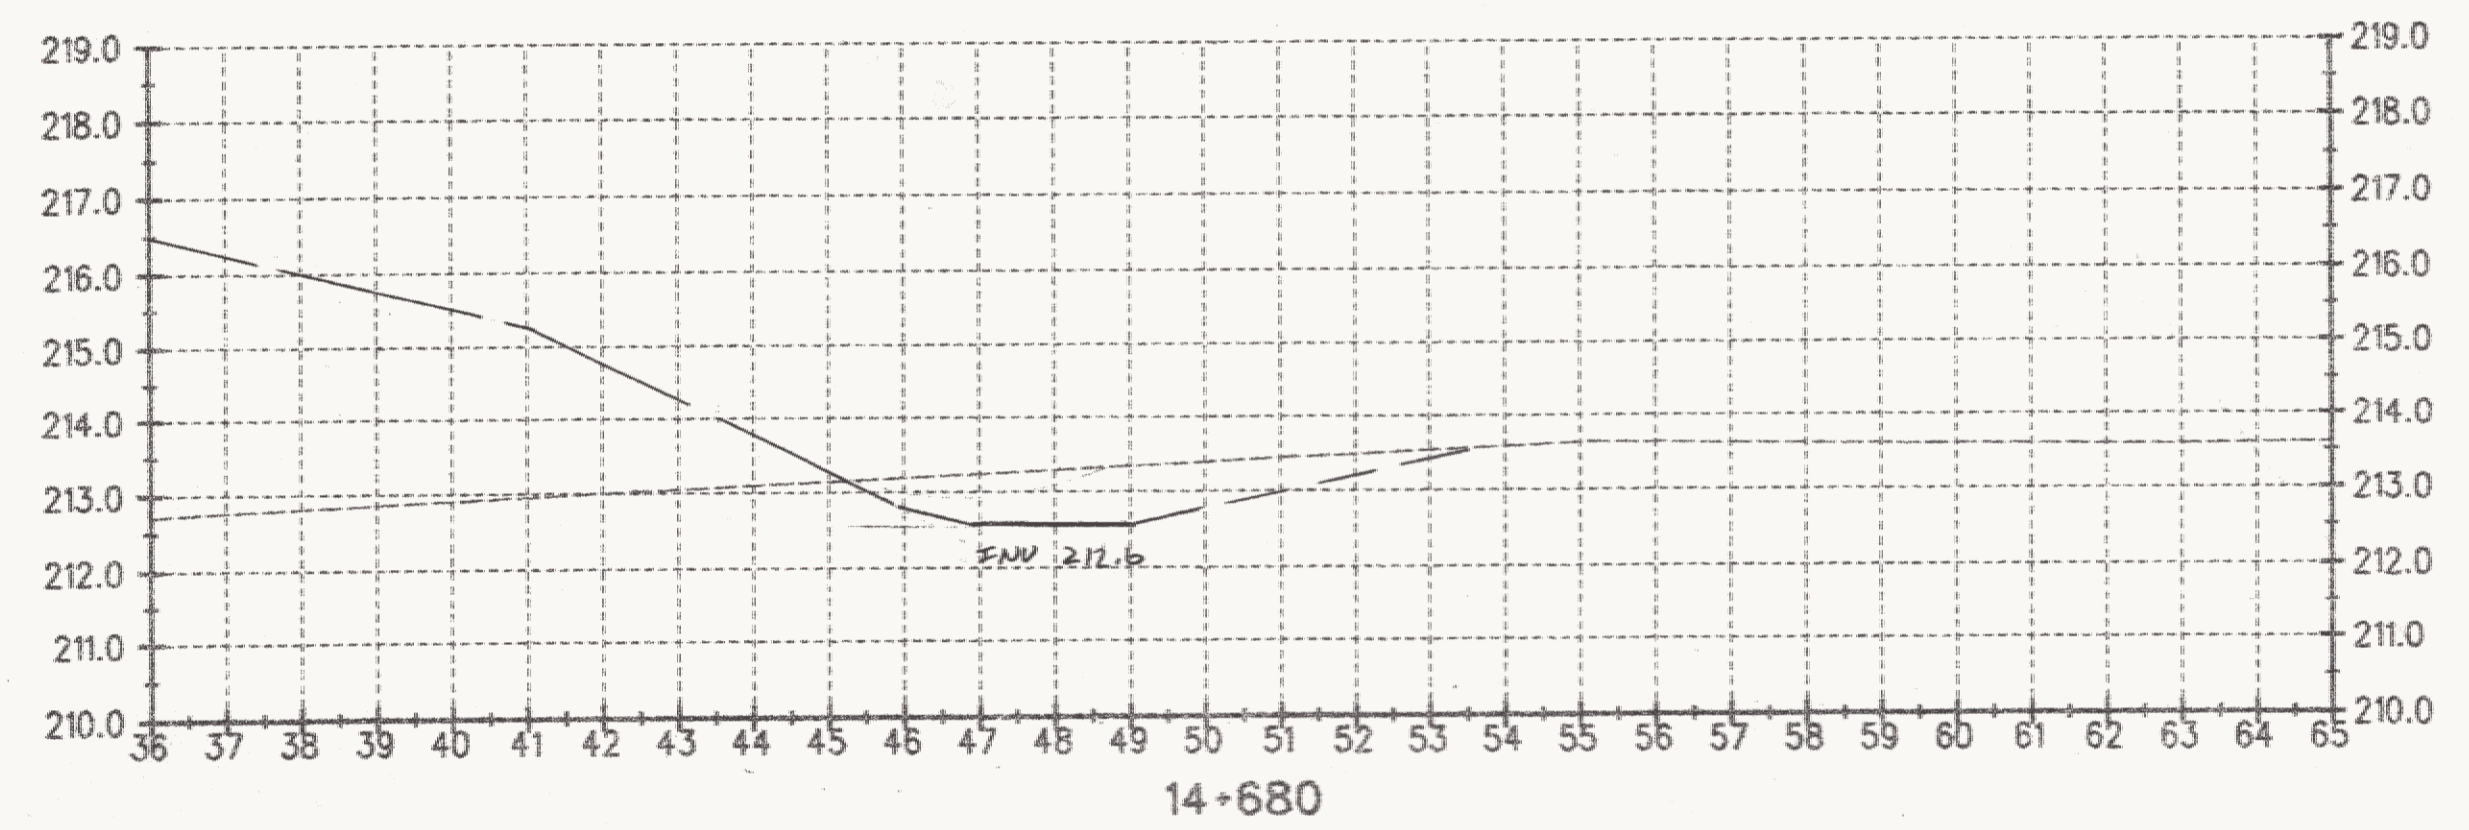

$C = 3.56$
 $F = 136.100.60$ BY RRM
 $R = 0$ ✓
 2-10-03

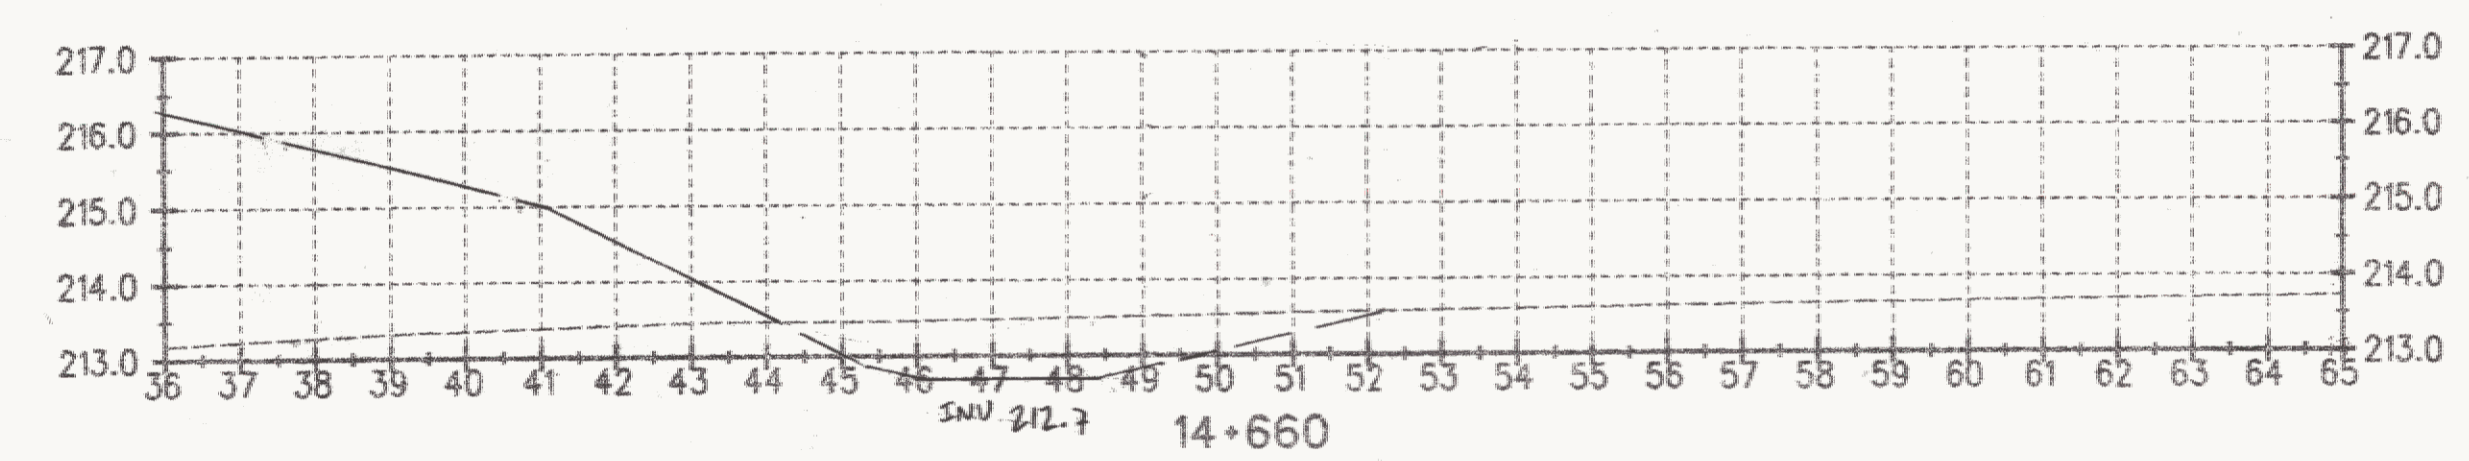

DATUM
 VERTICAL NAVD 88
 HORIZONTAL NAD 83 (1992)

Both Sect's	BY	✓ BY
O.G.	DH 11/15/03	RRM 2-13-03
TEMP.	DH	RRM 2-13-03
Elv. + 0.5		
FIG	at 4/10/05	

ALL DIMENSIONS IN MILLIMETERS EXCEPT AS INDICATED
 ✓ JWS 11/13/05
 0 2 m
 H 1:100
 V 1:100

SURVEYED BY	C.H.A. & V.S.E.	DATE	
DRAWN BY	J.S.L.	DATE	
SQUAD LEADER	T.P.K.		
DESIGN FILE NO.	N/A		
DATE PLOTTED			
PROJ. NAME	BENNINGTON - HOOSICK		
	D.P.I. 0146(1) C/3		
PROJ. NO.	P.I.N. 1306.60.201		
SHEET	393 OF 473 SHEETS		