


Metric
 DATUM
 VERTICAL NAVD 88
 HORIZONTAL NAD 83 (1992)

| BOTH SECT'S | BY | Y BY |
|--------------|------------|---------|
| O.G | DH 1/15/03 | RRM |
| TEMP | | Z-13-03 |
| Elev. + 0.15 | BB | RRM |
| FIG | BL 4/13/05 | Z-13-03 |

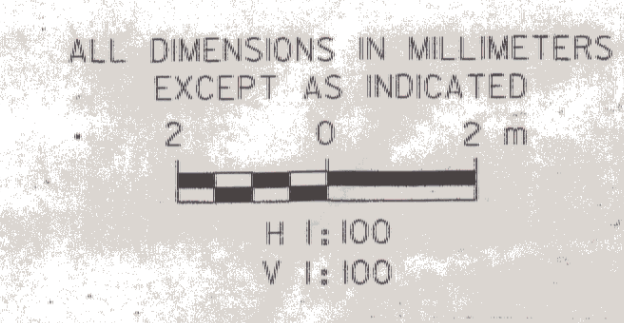

SURVEYED BY C.H.A. & V.S.E. DATE _____
 DRAWN BY J.S.L. DATE _____
 SQUAD LEADER T.P.K.
 DESIGN FILE NO. N/A
 IPARM DATE PLOTTED _____
 FILE _____
 PROJ. NAME BENNINGTON - HOOSICK
 D.P.I. 0146(1) C/S
 PROJ. NO. P.I.N. 1306.60.201
 SHEET 394 OF 473 SHEETS