


14+820

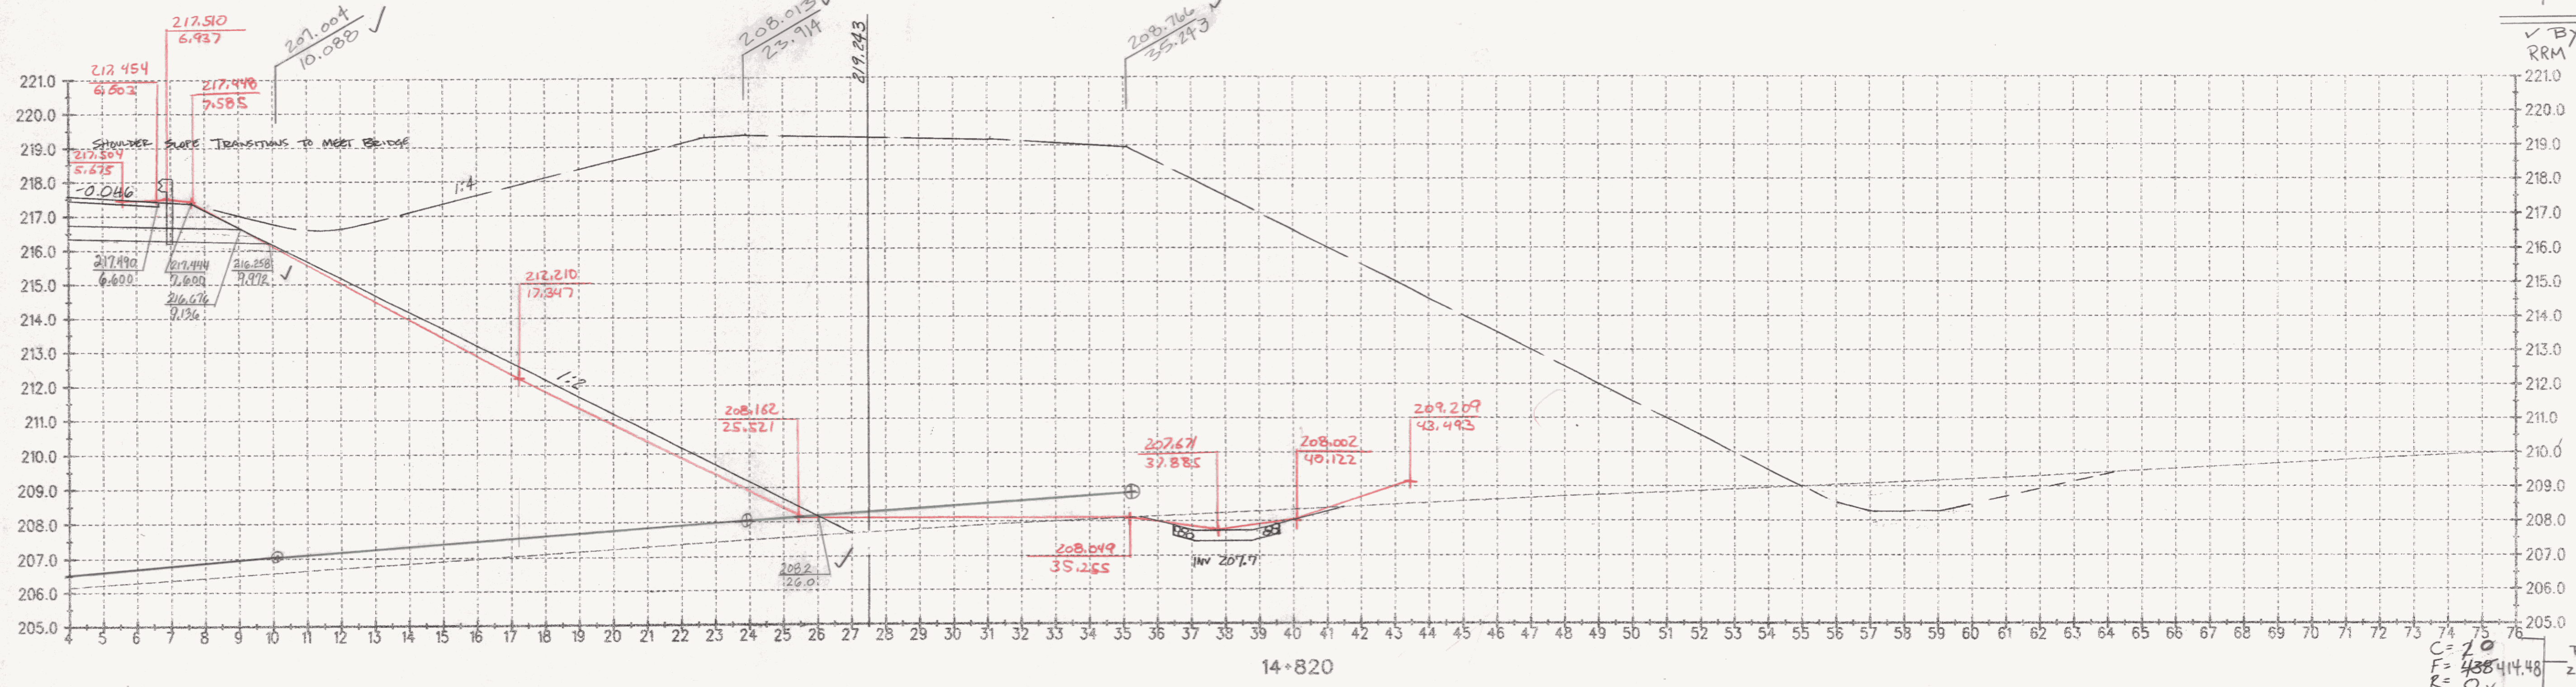


14+820

Vertical Survey
O.L.
Drawn by
JPK 1/15/13

BY RRM 2-13-03
FG BL 4/2005

C=10
F=488414.48
R=0v

SURVEYED BY C.H.A. & V.S.E. DATE
DRAWN BY J.S.L. DATE
SQUAD LEADER T.P.K.
DESIGN FILE NO. N/A
IPARM FILE DATE PLOTTED
PROJ. NAME BENNINGTON - HOOSICK
D.P.I. 0146(1) C13
PROJ. NO. P.I.N. 1306.60.201
SHEET 378 OF 473 SHEETS

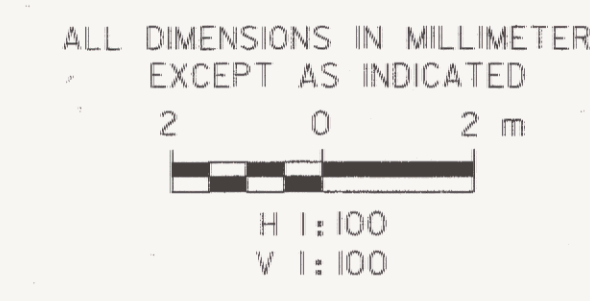

Metric
DATUM
VERTICAL NAVD 88
HORIZONTAL NAD 83 (1992)