


VERMONT
 SURVEY 0.11
 DRAWN BY
 JFW 1/15/03
 FG 4/13/05
 4/19/05

Metric

DATUM

VERTICAL NAVD 88

HORIZONTAL NAD 83 (1992)

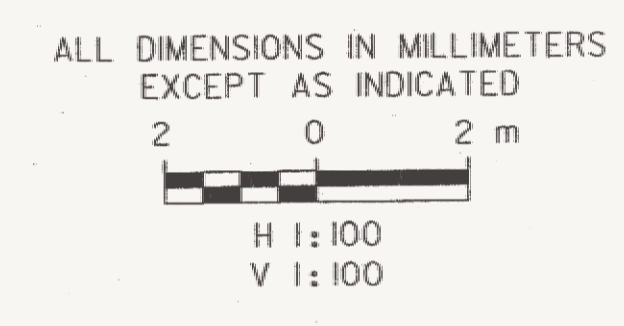

| | | | |
|-----------------|--|---------------|--|
| SURVEYED BY | C.H.A. & V.S.E. | DATE | |
| DRAWN BY | J.S.L. | DATE | |
| SQUAD LEADER | T.P.K. | | |
| DESIGN FILE NO. | N/A | | |
| IPARM FILE | | DATE PLOTTED | |
| PROJ. NAME | BENNINGTON - HOOSICK D.P.I. 0146(1) C/B | | |
| PROJ. NO. | P.I.N. 1306.60.201 | | |
| SHEET | 399 | OF 473 SHEETS | |

$C=0$
 $F=463$
 $R=OV$
 $471.15 m^2$