


14+880

*AIRPORT BROOK  
EAST*

C=0  
F=0  
R=0

ALL DIMENSIONS IN MILLIMETERS  
EXCEPT AS INDICATED

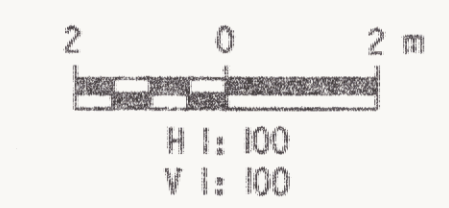

DATUM	
VERTICAL	NAVD 88
HORIZONTAL	NAD 83 (1992)

SURVEYED BY	C.H.A. & V.S.E.	DATE	6/95
DESIGNED BY	D.E.G.	DATE	6/95
DRAWN BY	J.S.L.	DATE	6/95
CHECKED BY	T.P.K.	DATE	6/95
DESIGN FILE NO.	N/A		
PROJ. NAME	BENNINGTON - HOOSICK D.P.I. 0146(1) C/3		
PROJ. NO.	P.I.N. 1306.60.201		
SHEET	401	OF 473 SHEETS	DWG No. -