


N=33
 N=34
 N=35
 N=100


DATUM
 VERTICAL NAVD 88
 HORIZONTAL NAD 83 (1992)

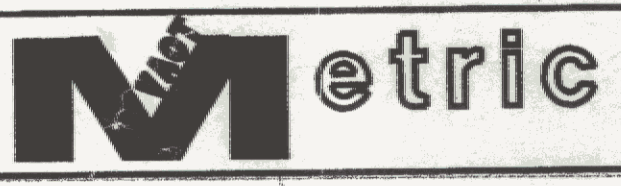

NOTE: NO AS-BUILT SURVEY DATA PROVIDED
 RMT 4/13/05

C=0V
 F=553 593.17 m
 R=0V

ALL DIMENSIONS IN MILLIMETERS EXCEPT AS INDICATED

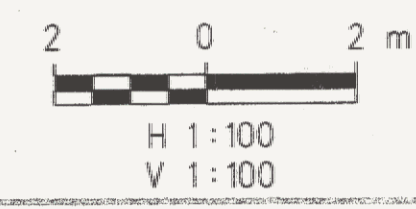

SURVEYED BY	C.H.A. & V.S.E.	DATE	
DRAWN BY	J.S.L.	DATE	
SQUAD LEADER	T.P.K.		
DESIGN FILE NO.	N/A		
IPARM FILE		DATE PLOTTED	
PROJ. NAME	BENNINGTON - HOOSICK		
	D.P.I. 0146(1) C/3		
PROJ. NO.	P.I.N. 1306.60.201		
SHEET	404	OF 473 SHEETS	

DRG V.S.
 BY RRM
 1/14/03