


14+940

C=0  
 F=602 592.67 Jpw 2/10/03  
 R=0

ORIG. Y.S.  
 BY RRM  
 11/14/03  
 FG RMT 411305

**Metric**

DATUM  
 VERTICAL NAVD 88  
 HORIZONTAL NAD 83 (1992)

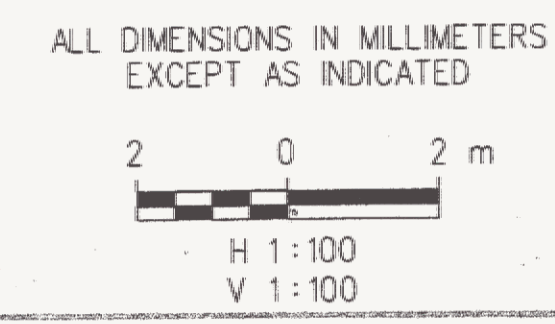

SURVEYED BY	C.H.A. & V.S.E.	DATE	
DRAWN BY	J.S.L.	DATE	
SQUAD LEADER	T.P.K.		
DESIGN FILE NO.	N/A		
PARM FILE		DATE PLOTTED	
PROJ. NAME	BENNINGTON - HOOSICK		
	D.P.I. 0146(1) C3		
PROJ. NO.	P.I.N. 1306.60.201		
SHEET	405 OF 473 SHEETS		