


ORIG VS.  
By: RRM  
11/14/03  
FG: 413/05

C = 0 ✓  
F = 612 ✓  
R = 0 ✓

SURVEYED BY C.H.A. & V.S.E. DATE \_\_\_\_\_  
DRAWN BY J.S.L. DATE \_\_\_\_\_  
SQUAD LEADER T.P.K. \_\_\_\_\_  
DESIGN FILE NO. N/A \_\_\_\_\_  
IPARM \_\_\_\_\_ DATE \_\_\_\_\_  
FILE \_\_\_\_\_ PLOTTED \_\_\_\_\_  
PROJ. NAME BENNINGTON - HOOSICK  
D.P.I. 0146(1) C/3  
PROJ. NO. P.I.N. 1306.60.201  
SHEET 46 OF 473 SHEETS

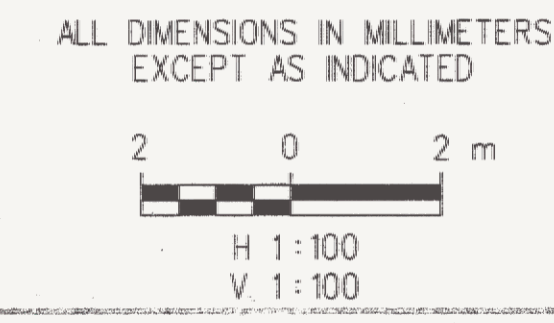

**Metric**

DATUM  
VERTICAL NAVD 88  
HORIZONTAL NAD 83 (1992)