
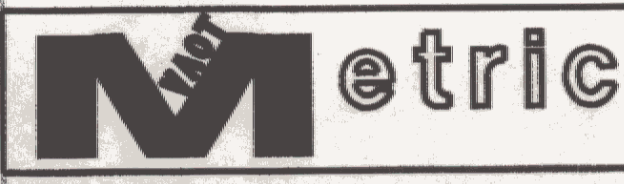



123 W 5000
B3 Book

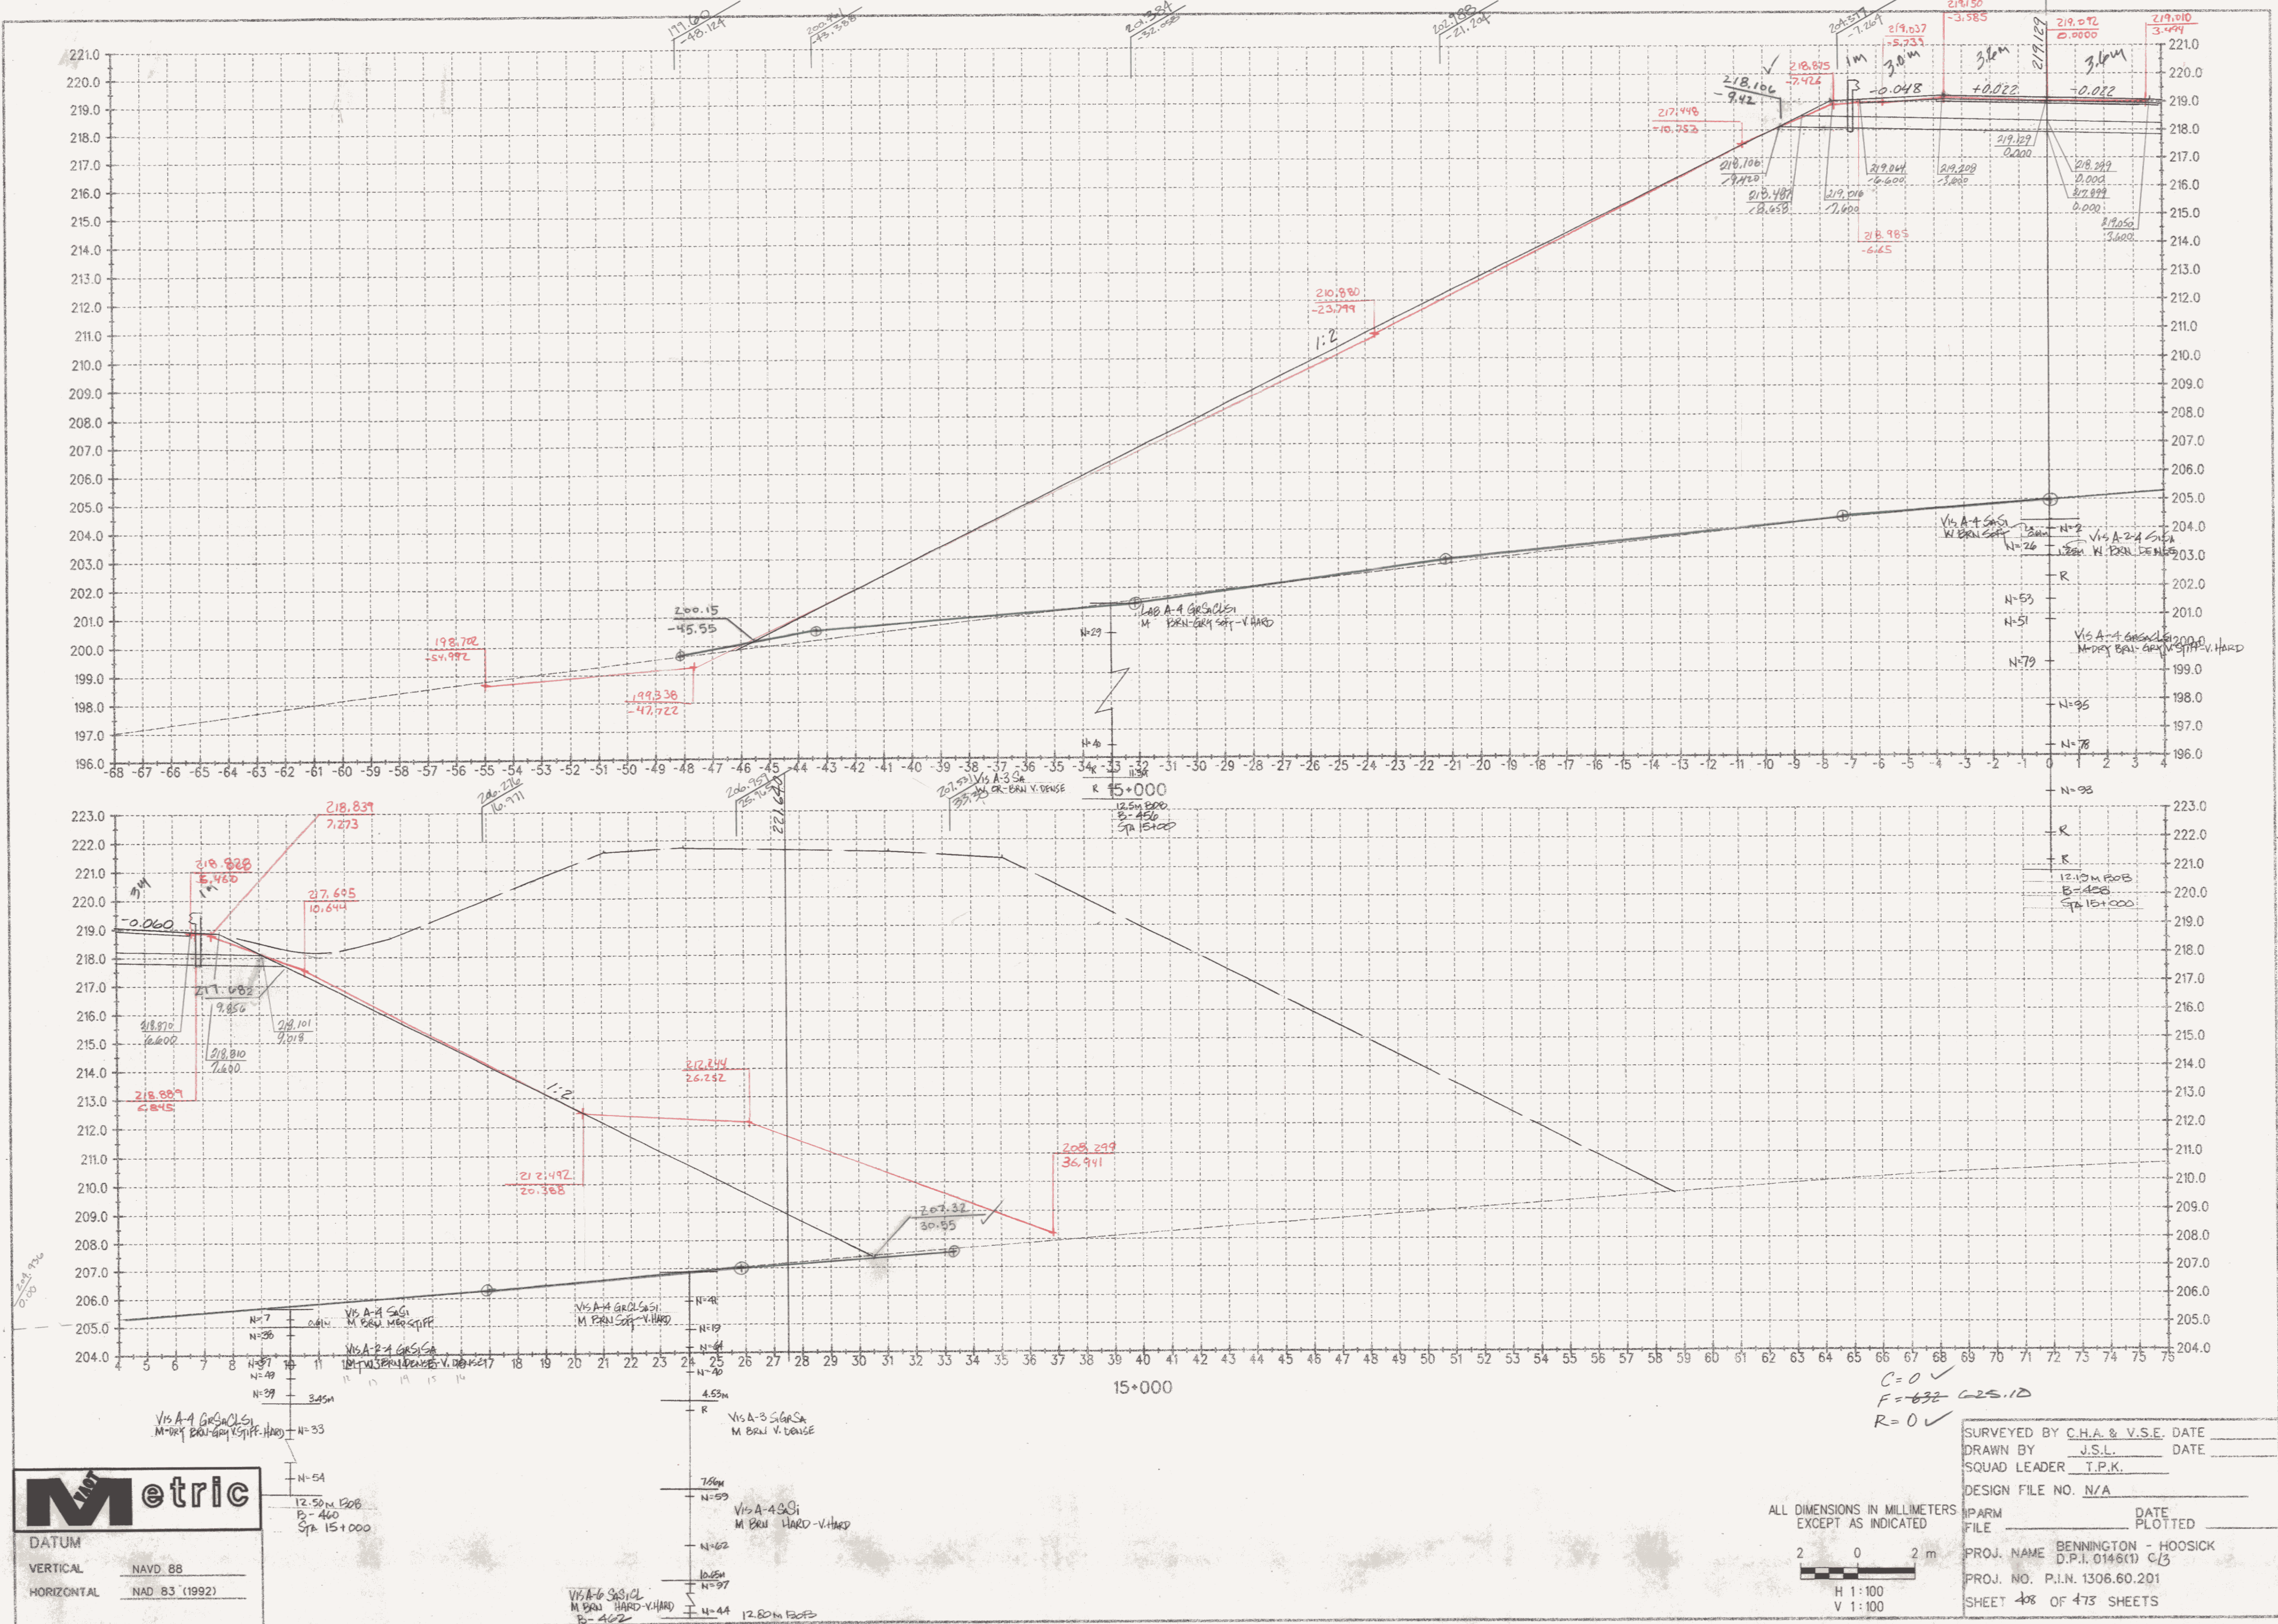

DATUM
VERTICAL NAVD 88
HORIZONTAL NAD 83 (1992)

C=0 ✓
F=632 G25.12
R=0 ✓

ALL DIMENSIONS IN MILLIMETERS
EXCEPT AS INDICATED

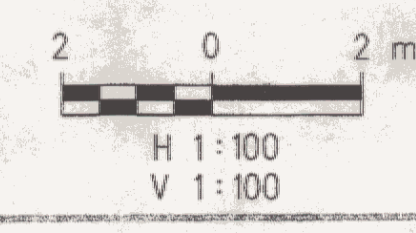

SURVEYED BY	C.H.A. & V.S.E.	DATE	
DRAWN BY	J.S.L.	DATE	
SQUAD LEADER	T.P.K.		
DESIGN FILE NO.	N/A		
IPARM FILE		DATE PLOTTED	
PROJ. NAME	BENNINGTON - HOOSICK		
	D.P.I. 0146(1) C/3		
PROJ. NO.	P.I.N. 1306.60.201		
SHEET	408 OF 473 SHEETS		