
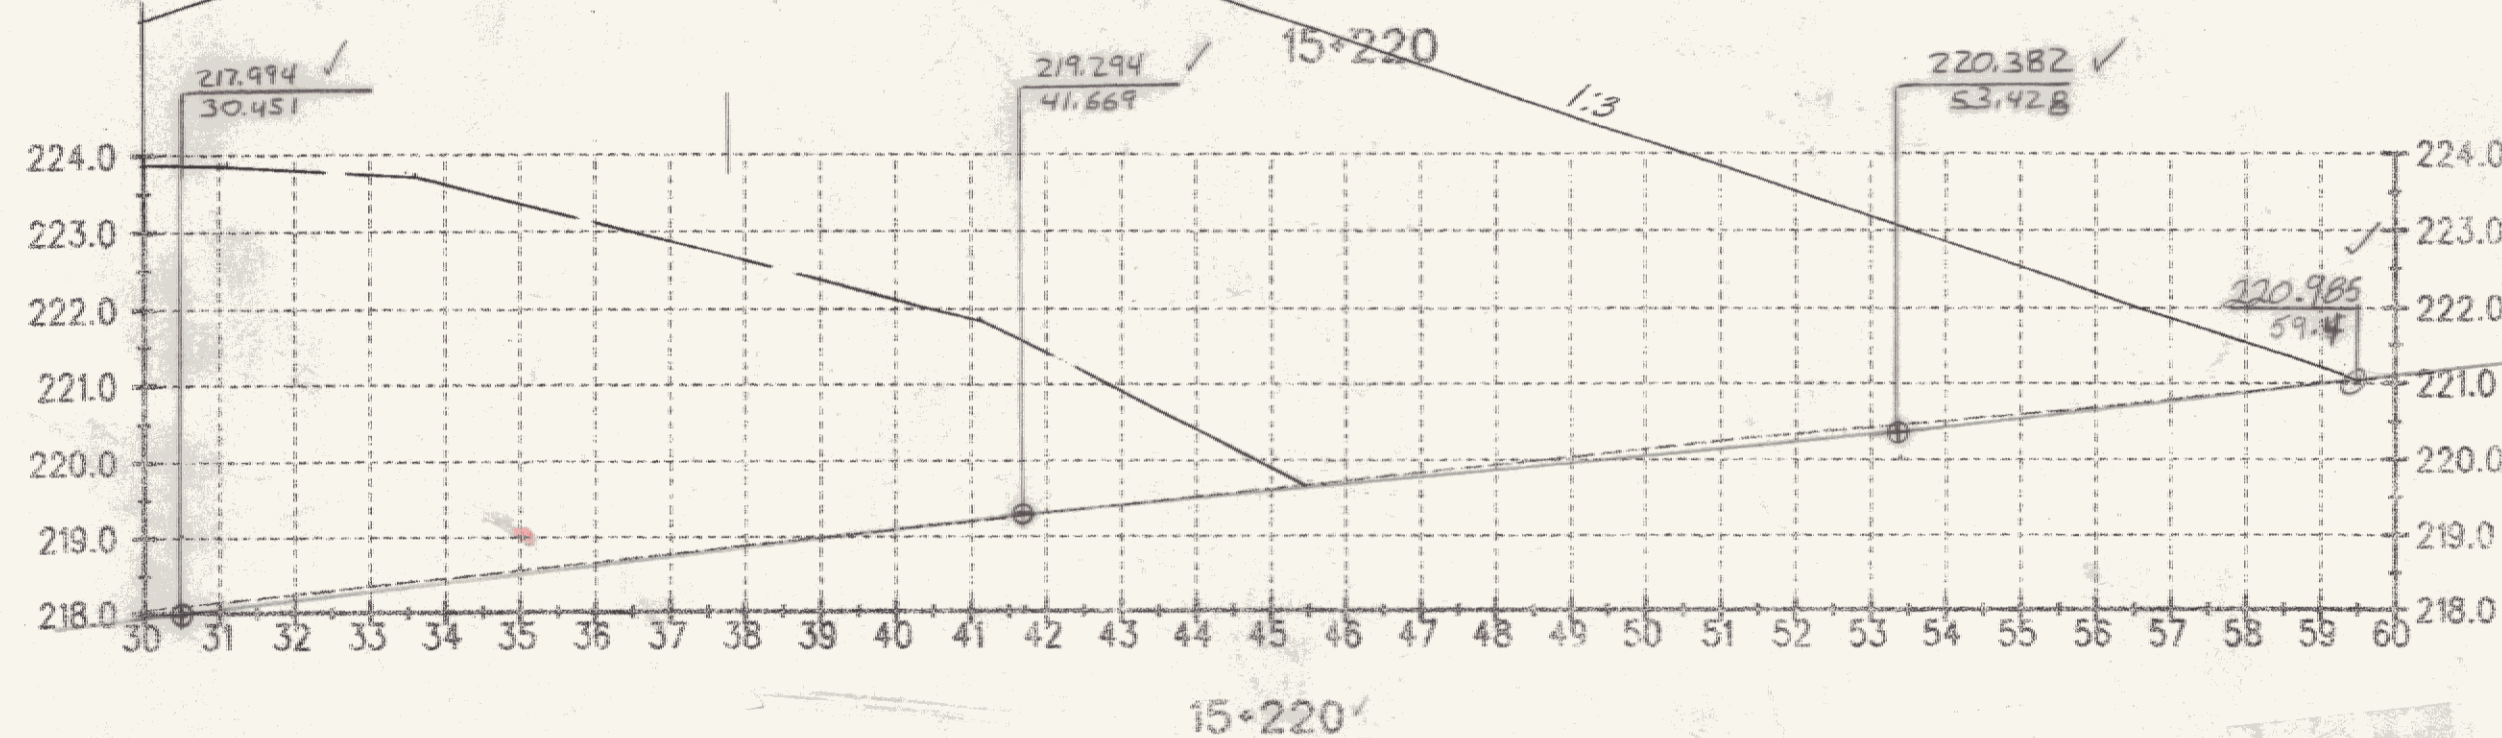


	BY	DATE
O.C.	BL	RRM 2-11-03
TEMP		RRM 2-11-03
EW/OS		
FG	BL	1/25/05

$C=0$
 $F=354 \text{ } 362.47 \text{ m}^2$
 $R=0$
 SEE REVISED CROSS SECTIONS,
 SHEETS 2 & 3 OF 8, IN THE
 "SIGHT BERM GRADING PLAN" SET.
 FMT 2/6/06

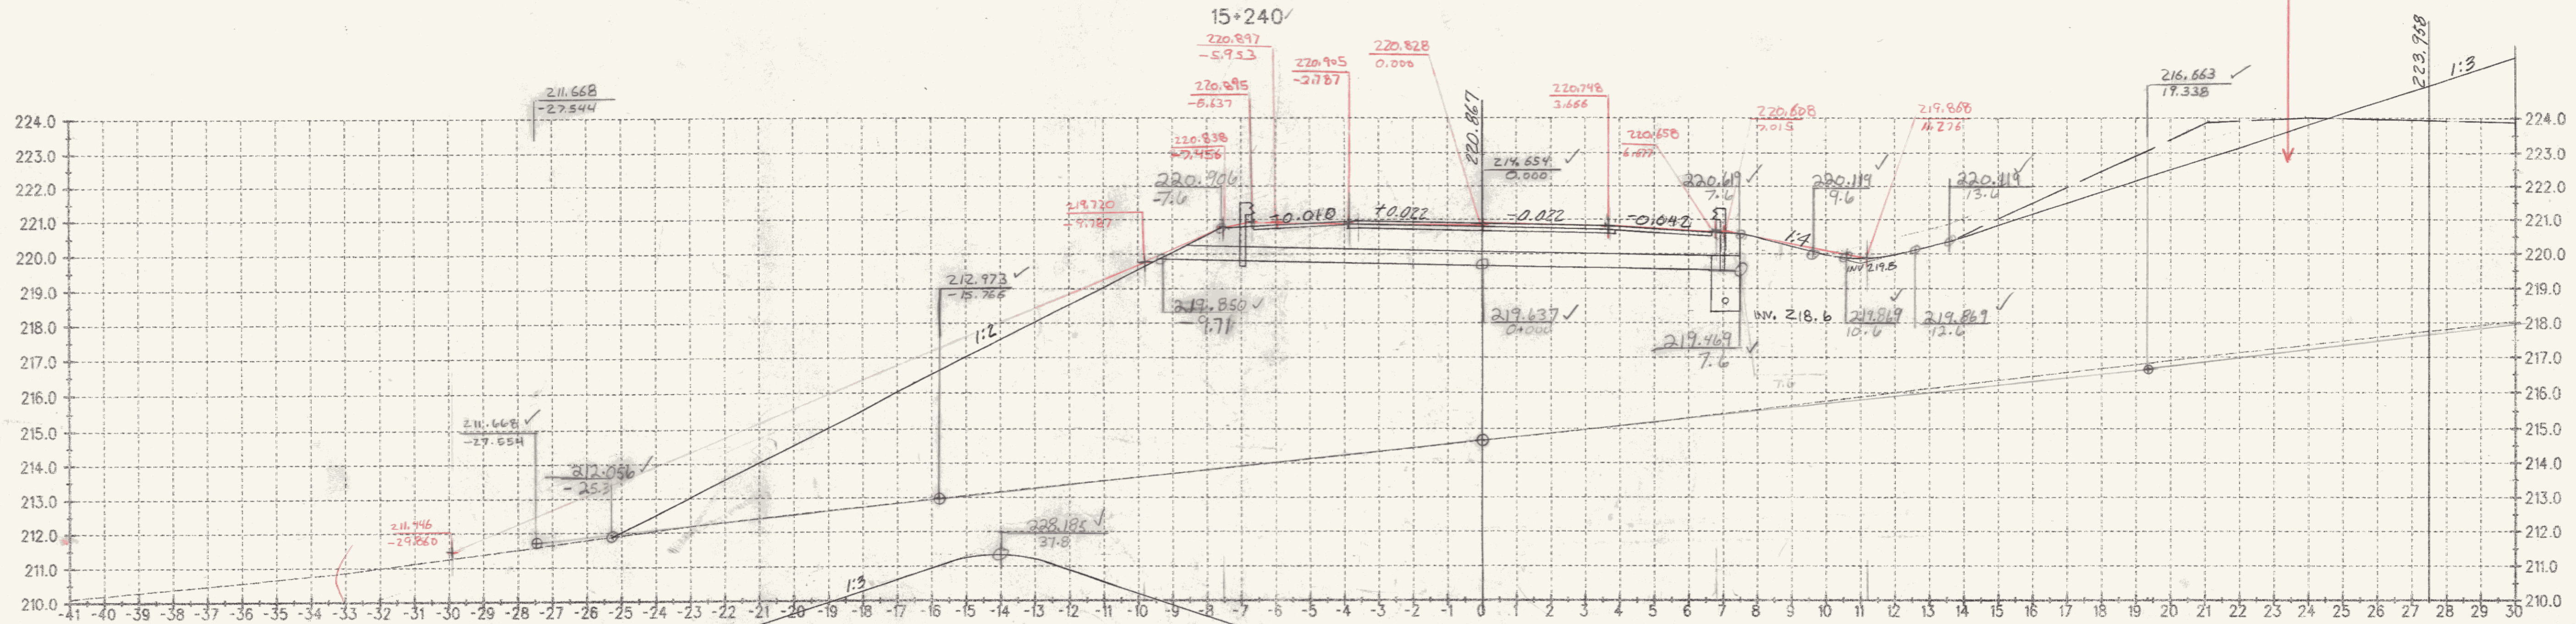

	BY	DATE	DATE
O.C.	BL	RRM	2-11-03
TEMP		RRM	2-11-03
EW/OS			
FG	BL	1/25/05	1/25/05

$C=0$
 $F=432 \text{ } 426.58 \text{ m}^2$
 $R=0$

Metric

DATUM

VERTICAL NAVD 88

HORIZONTAL NAD 83 (1992)

ALL DIMENSIONS IN MILLIMETERS EXCEPT AS INDICATED

2 0 2 m

H 1:100
V 1:100

SURVEYED BY C.H.A. & V.S.E. DATE _____
 DRAWN BY J.S.L. DATE _____
 SQUAD LEADER T.P.K.
 DESIGN FILE NO. N/A
 PARM FILE _____ DATE PLOTTED _____
 PROJ. NAME BENNINGTON - HOOSICK
 D.P.I. 0146(1) C/3
 PROJ. NO. P.I.N. 1306.60.201
 SHEET 418 OF 473 SHEETS