
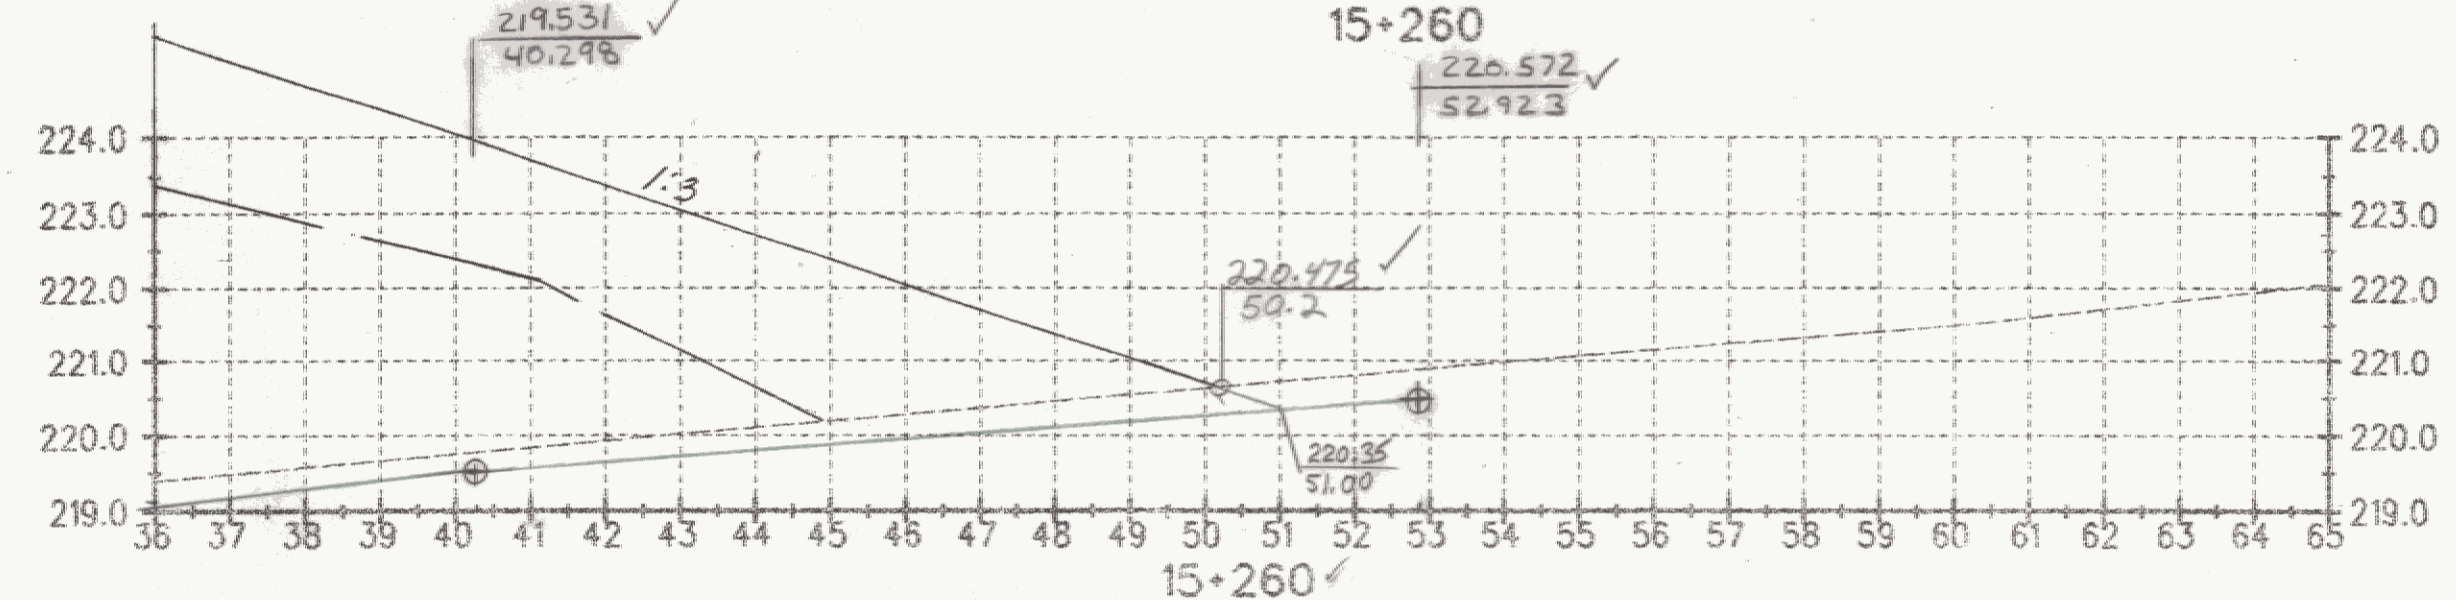


BY	✓ BY
O.C.	BL RRM 2-11-03
TEMP.	RRM 2-11-03
E.L.V. + 0.5	
F.I.S. 11/24/05	AL <i>Apuripaska</i>

SEE REVISED CROSS SECTIONS, SHEETS 3 & 4 OF 8, IN THE "SIGHT BERM GRADING PLAN" SET. RMT 2/6/06

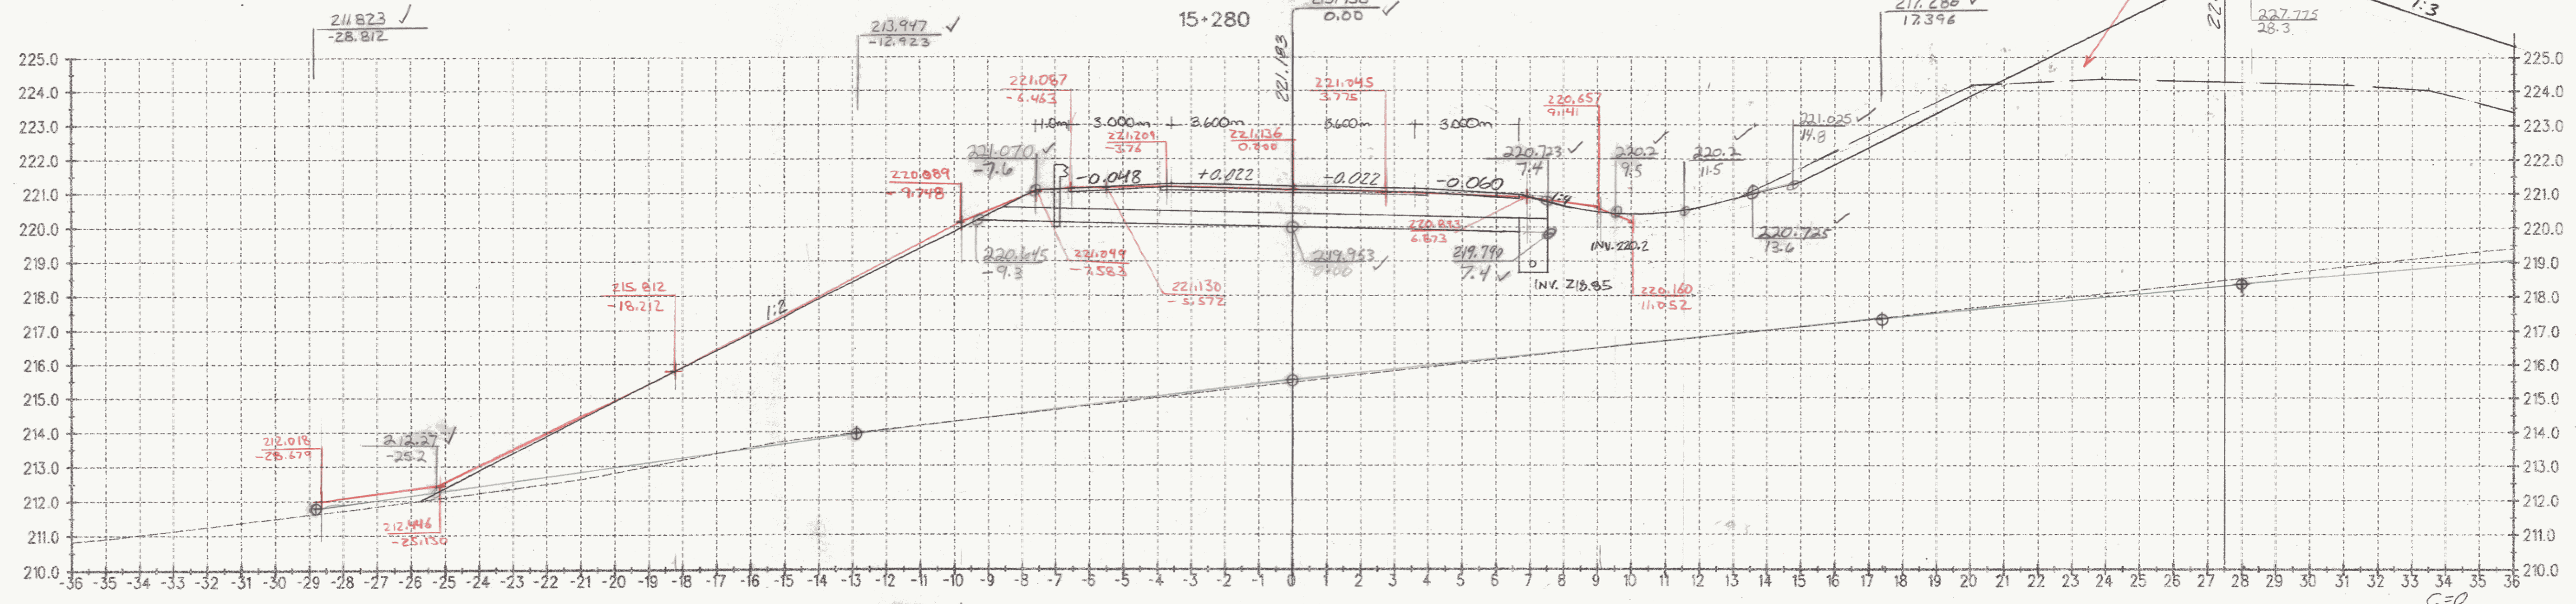

BY	✓ BY
O.C.	BL RRM 2-11-03
TEMP.	RRM 2-11-03
E.L.V. + 0.5	
F.I.S. 11/24/05	AL <i>Apuripaska</i>

ALL DIMENSIONS IN MILLIMETERS EXCEPT AS INDICATED
 H 1:100
 V 1:100

SURVEYED BY C.H.A. & V.S.E. DATE 6/95
 DESIGNED BY D.E.G. DATE 6/95
 DRAWN BY J.S.L. DATE 6/95
 CHECKED BY T.P.K. DATE 6/95
 DESIGN FILE NO. N/A
 PROJ. NAME BENNINGTON - HOOSICK D.P.I. 0146(1) c/3
 PROJ. NO. P.I.N. 1305.60.201
 SHEET 49 OF 473 DWG No.

DATUM
 VERTICAL NAVD 88
 HORIZONTAL NAD 83 (1992)