
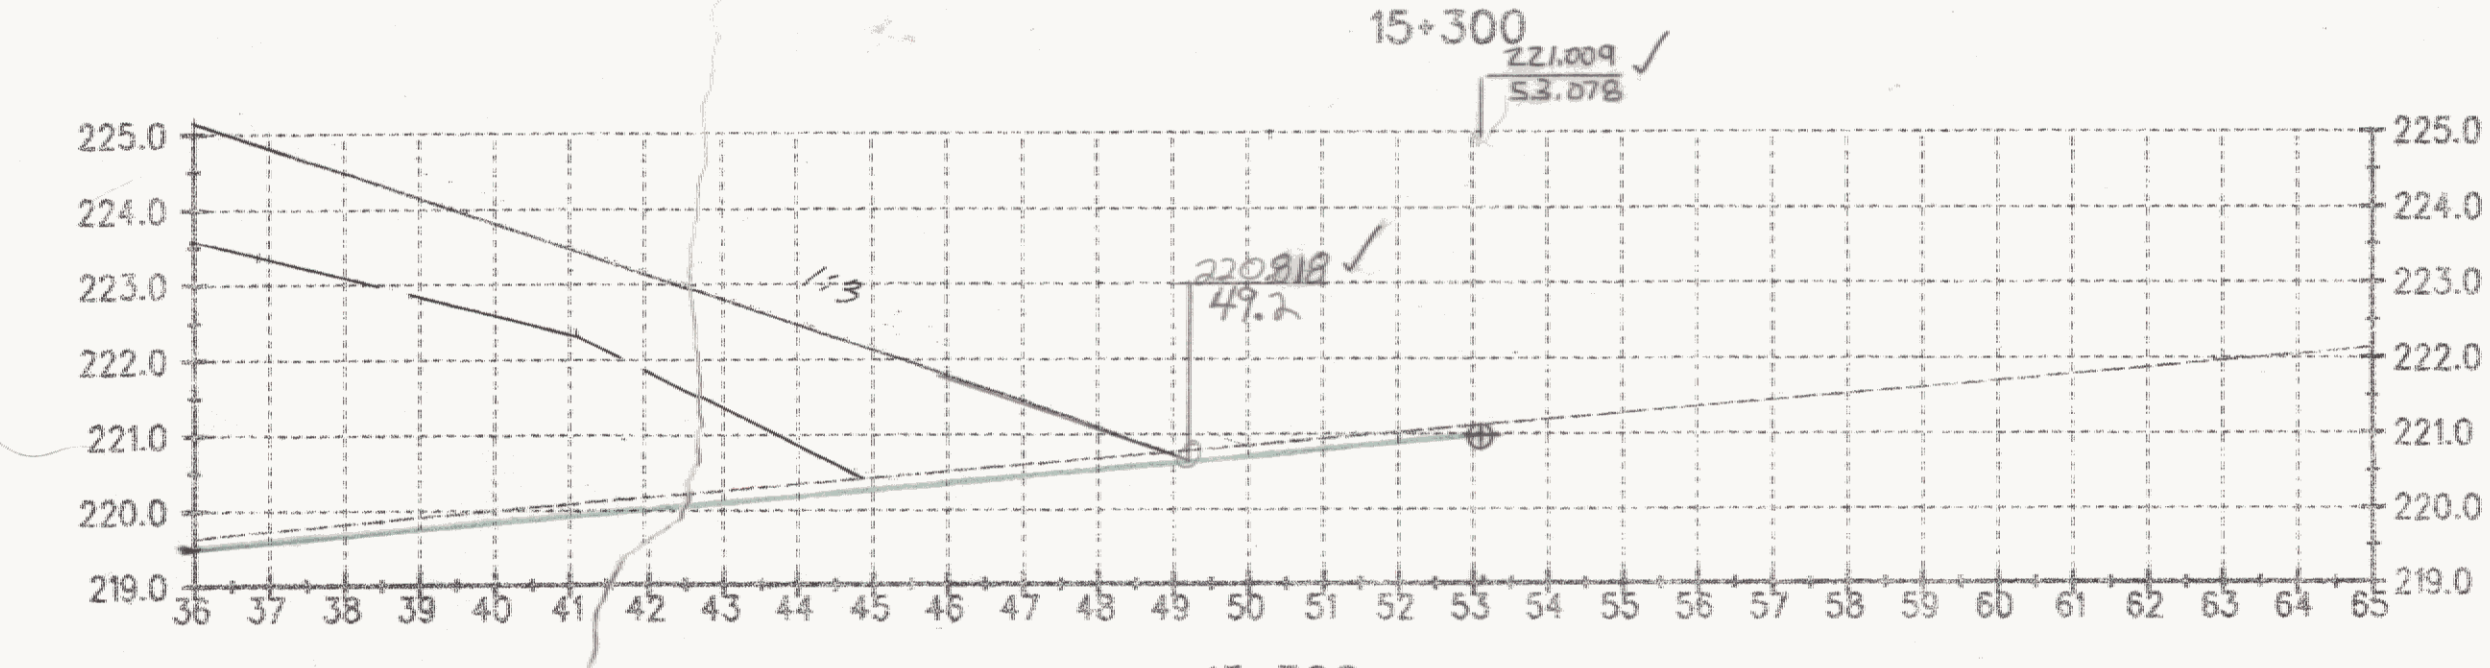


BY	DATE	✓ BY
O.G.	BL 1/13/03	RRM 2/11/03
TEMP.	1/13/03	RRM 2/11/03
EW. + O.S.		

SEE REVISED CROSS SECTIONS, SHEET 4 & 5 OF B, IN THE "SIGHT BERM GRADING PLAN" SET FROM 2/16/06

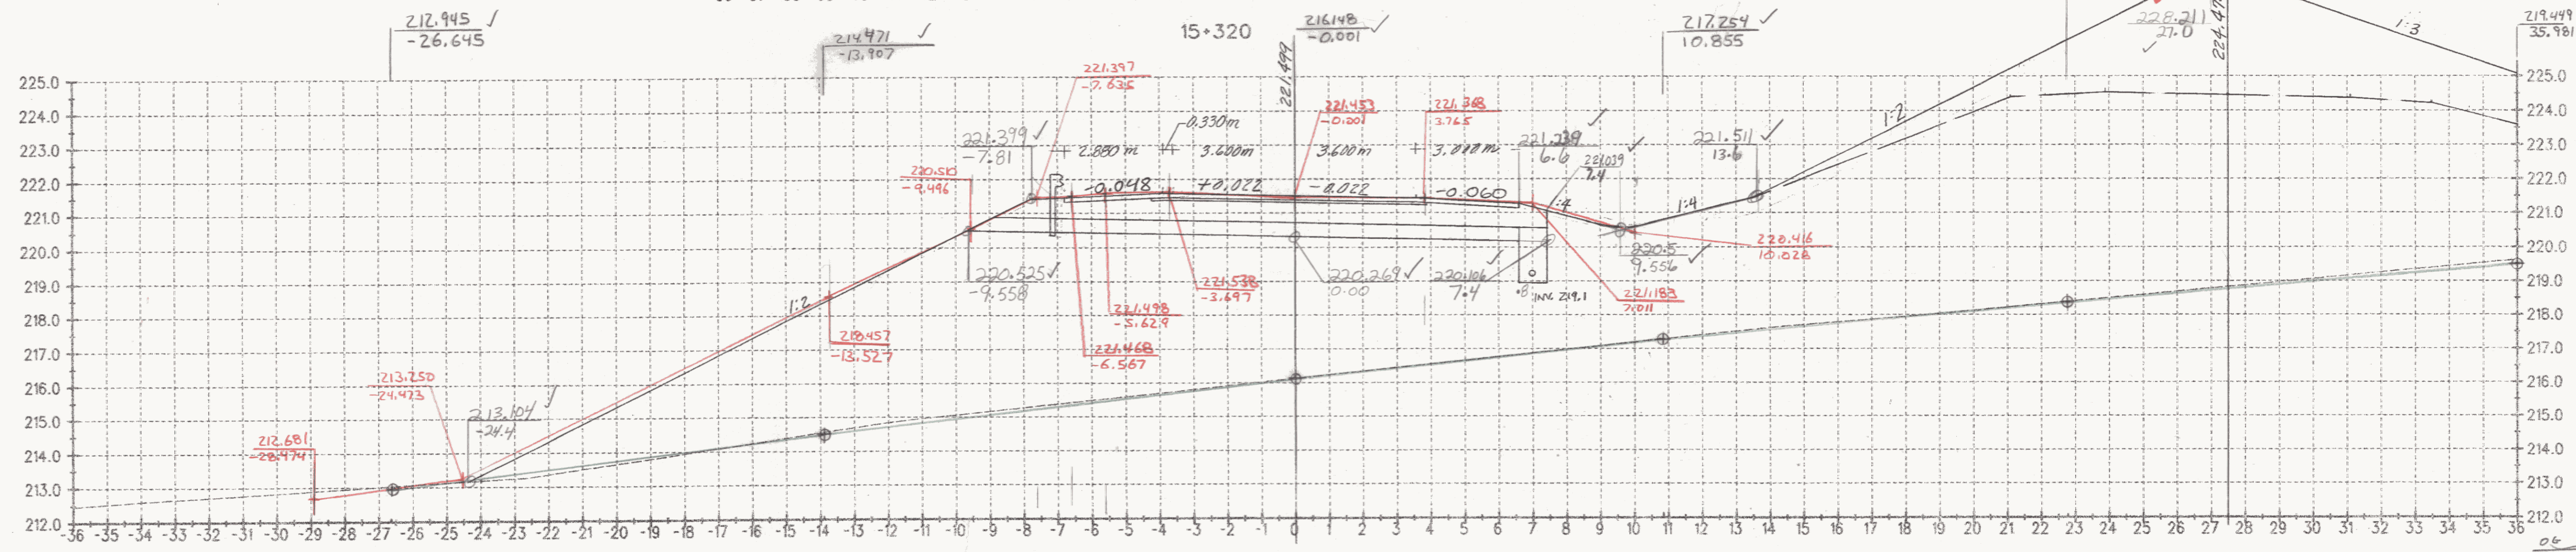

BY	DATE	✓ BY
O.G.	BL 1/13/03	RRM 2/11/03
TEMP.	1/13/03	RRM 2/11/03
EW. + O.S.		

C=0
E=382 334.25m
R=0

DATUM
VERTICAL NAVD 88
HORIZONTAL NAD 83 (1992)

ALL DIMENSIONS IN MILLIMETERS EXCEPT AS INDICATED
2 0 2 m
H 1:100
V 1:100

SURVEYED BY C.H.A. & V.S.E. DATE _____
DRAWN BY J.S.L. DATE _____
SQUAD LEADER T.P.K.
DESIGN FILE NO. N/A
DATE PLOTTED _____
PROJ. NAME BENNINGTON - HOOSICK
D.P.I. 0146(1) C/3
PROJ. NO. P.I.N. 1306.60.201
SHEET 420 OF 473 SHEETS