
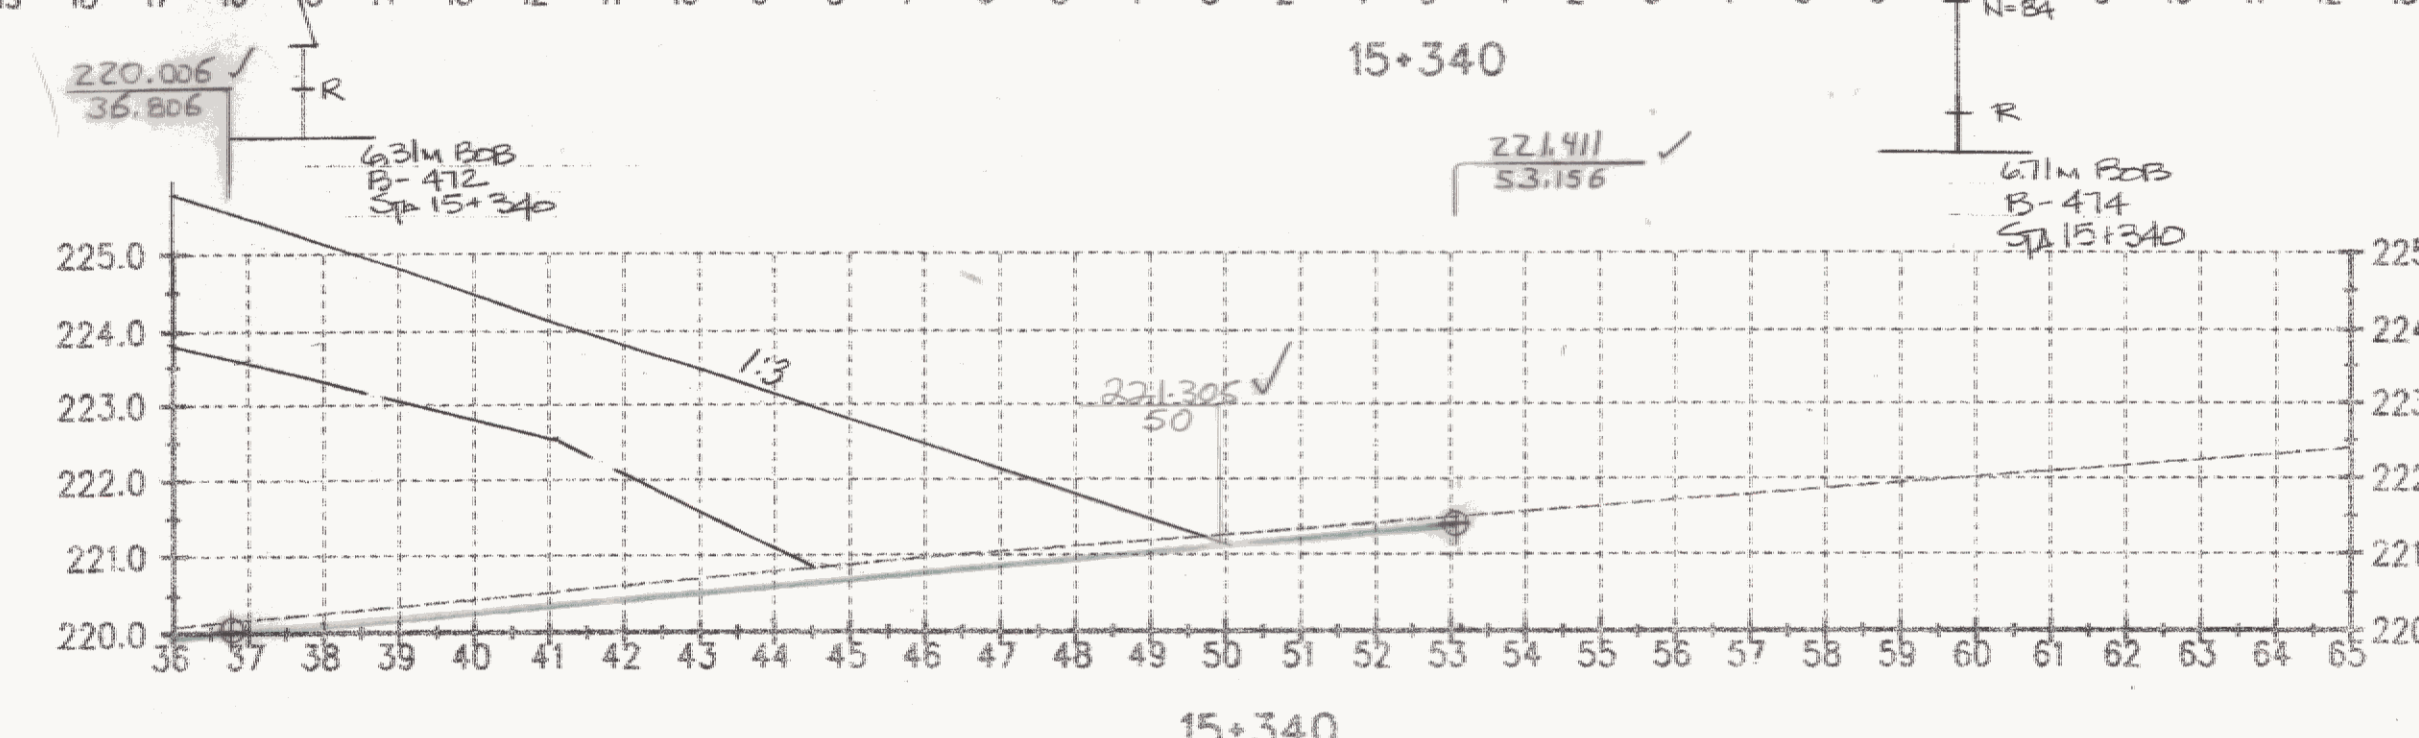


	BY	V BY
O.G.	BL	RRM 2-11-03
TEMP.	BL	RRM 2-11-03
F.G. 1/25/05	BL	

SEE REVISED CROSS SECTIONS,
SHEET 5 & 6 OF 8, IN THE
"SIGHT BERM GRADING PLAN" SET.
RUT 2/16/06

$C=0$
 $F=318$ $328.95m^2$
 $R=0$

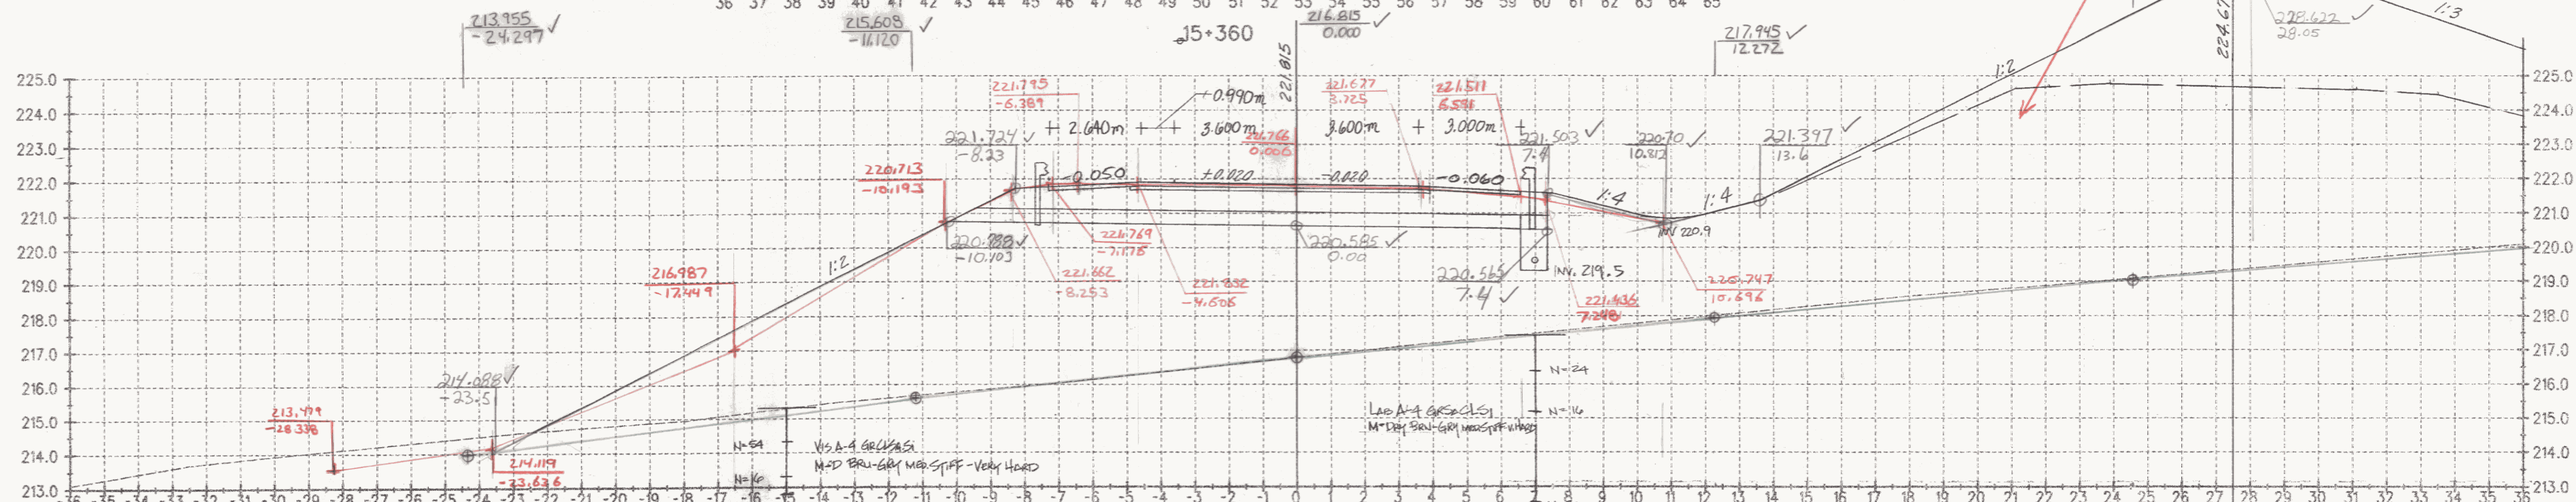

	BY	V BY
O.G.	BL	RRM 2-11-03
TEMP.	BL	RRM 2-11-03
F.G. 1/25/05	BL	J.P.K. 1/16/06

$C=0$
 $F=312$ $318.72m^2$
 $R=0$

ALL DIMENSIONS IN MILLIMETERS
EXCEPT AS INDICATED

2 0 2 m

H 1:100
V 1:100

DATUM
VERTICAL NAVD 88
HORIZONTAL NAD 83 (1992)

SURVEYED BY C.H.A. & V.S.E. DATE _____
DRAWN BY J.S.L. DATE _____
SQUAD LEADER T.P.K. _____
DESIGN FILE NO. N/A _____
IPARM FILE _____ DATE PLOTTED _____
PROJ. NAME BENNINGTON - HOOSICK
D.P.I. 0146(1) C/B
PROJ. NO. P.I.N. 1306.60.201
SHEET 421 OF 473 SHEETS