


SEE REVISED CROSS SECTION,
SHEET 6 OF 8, IN THE
"SIGHT BERM GRADING PLAN" SET.
RUT 2/6/06

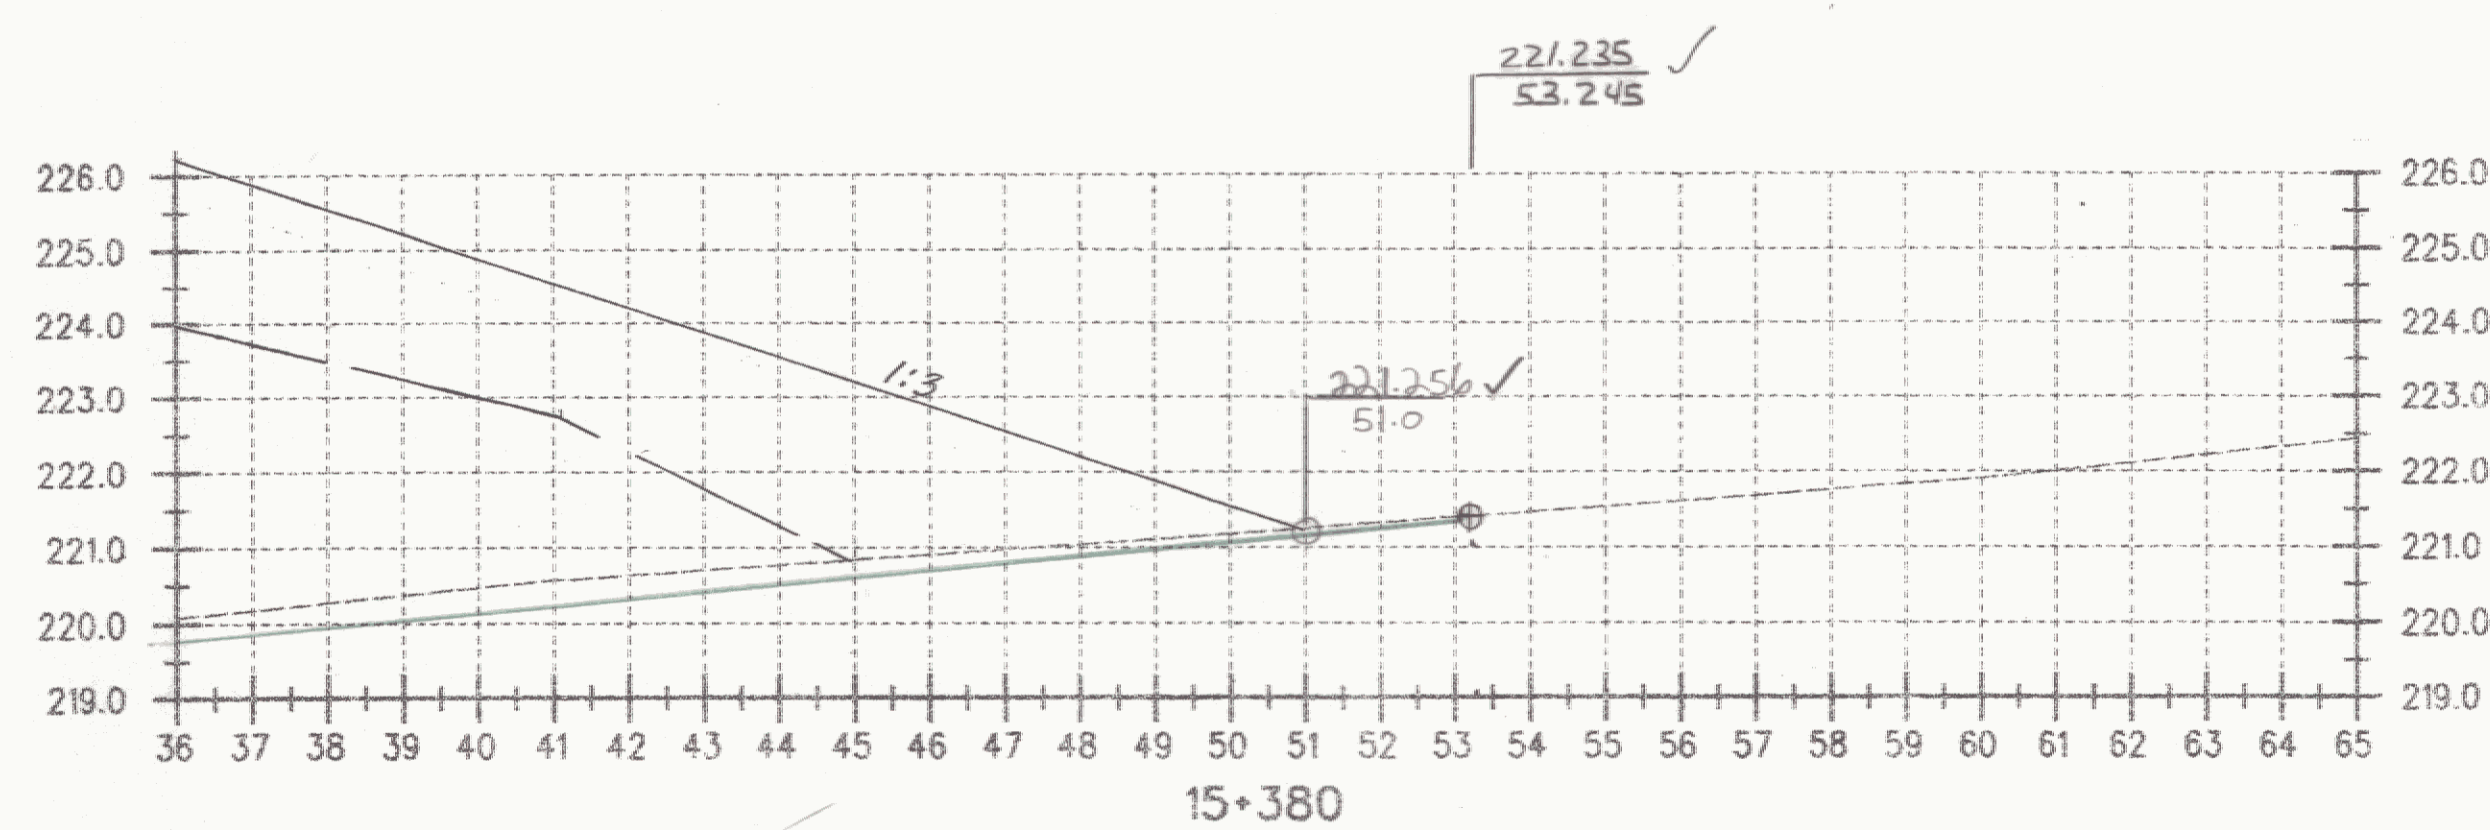

	BY	✓ BY
O.G	11/10/03 GL	RRM 2-11-03
TEMP.		RRM 2-11-03
ELV. + 0/5		RRM 2-11-03

C=0
E=306 362.46m²
R=0

DATUM
VERTICAL NAVD 88
HORIZONTAL NAD 83 (1992)

ALL DIMENSIONS IN MILLIMETERS
EXCEPT AS INDICATED
2 0 2 m
H 1:100
V 1:100

SURVEYED BY C.H.A. & V.S.E. DATE _____
DRAWN BY J.S.L. DATE _____
SQUAD LEADER T.P.K. _____
DESIGN FILE NO. N/A _____
IPARM FILE _____ DATE PLOTTED _____
PROJ. NAME BENNINGTON - HOOSICK D.P.I. 0146(1) C13
PROJ. NO. P.I.N. 1306.60.101
SHEET 422 OF 473 SHEETS