


SEE REVISED CROSS SECTION,  
SHEET 7 OF 8, IN THE  
"SIGHT BERM GRADING PLAN" SET.  
RMT 2/10/06

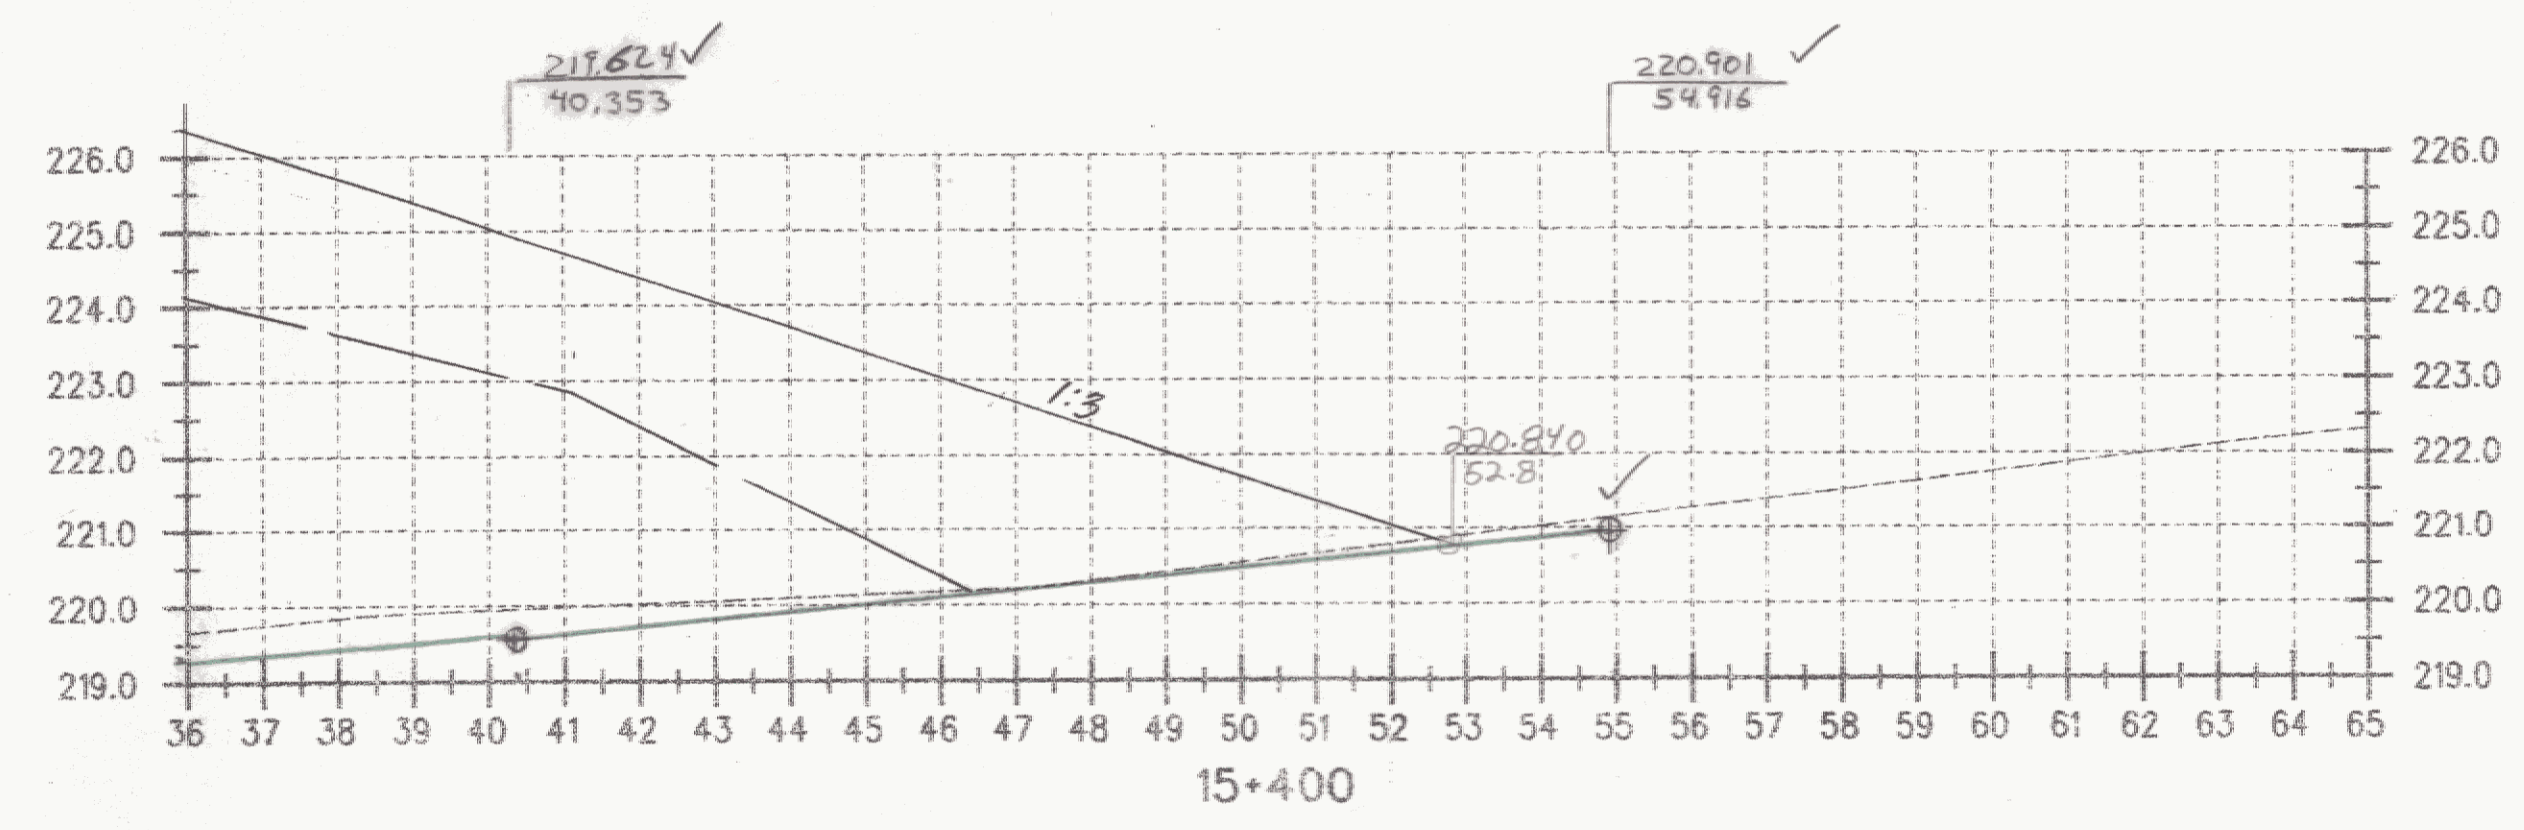

	BY	✓ BY
OG	BL 11/14/03	RRM 2-11-03
TEMP		RRM 2-11-03
ELV. + 0/s		

RMT 2/10/06

C=0  
E=392 419.30m<sup>2</sup>  
R=0

DATUM	
VERTICAL	NAVD 88
HORIZONTAL	NAD 83 (1992)

ALL DIMENSIONS IN MILLIMETERS  
EXCEPT AS INDICATED

2 0 2 m

H 1:100  
V 1:100

SURVEYED BY	C.H.A. & V.S.E.	DATE	
DRAWN BY	J.S.L.	DATE	
SQUAD LEADER	T.P.K.		
DESIGN FILE NO.	N/A		
IPARM FILE		DATE PLOTTED	
PROJ. NAME	BENNINGTON - HOOSICK		
	D.P.I. 0146(1) C13		
PROJ. NO.	P.I.N. 1306.60.101		
SHEET	423 OF 473 SHEETS		