
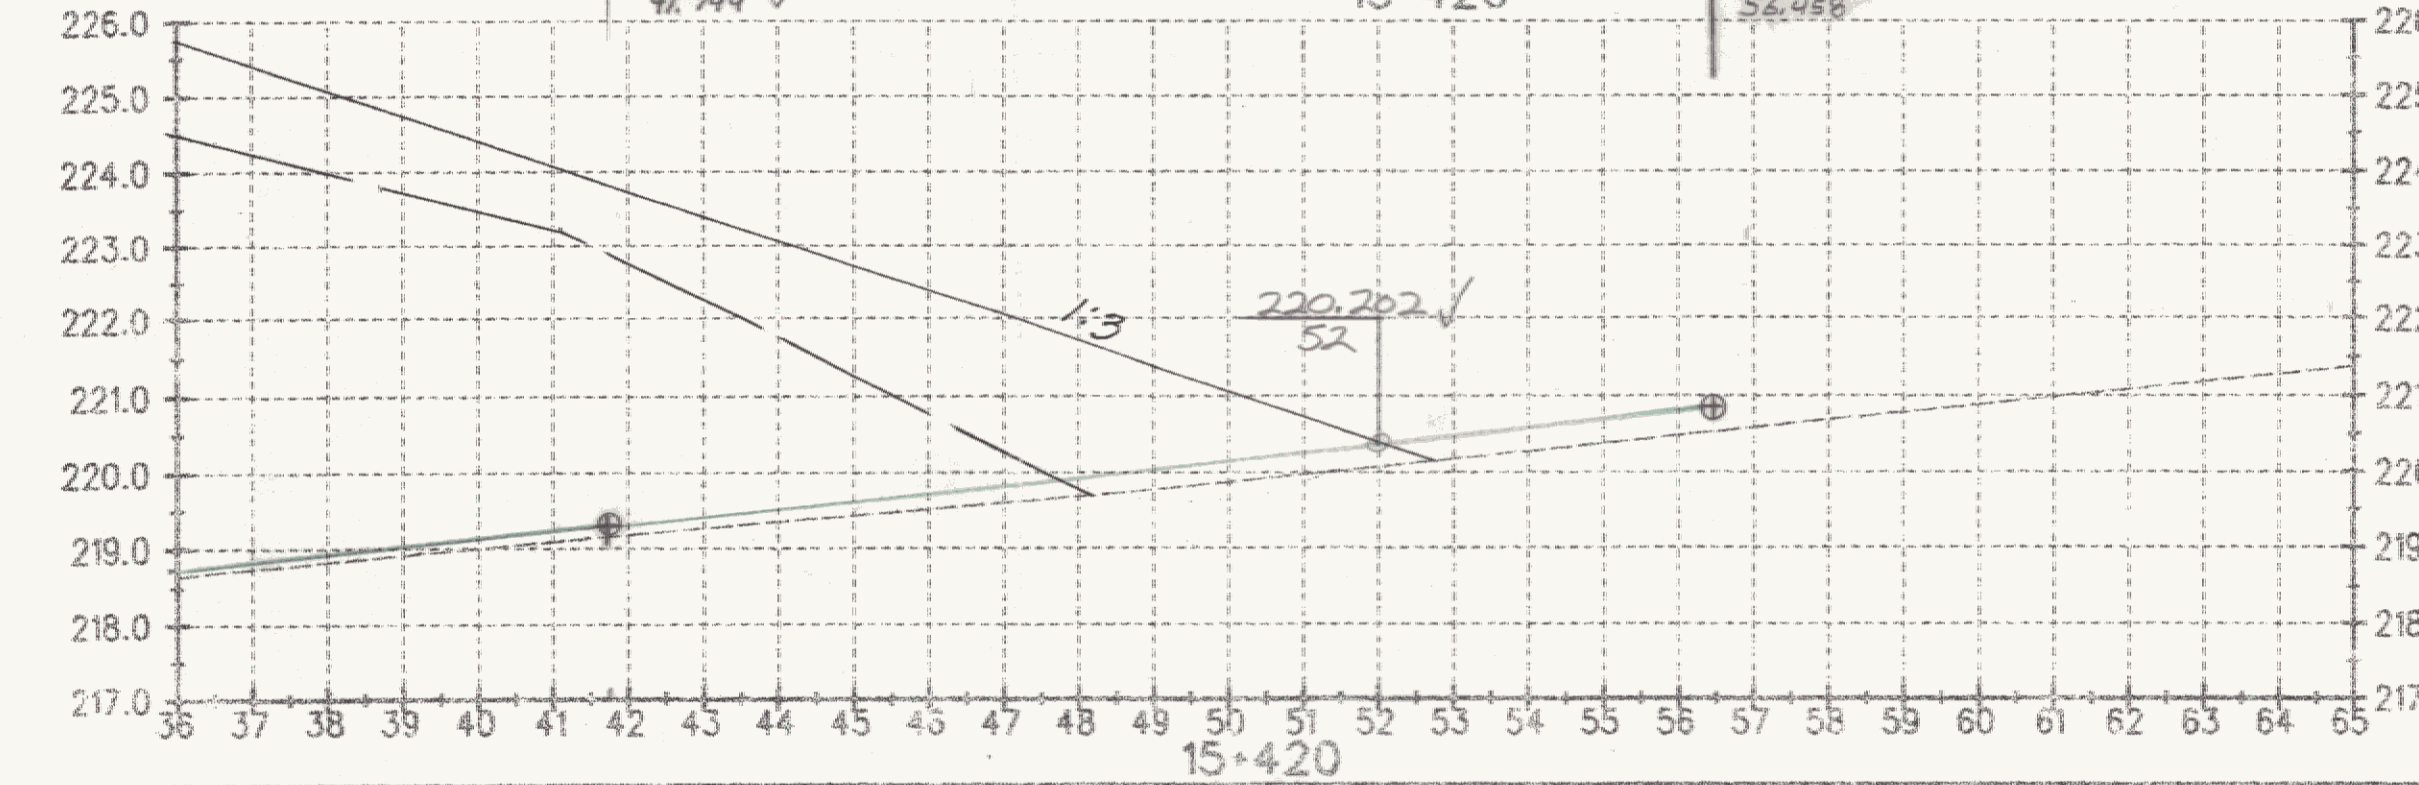


C=0
 F=350 344.12m²
 R=0

SEE REVISED CROSS SECTIONS,
 SHEET 7 & 8 OF 8, IN THE
 "SIGHT BERM GRADING PLAN" SET.
 RMT 2/6/06

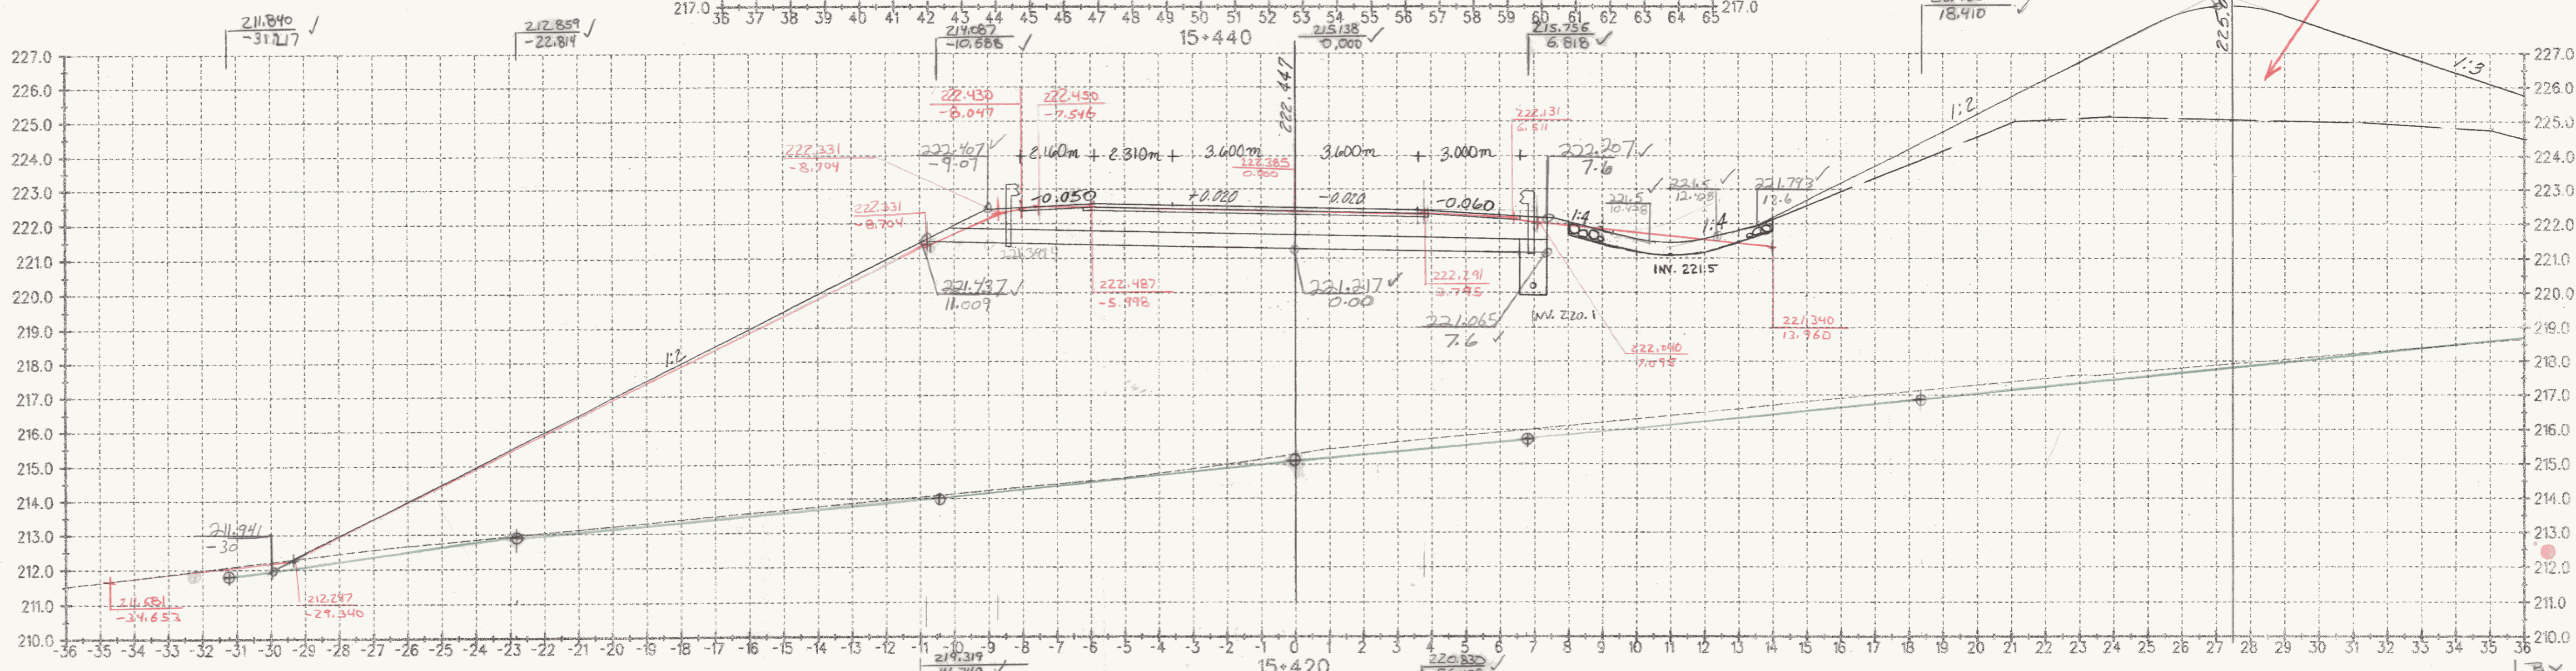

C=0
 F=460 459.12m²
 R=0

Metric

DATUM
 VERTICAL NAVD 88
 HORIZONTAL NAD 83 (1992)

ALL DIMENSIONS IN MILLIMETERS
 EXCEPT AS INDICATED

2 0 2 m

H 1:100
 V 1:100

SURVEYED BY C.H.A. & V.S.E. DATE _____
 DRAWN BY J.S.L. DATE _____
 SQUAD LEADER T.P.K.
 DESIGN FILE NO. N/A

PARM FILE _____ DATE PLOTTED _____

PROJ. NAME BENNINGTON - HOOSICK
 D.P.I. 0146(1) C/3
 PROJ. NO. P.I.N. 1306.60.201
 SHEET 424 OF 473 SHEETS