




N=80
 N=84
 N=53
 N=71
 671m BOD
 B-476
 STA 15+480
 VIS A-6 GRS SCL
 M BRN-GRY STIFF-V.HARD

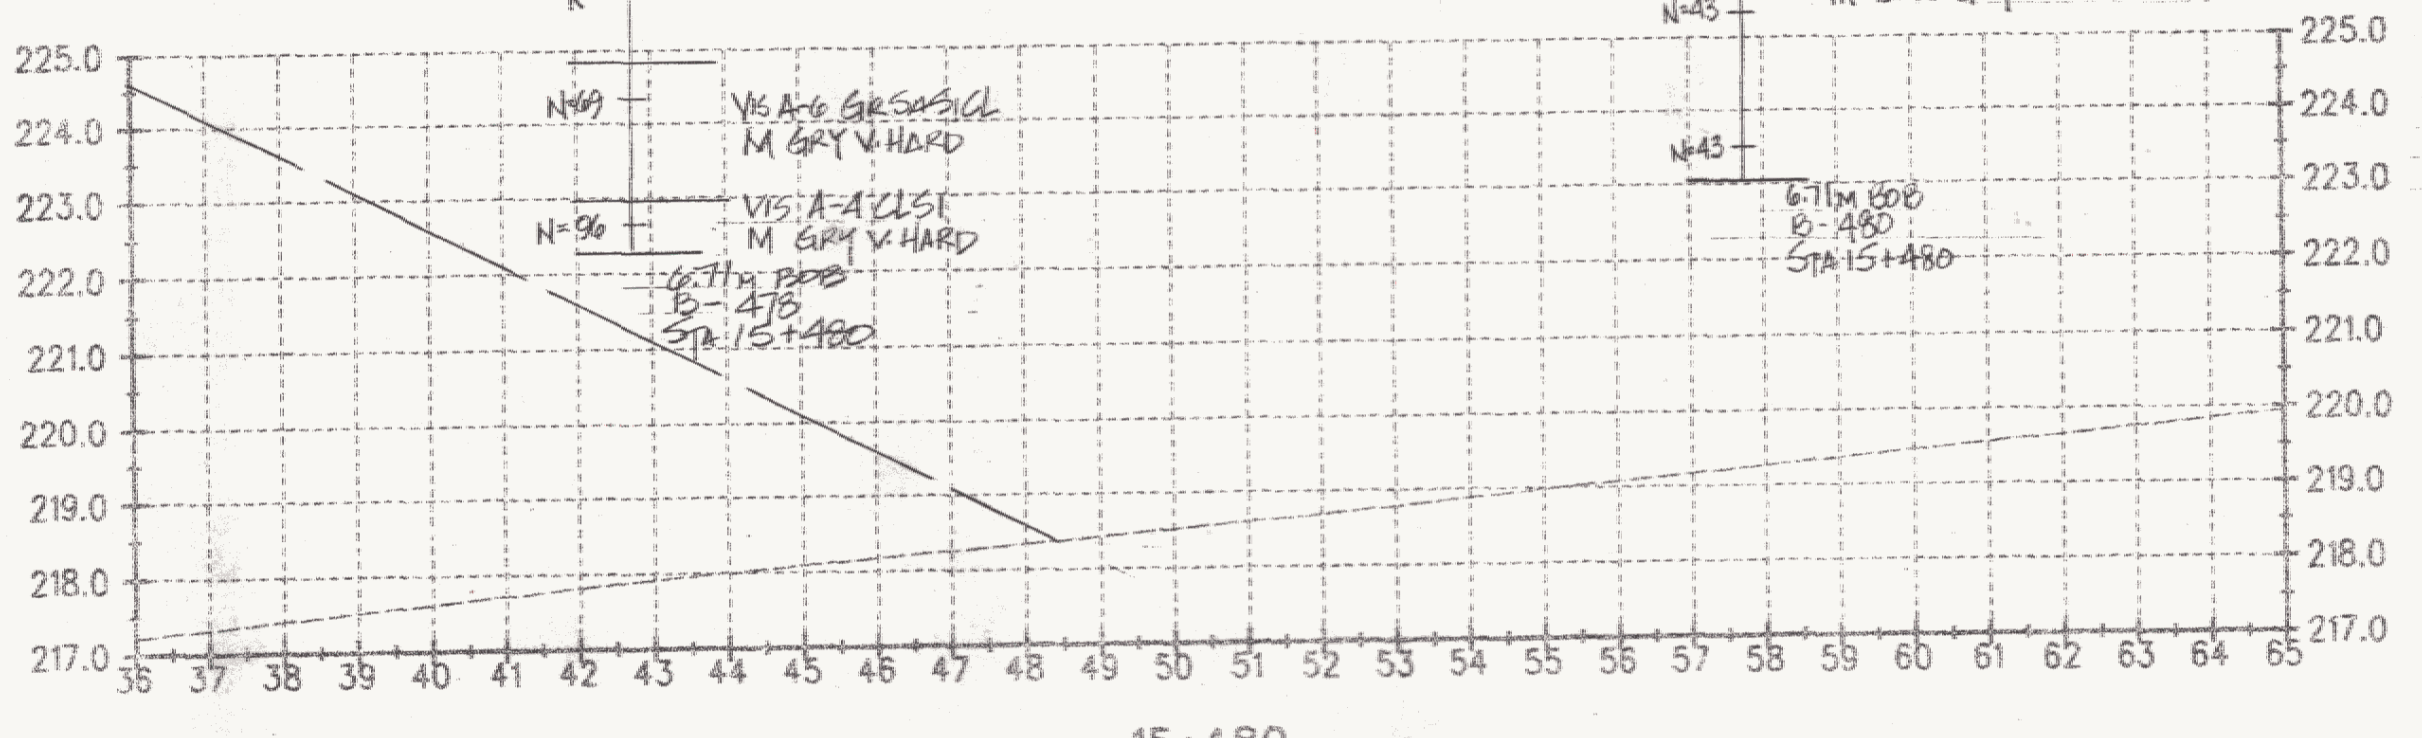

SEE REVISED CROSS SECTION,
 SHEET 8 OF 8, "A-THE"
 "SIGHT BERM GRADING PLAN" SET
 RMT 2/6/06
 NO SURVEY DATA
 PROVIDED @ BERM
 RMT 2/6/06

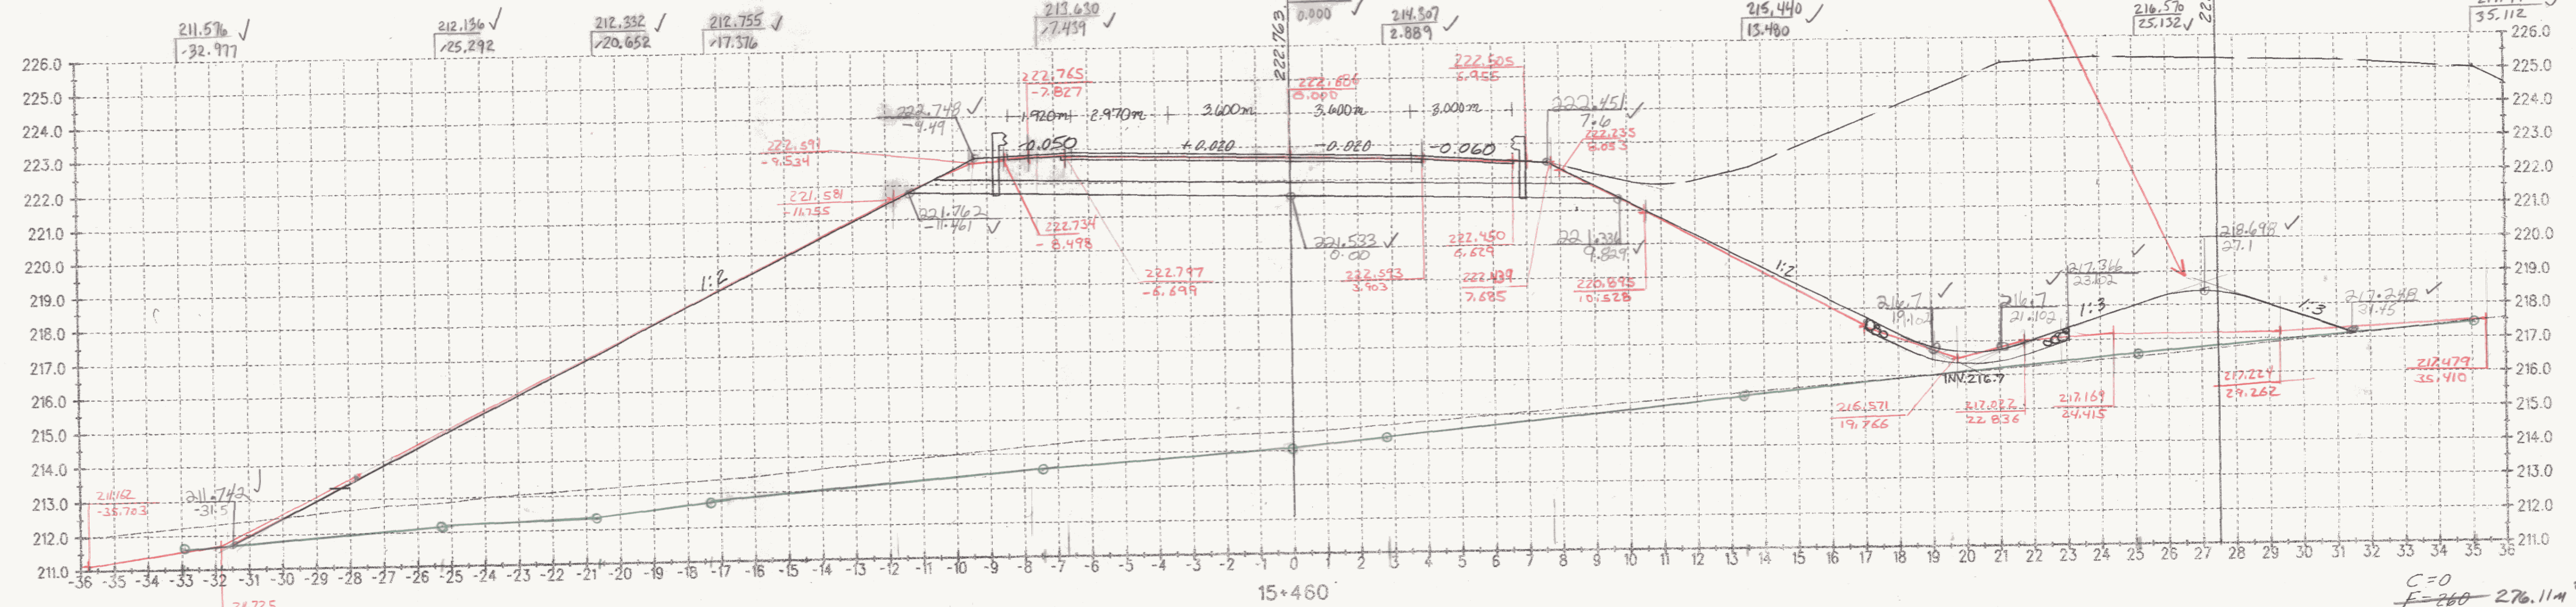

212.725
 -31.848

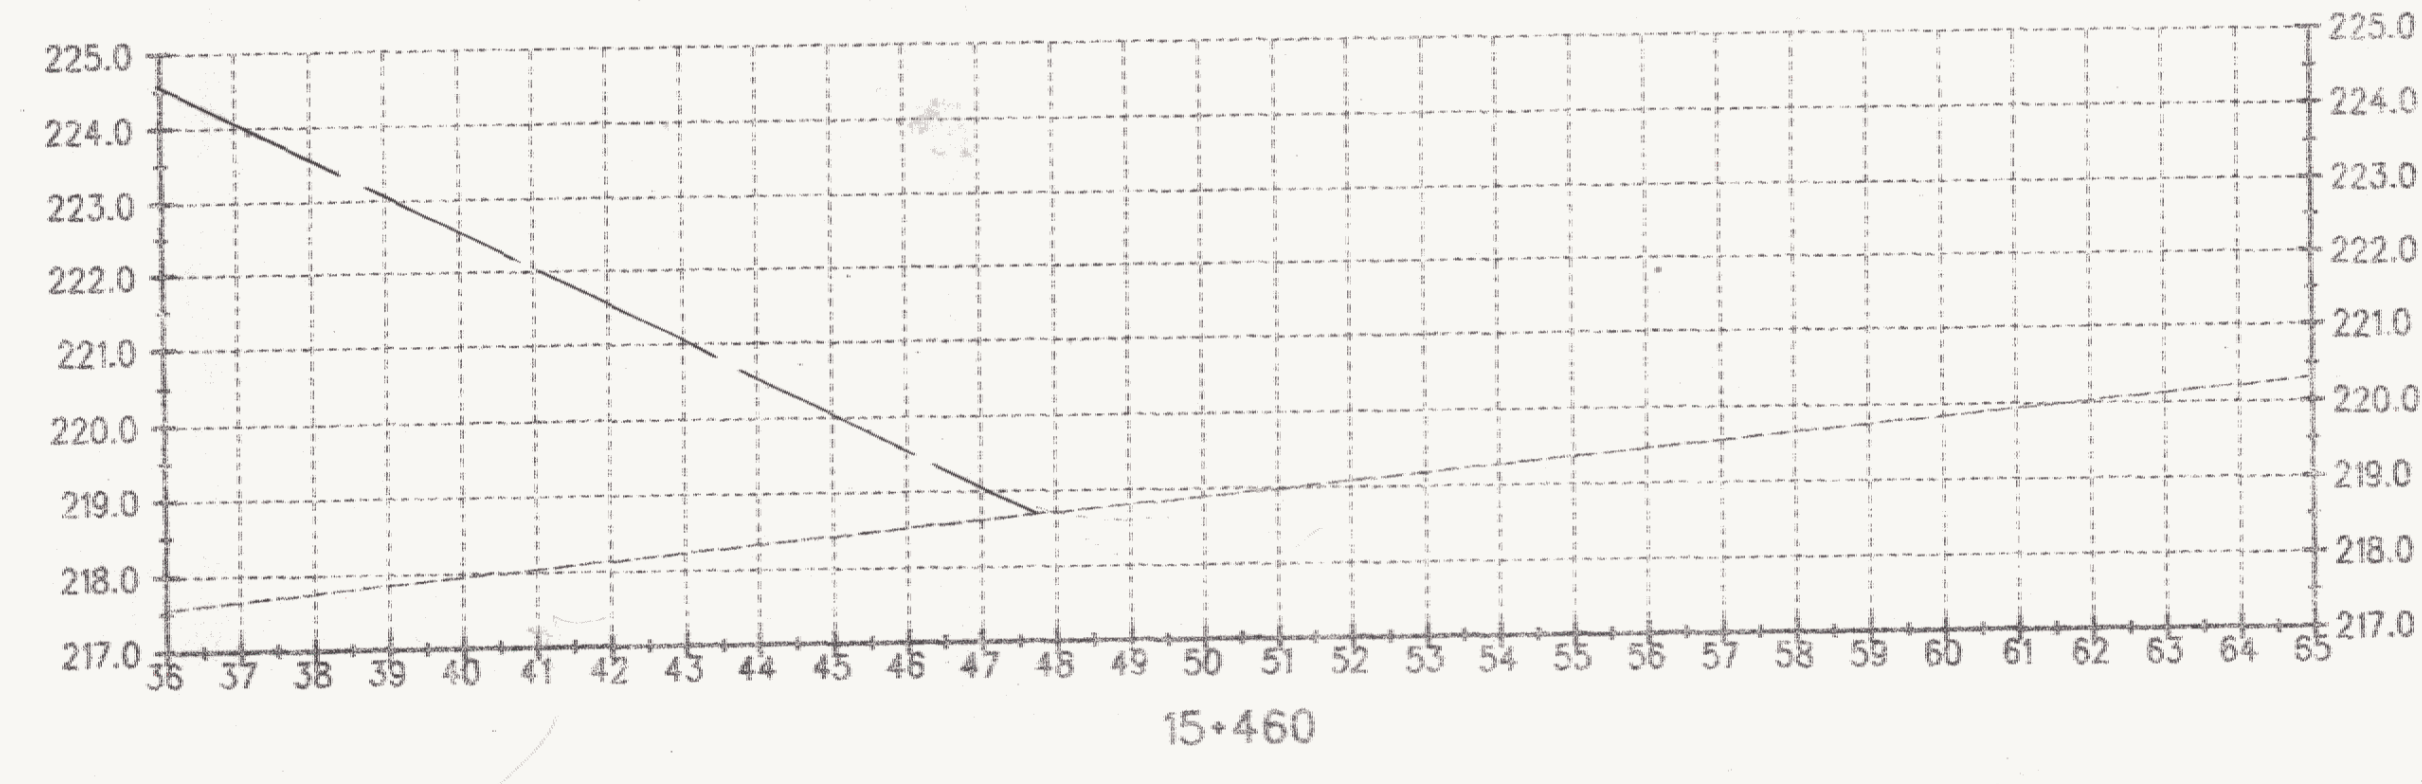

DATUM
 VERTICAL NAVD 88
 HORIZONTAL NAD 83 (1992)

Both Sect's	BY	V BY
DRAWN BY:	DH	R.R.M
O.G.	1/14/03	2-11-03
TEMP.	DH	RRM
Elev. + o/s	1/14/03	2-11-03
F.G.	BL 1/25/03	1/15/10



ALL DIMENSIONS IN MILLIMETERS
 EXCEPT AS INDICATED
 2 0 2 m
 H 1:100
 V 1:100

SURVEYED BY C.H.A. & V.S.E. DATE
 DRAWN BY J.S.L. DATE
 SQUAD LEADER T.P.K.
 DESIGN FILE NO. N/A
 IPARM FILE DATE PLOTTED
 PROJ. NAME BENNINGTON - HOOSICK
 D.P.I. 0146(1) C/3
 PROJ. NO. P.I.N. 1306.60.201
 SHEET 425 OF 473 SHEETS