

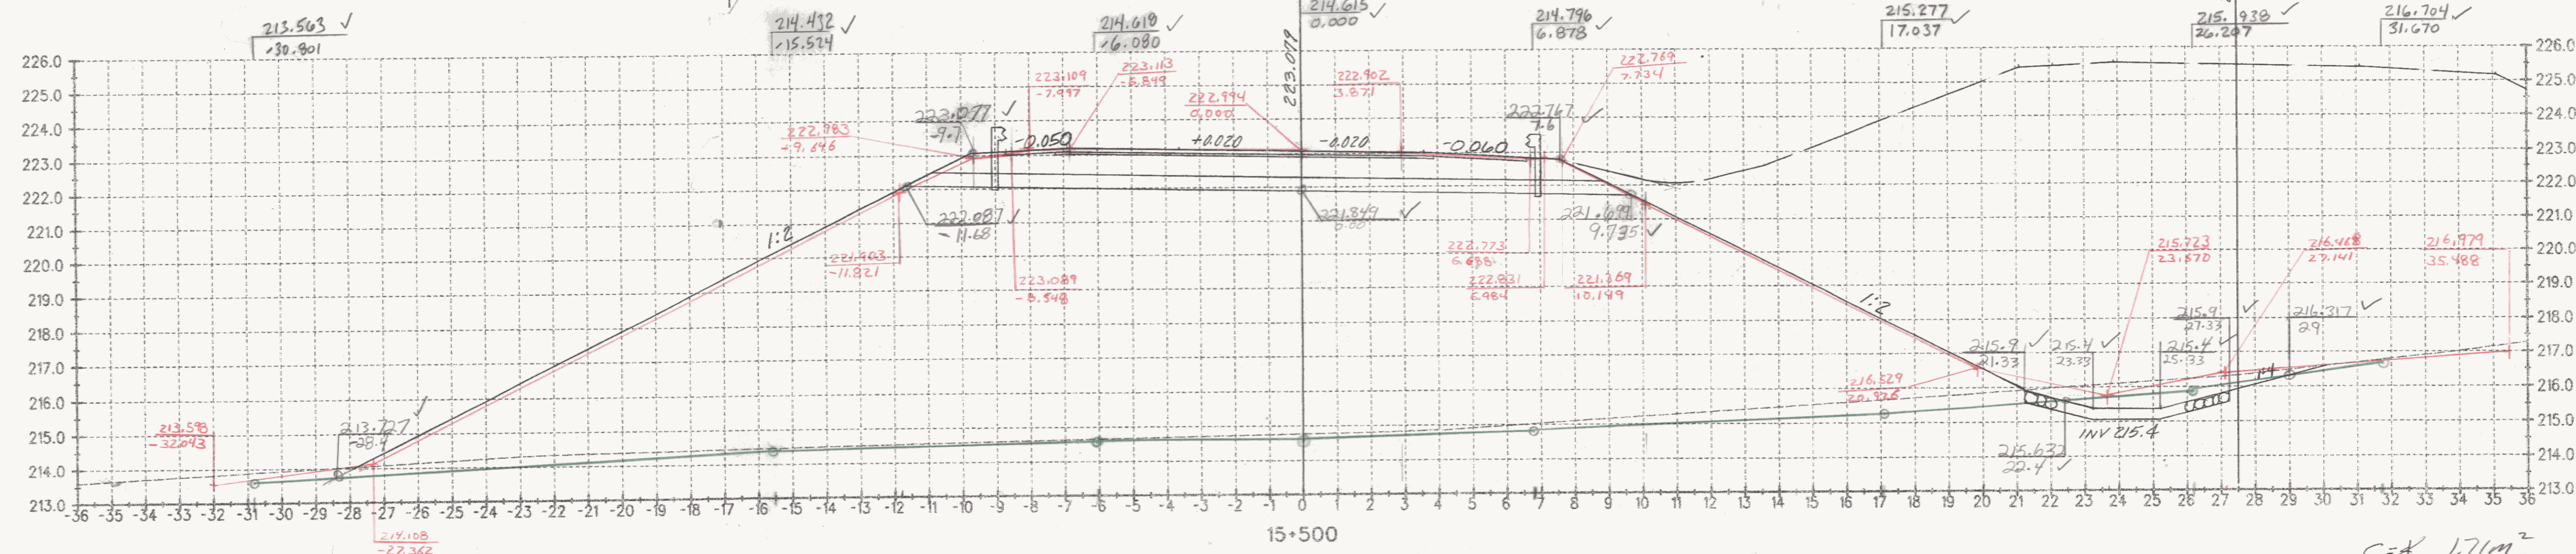


C=0
 F=202-197.95M
 R=0

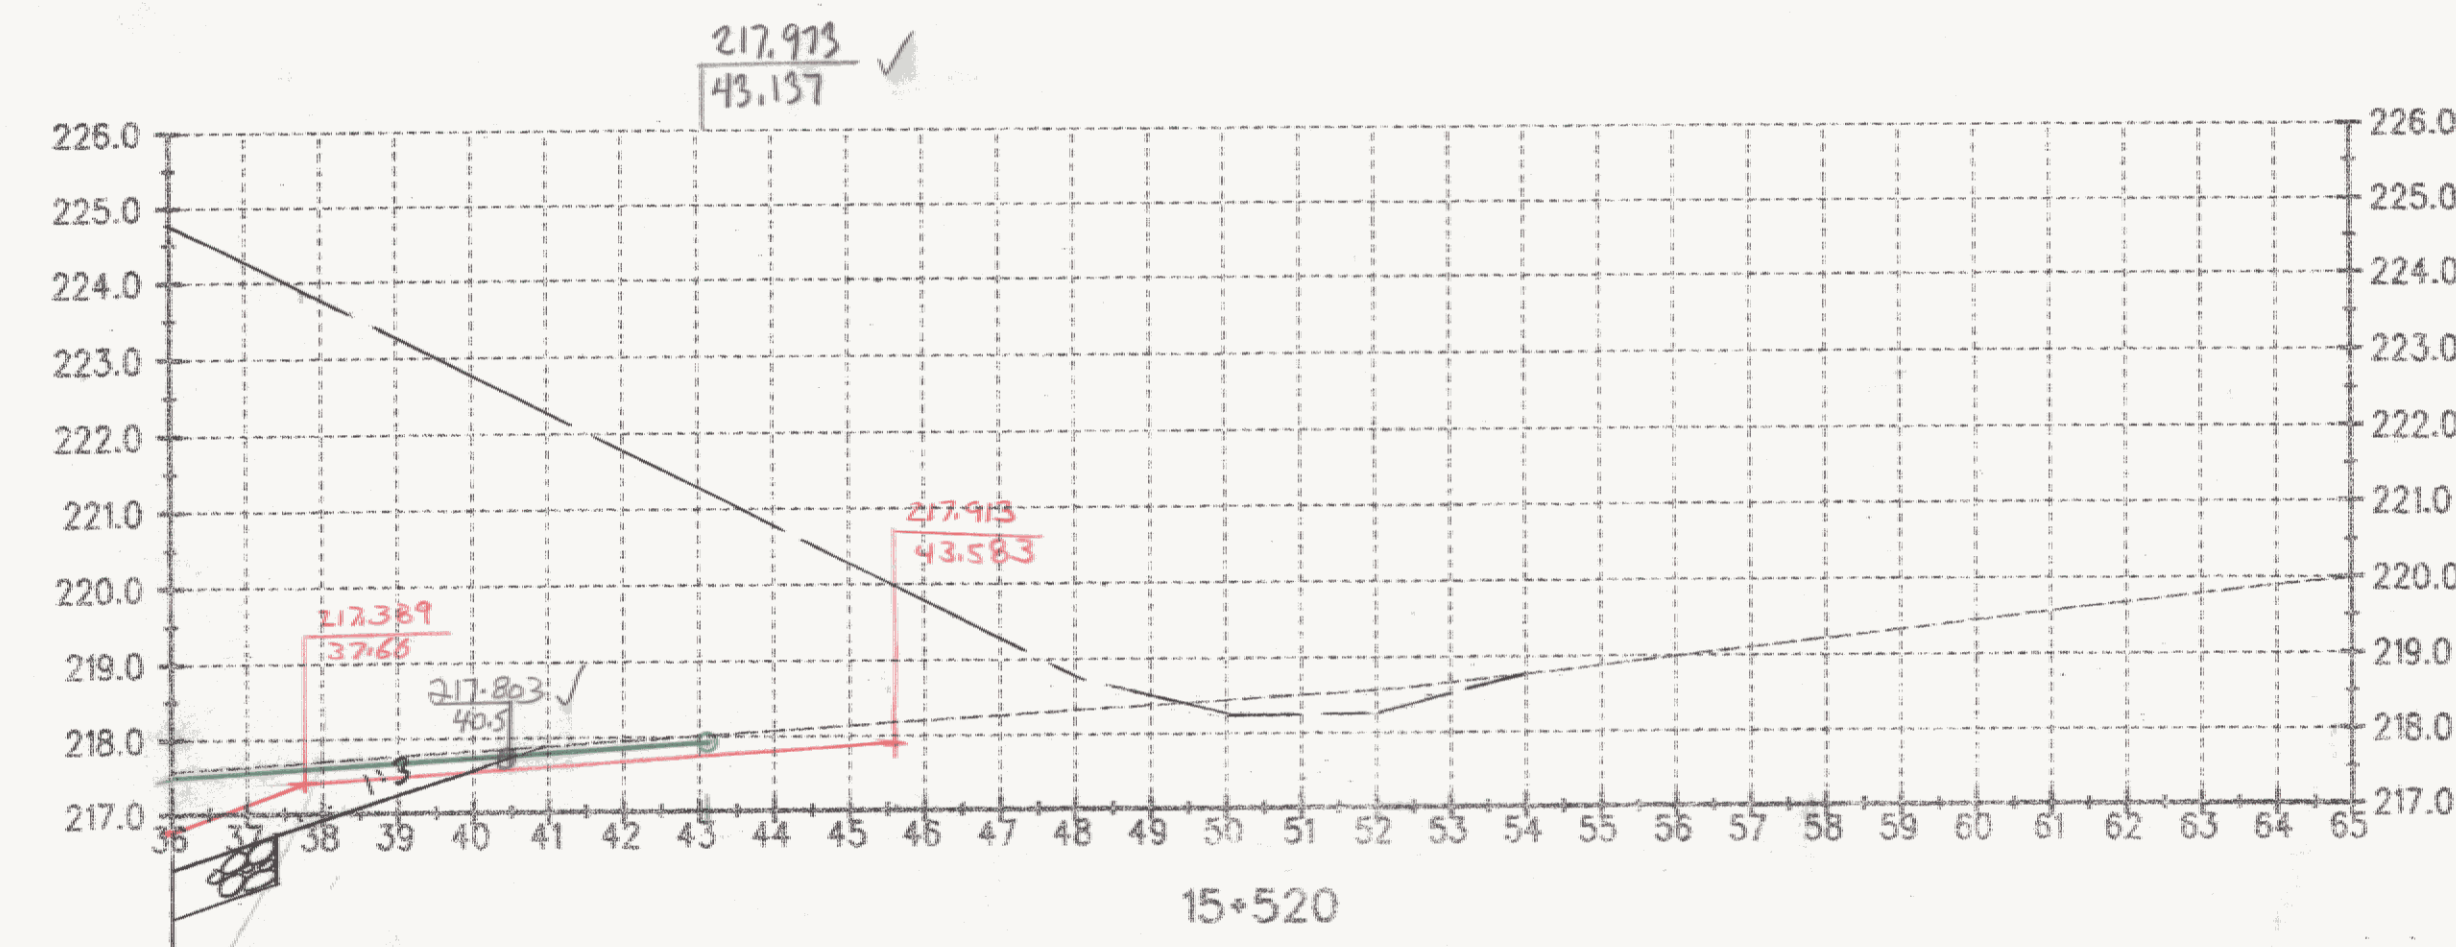

C=1.71M²
 F=246-258.70M²
 R=0

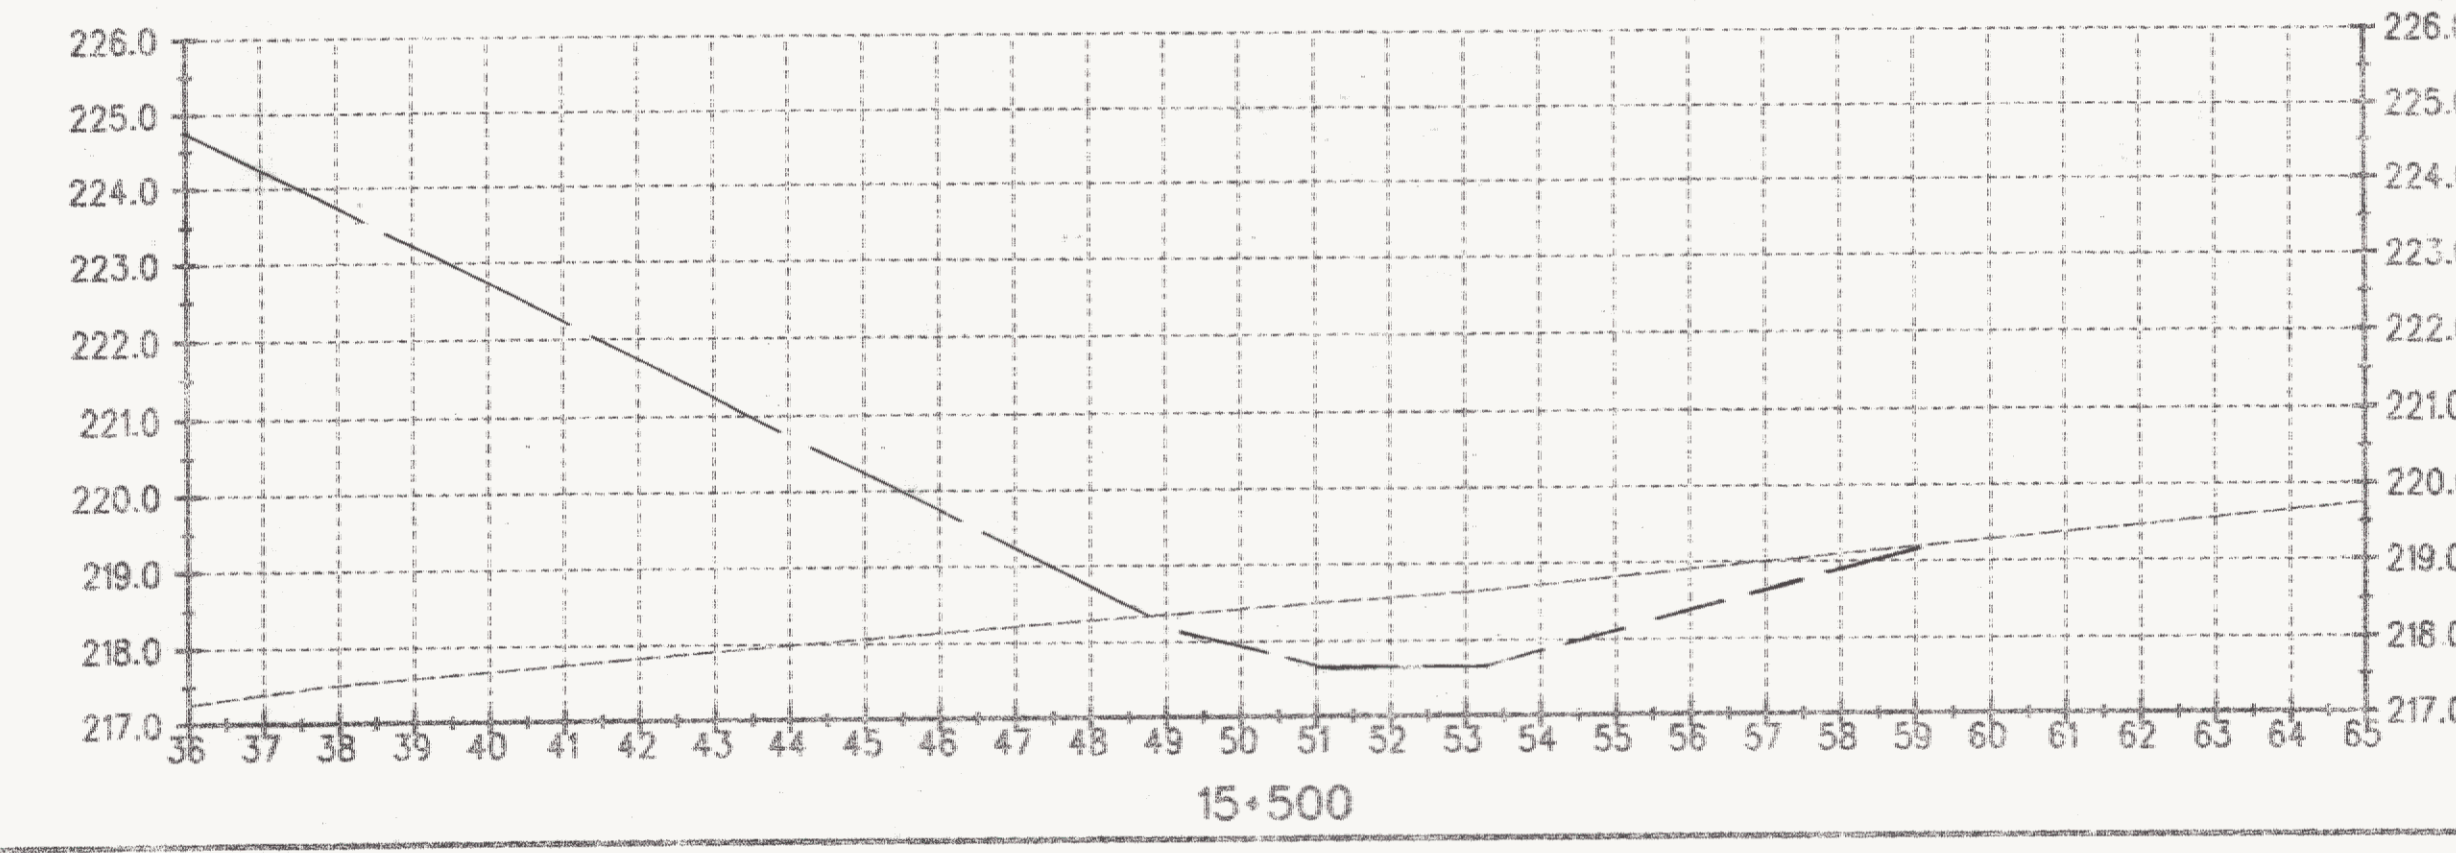

DATUM
 VERTICAL NAVD_88
 HORIZONTAL NAD 83 (1992)

Both Sect's	By	✓ By
O.G.	DH 1/14/03	RRM 2-11-03
TEMP. ELV. ± 0/5	DH 1/14/03	RRM 2-11-03
F.G.	BC 1/25/05	Supv 1/25/05

ALL DIMENSIONS IN MILLIMETERS EXCEPT AS INDICATED
 2 0 2 m
 H 1:100
 V 1:100



SURVEYED BY C.H.A. & V.S.E. DATE
 DRAWN BY J.S.L. DATE
 SQUAD LEADER T.P.K.
 DESIGN FILE NO. N/A
 I/PARM FILE DATE PLOTTED
 PROJ. NAME BENNINGTON - HOOSICK
 D.P.I. 0146(1) c/3
 PROJ. NO. P.I.N. 1306.60.201
 SHEET 427 OF 473 SHEETS