

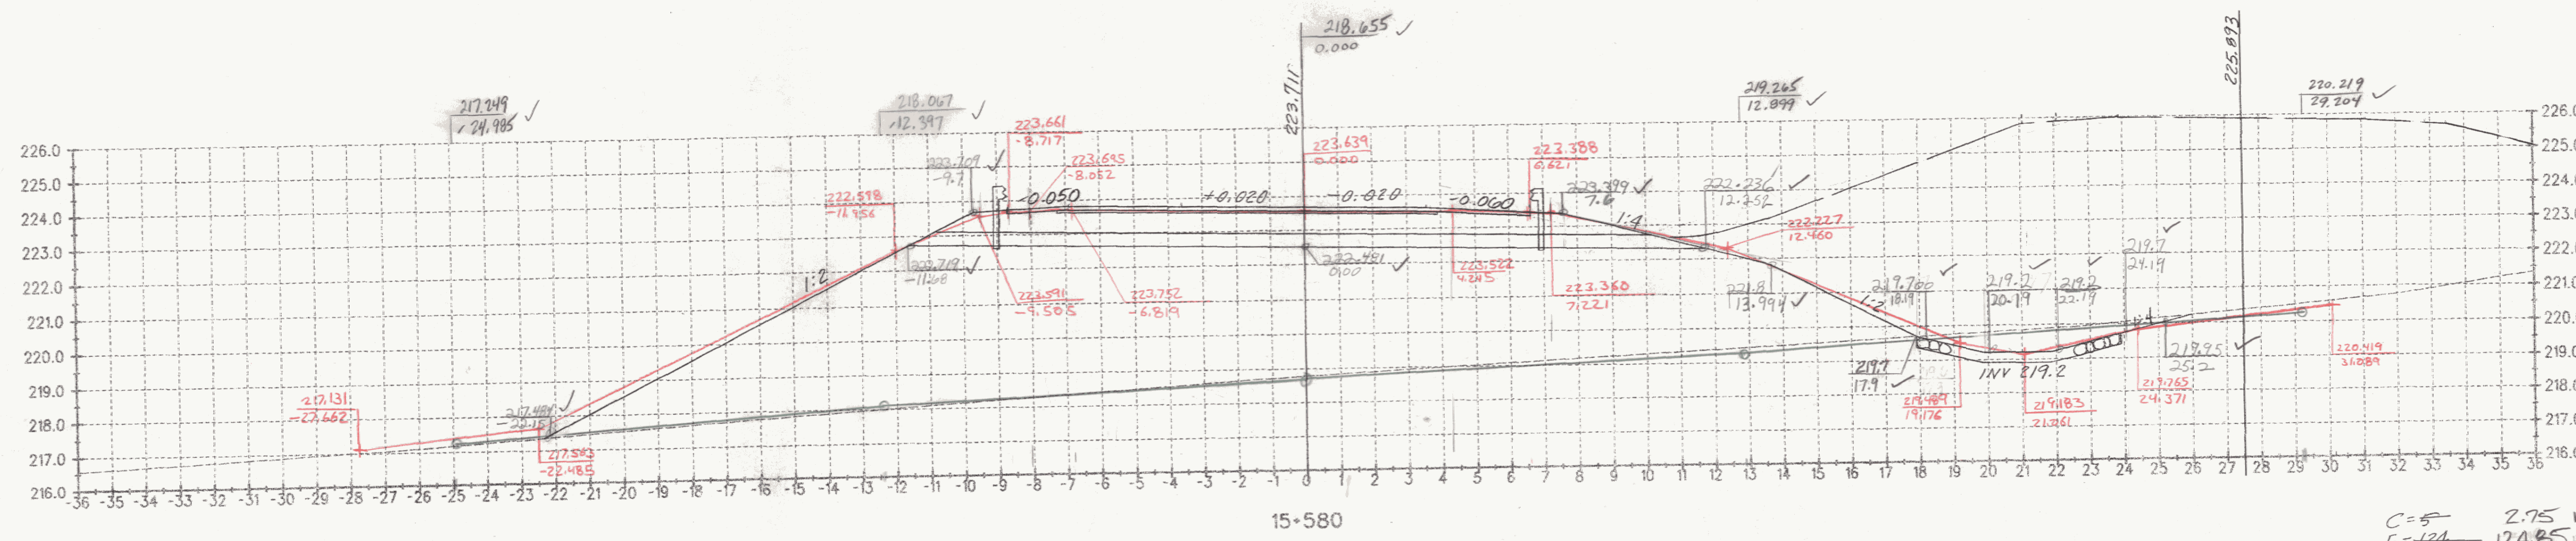


C=15 6.65M²
 F=100 107.75M
 R=0

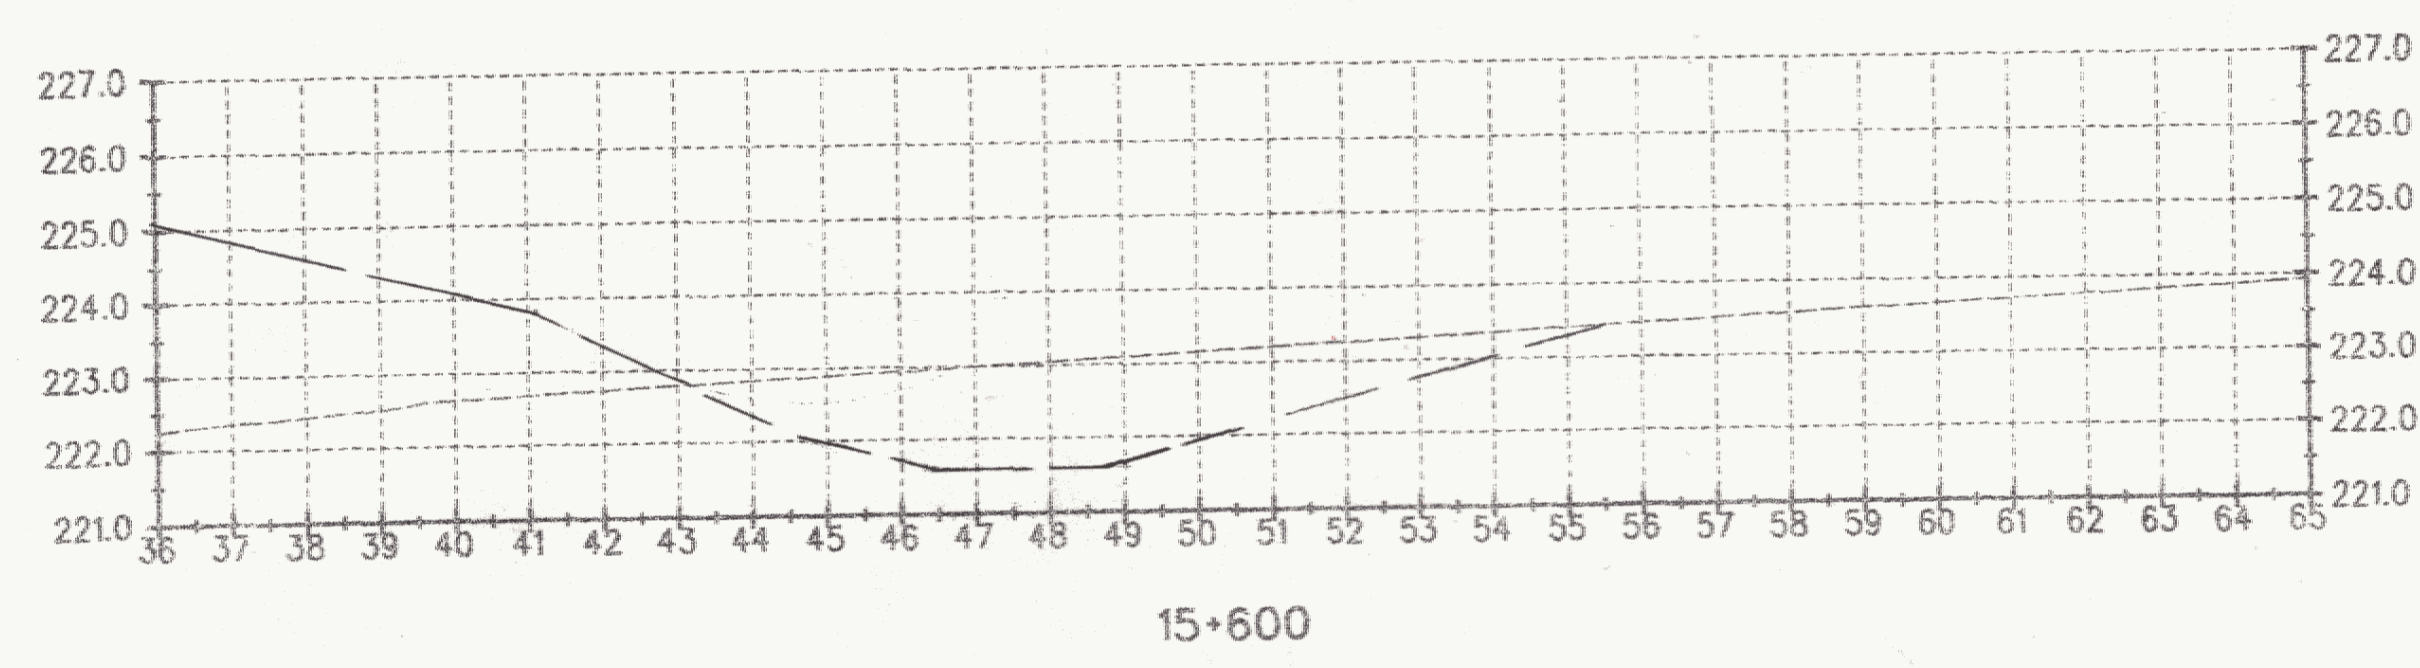

C=5 2.75 M²
 F=124 124.85 M
 R=0

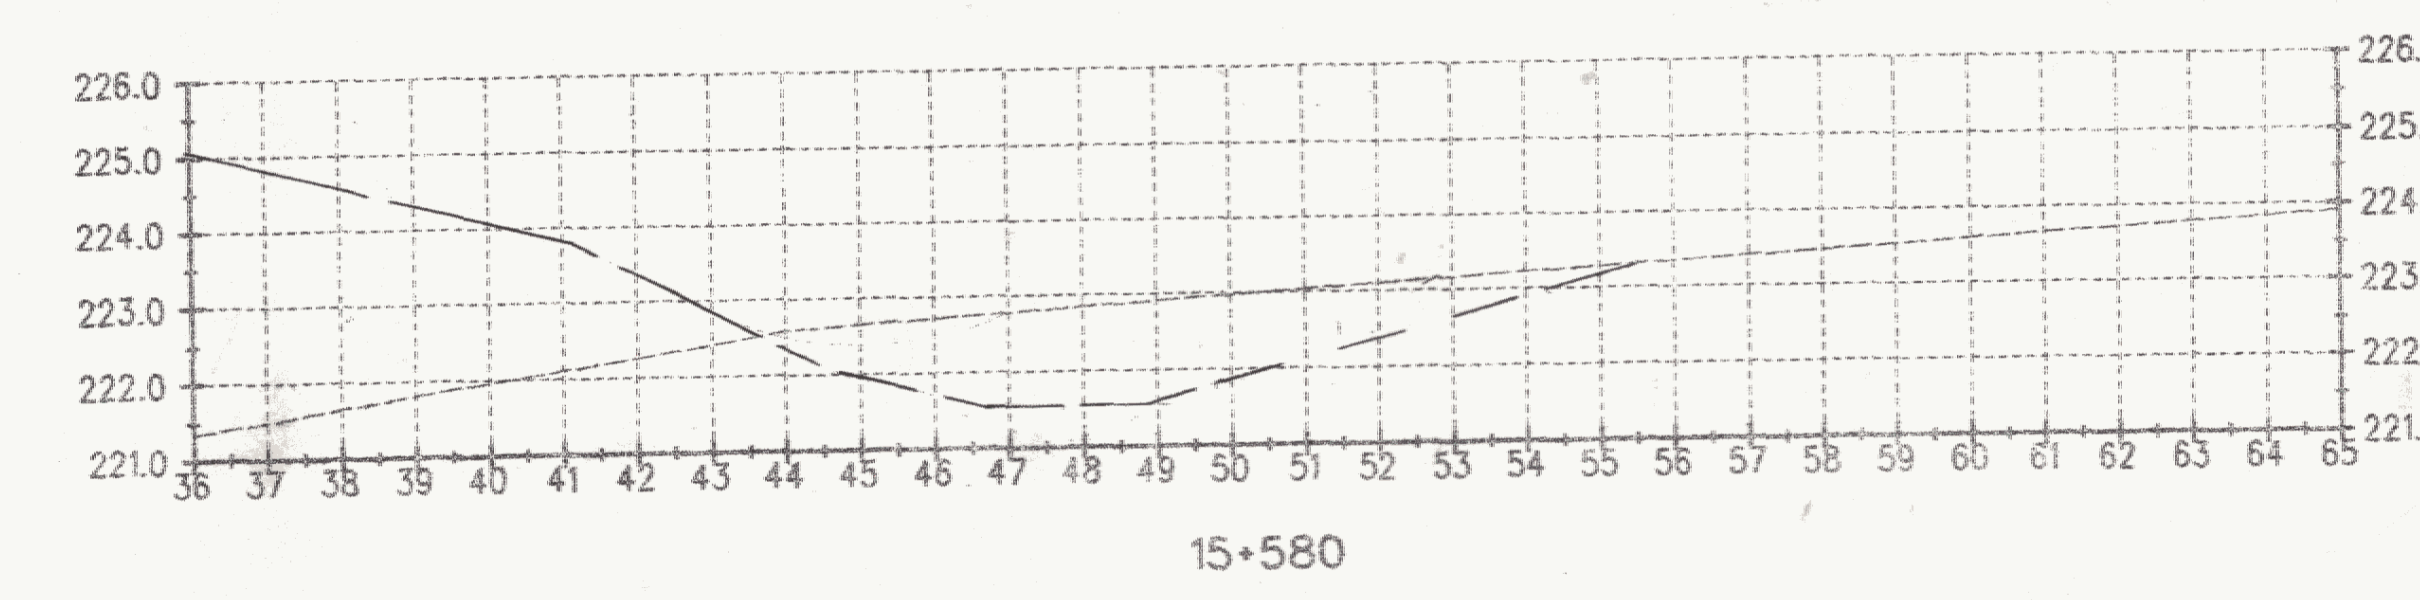

DATUM
 VERTICAL NAVD 88
 HORIZONTAL NAD 83 (1992)

BOTH SECT'S	By	V By
O.G.	DH	RRM
TEMP.	DH	RRM
ELV. + O/S	1/14/03	2/11/03
FIG.	BL 1/27/05	4/17/05

ALL DIMENSIONS IN MILLIMETERS EXCEPT AS INDICATED

2 0 2 m

H 1:100
 V 1:100

Metric

SURVEYED BY C.H.A. & V.S.E. DATE
 DRAWN BY J.S.L. DATE
 SQUAD LEADER T.P.K.
 DESIGN FILE NO. N/A

DATE PLOTTED
 PROJ. NAME BENNINGTON - HOOSICK
 D.P.I. 0146(1) C/3
 PROJ. NO. P.I.N. 1306.60.201
 SHEET 429 OF 473 SHEETS