



C=12 11.08m²
 F=106 99.52m²
 R=0

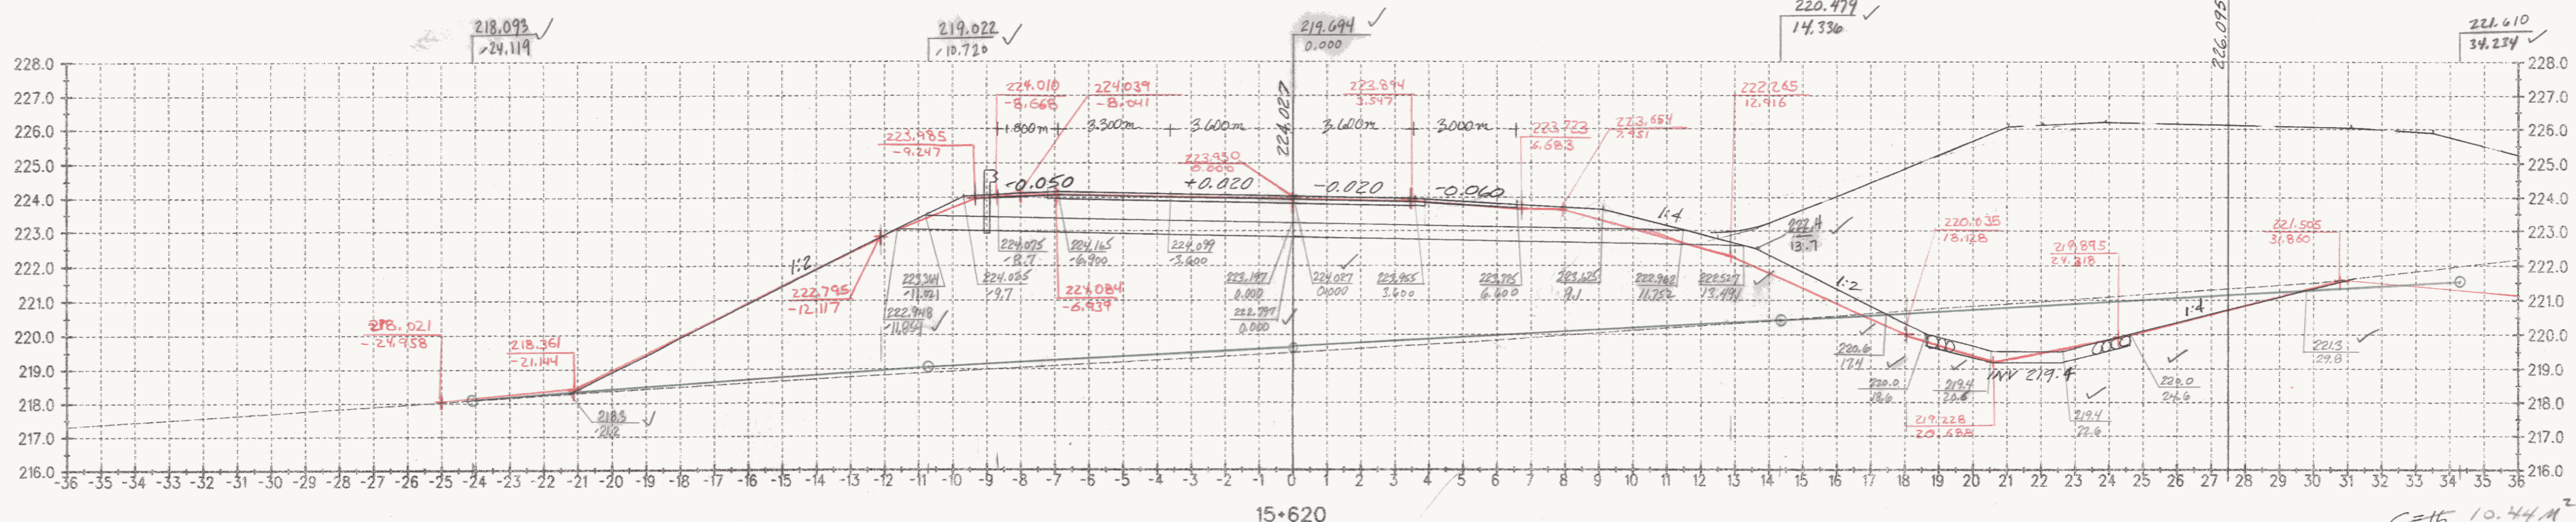

C=16 10.44m²
 F=106 99.84m²
 R=0

DATUM
 VERTICAL NAVD 88
 HORIZONTAL NAD 83 (1992)

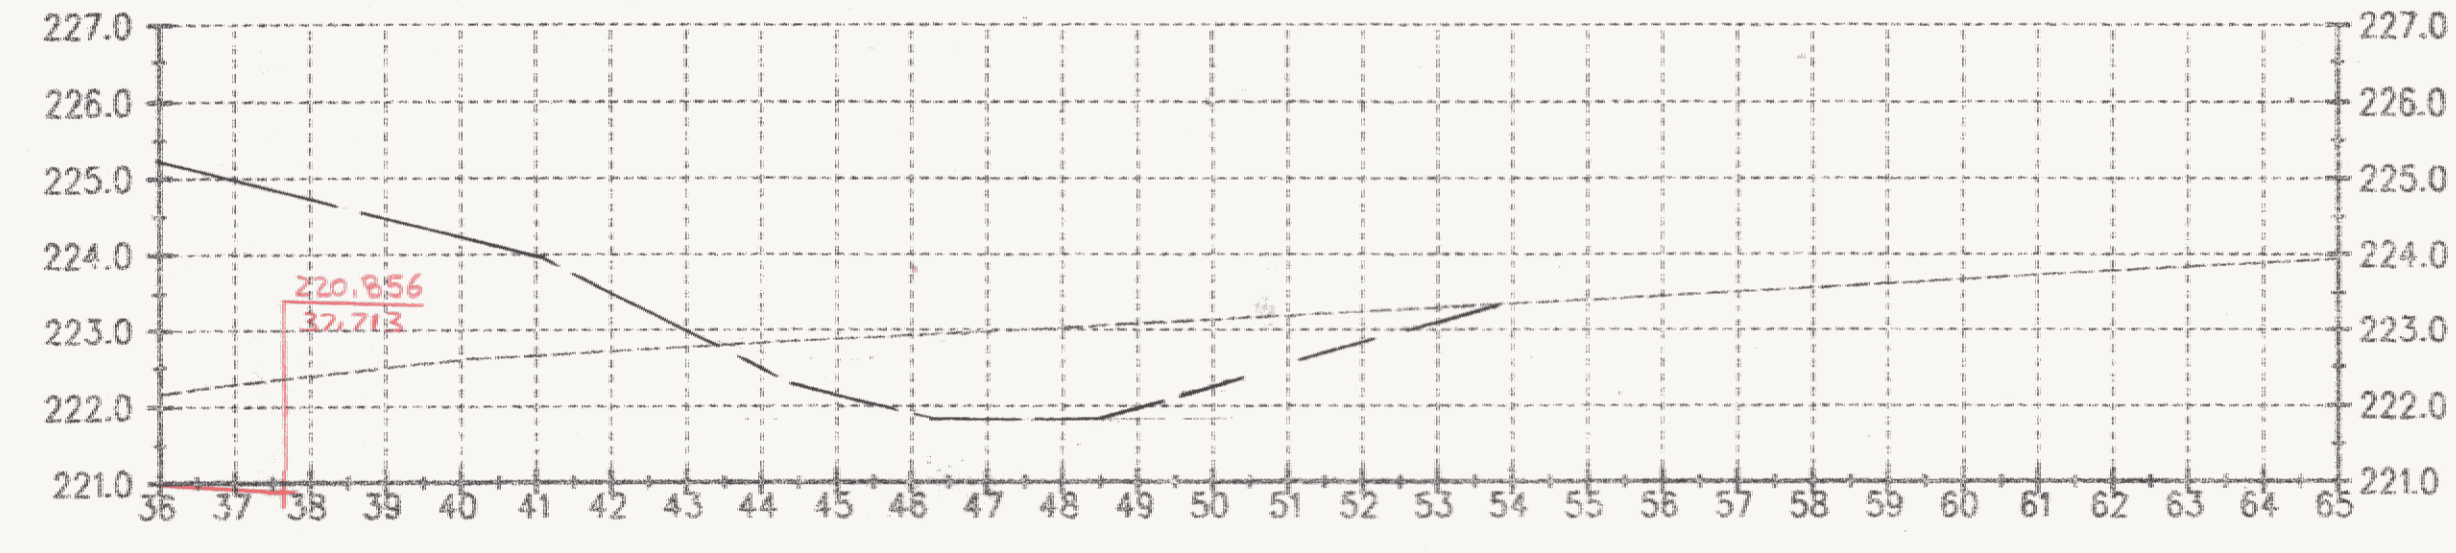

Both Sect's BY ✓ BY
 O.G. DH 11/1/03 RRM
 2-11-03
 TEMP. DH 1/14/03 RRM
 ELV. + o/s 1/14/03 RRM
 FG al 1/27/05 ✓
 ✓
 ✓



ALL DIMENSIONS IN MILLIMETERS EXCEPT AS INDICATED
 2 0 2 m
 H 1:100
 V 1:100
 SURVEYED BY C.H.A. & V.S.E. DATE
 DRAWN BY J.S.L. DATE
 SQUAD LEADER T.P.K.
 DESIGN FILE NO. N/A
 PARM FILE DATE PLOTTED
 PROJ. NAME BENNINGTON - HOOSICK
 D.P.I. 0146(1) C/3
 PROJ. NO. P.I.N. 1306.60.201
 SHEET 430 OF 473 SHEETS