
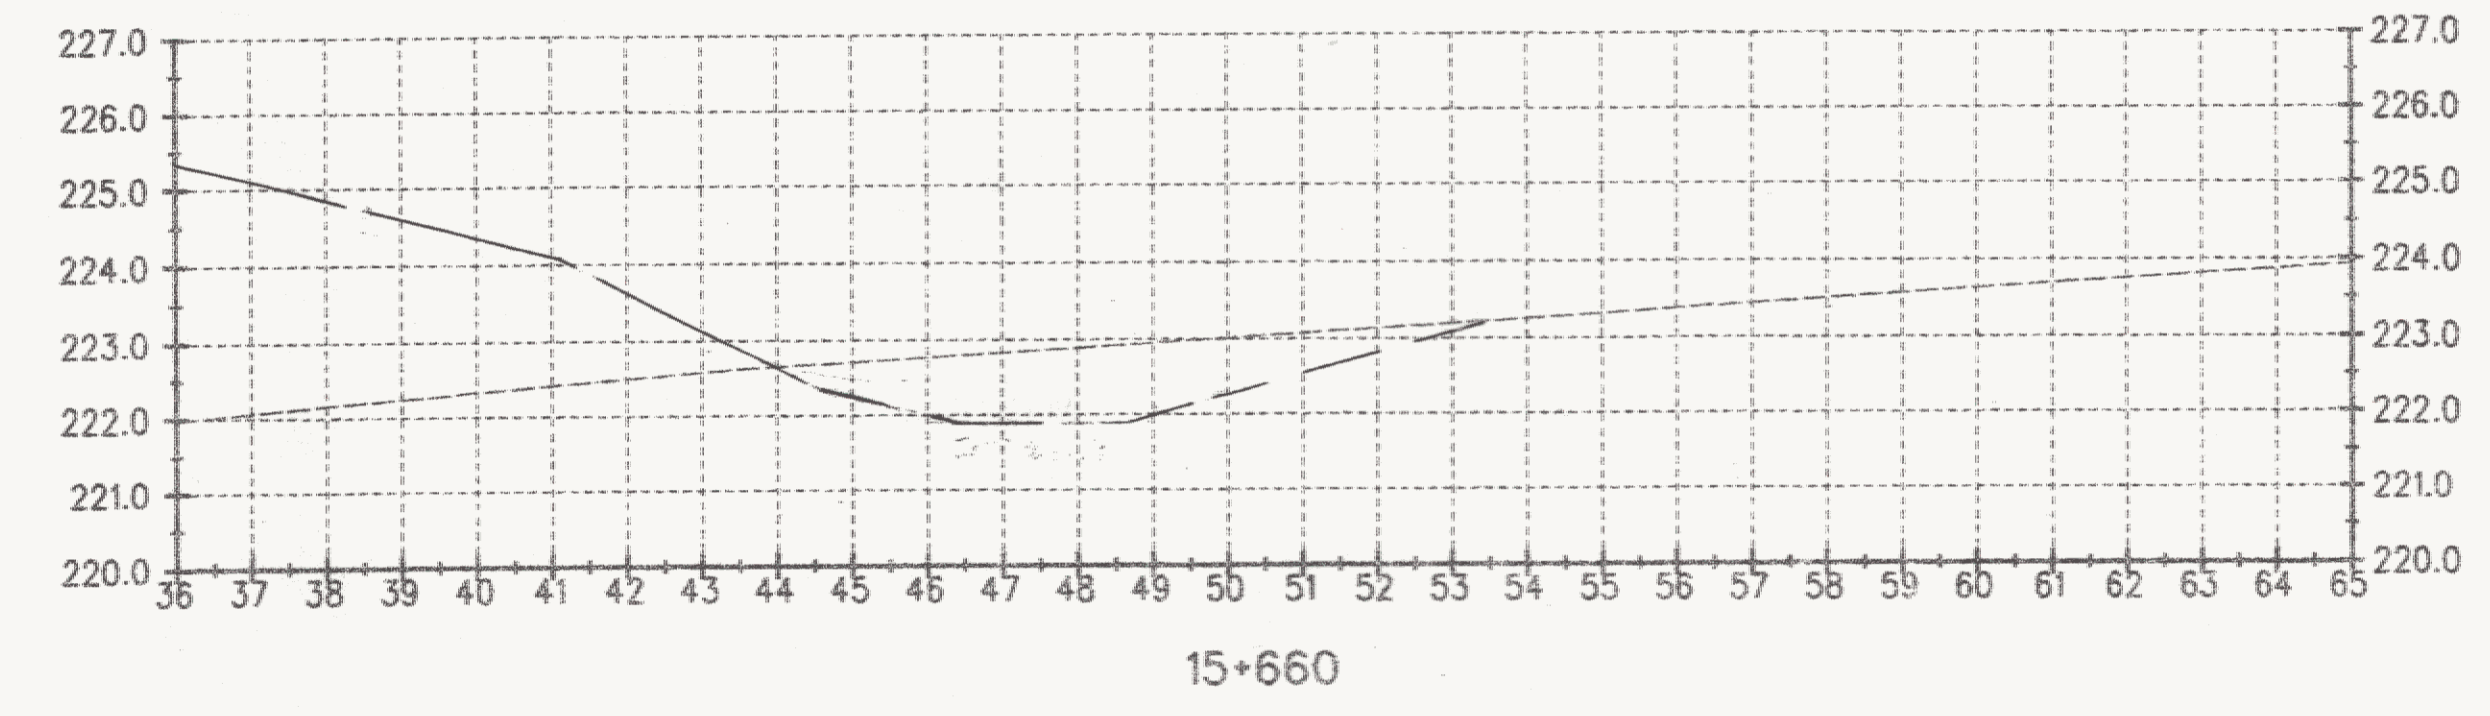



C=10  
E=117  
R=0

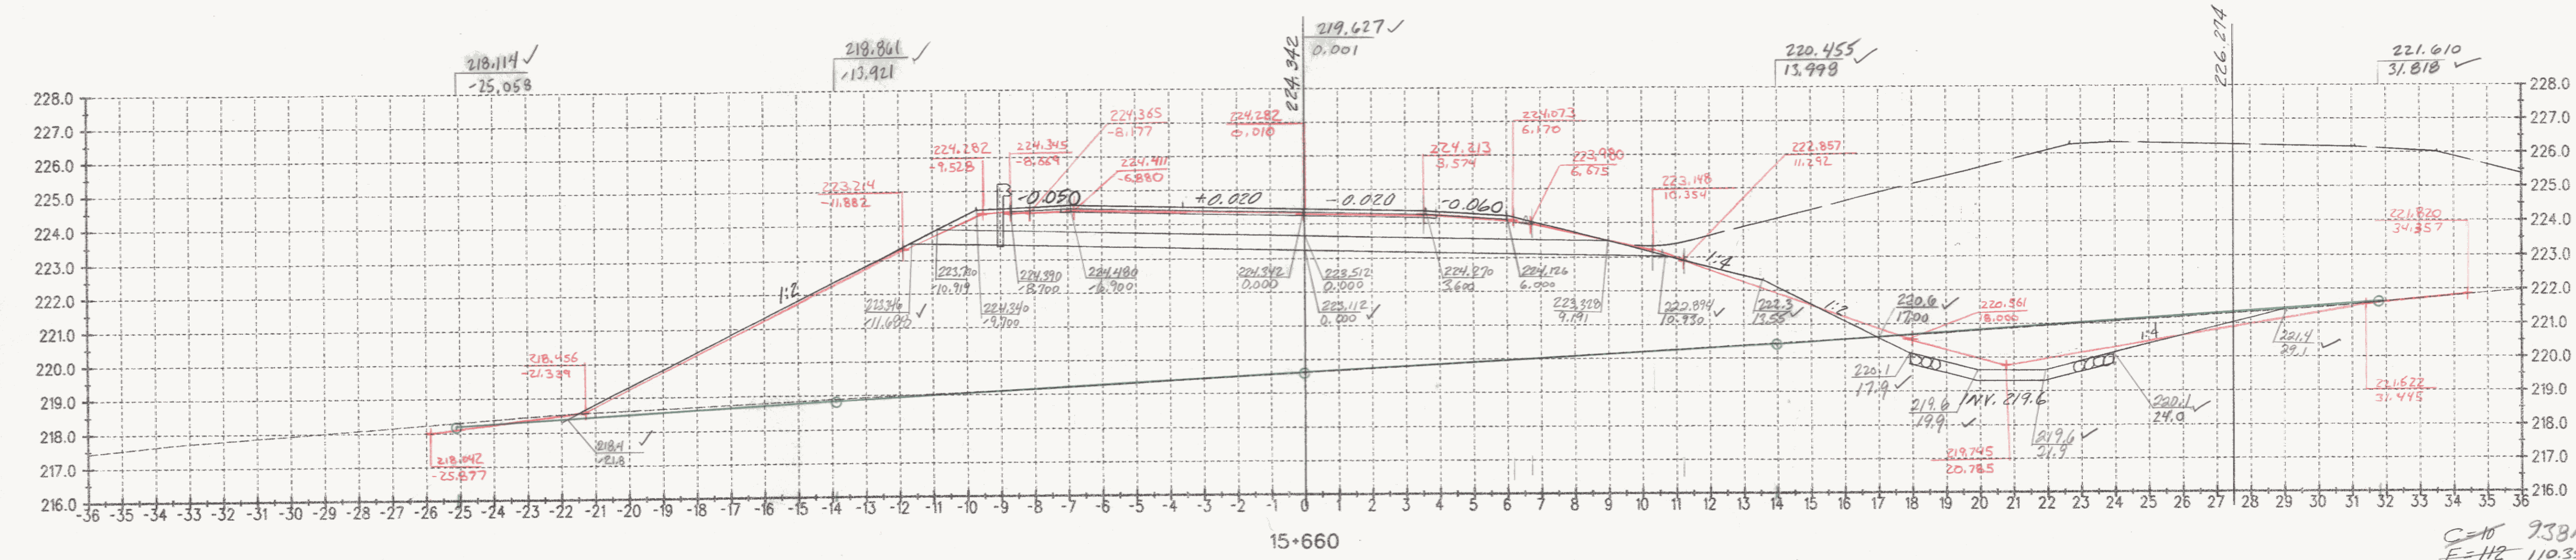

C=10  
E=112  
R=0

	BY	V BY
BOTH Sect's	DH 1/14/03	RRM 2-11-03
O.G.	DH 1/14/03	RRM 2-11-03
TEMP. ELEV. + 0/S	DH 1/14/03	RRM 2-11-03

ALL DIMENSIONS IN MILLIMETERS EXCEPT AS INDICATED

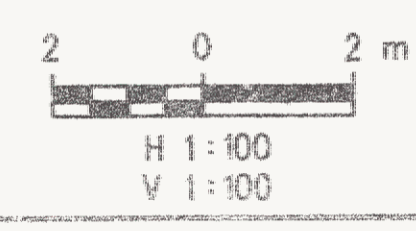

**DATUM**  
VERTICAL NAVD 88  
HORIZONTAL NAD 83 (1992)

SURVEYED BY C.H.A. & V.S.E. DATE 6/95  
DESIGNED BY D.E.G. DATE 6/95  
DRAWN BY J.S.L. DATE 6/95  
CHECKED BY T.P.K. DATE 6/95  
DESIGN FILE NO. N/A  
PROJ. NAME BENNINGTON - HOOSICK  
D.P.I. 0146(1) C13  
PROJ. NO. P.I.N. 1306.60.201  
SHEET 431 OF 473 SHEETS DWG No.