

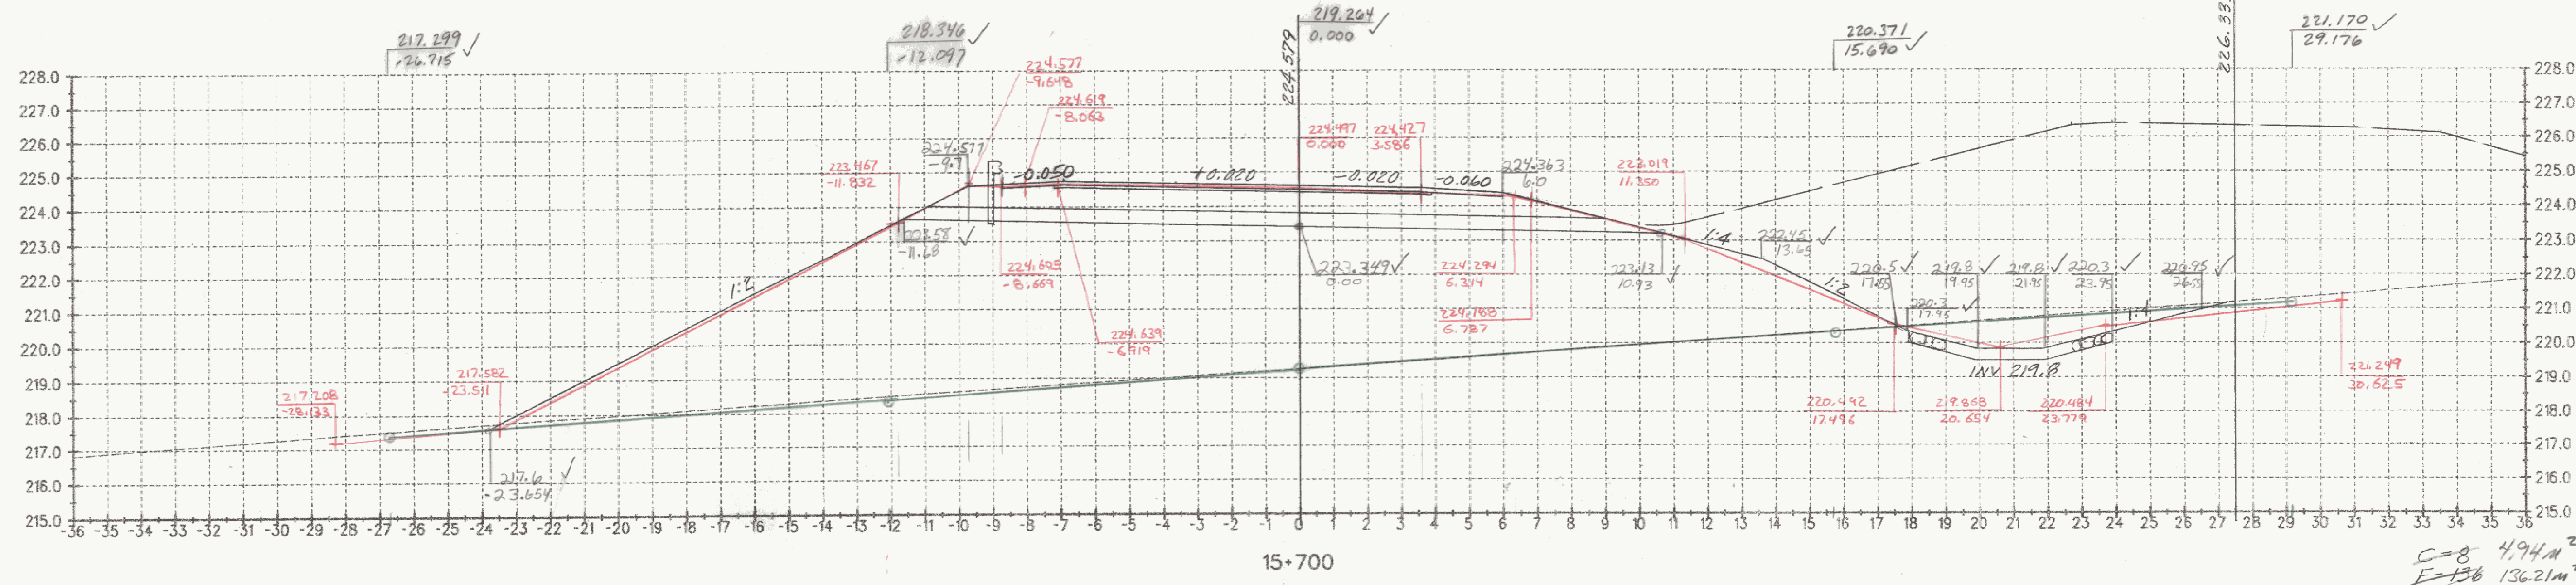


C=5 4.34m²
F=138 135.35m²
R=0

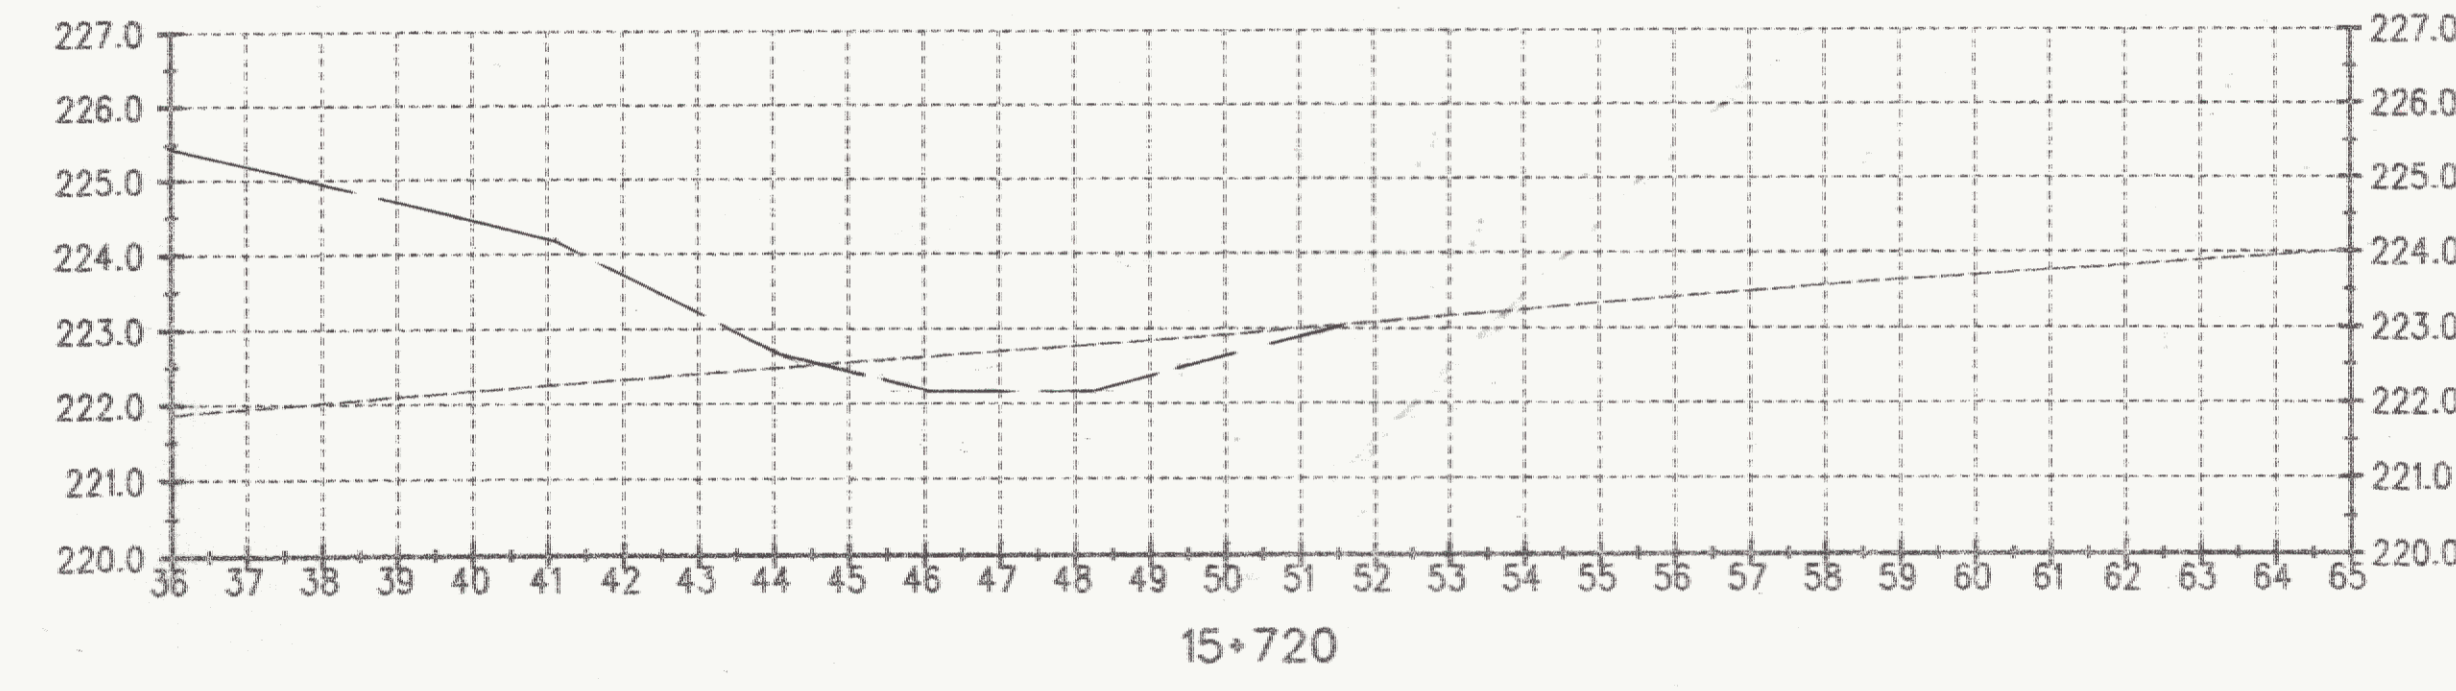

C=8 4.94m²
F=136 136.21m²
R=0

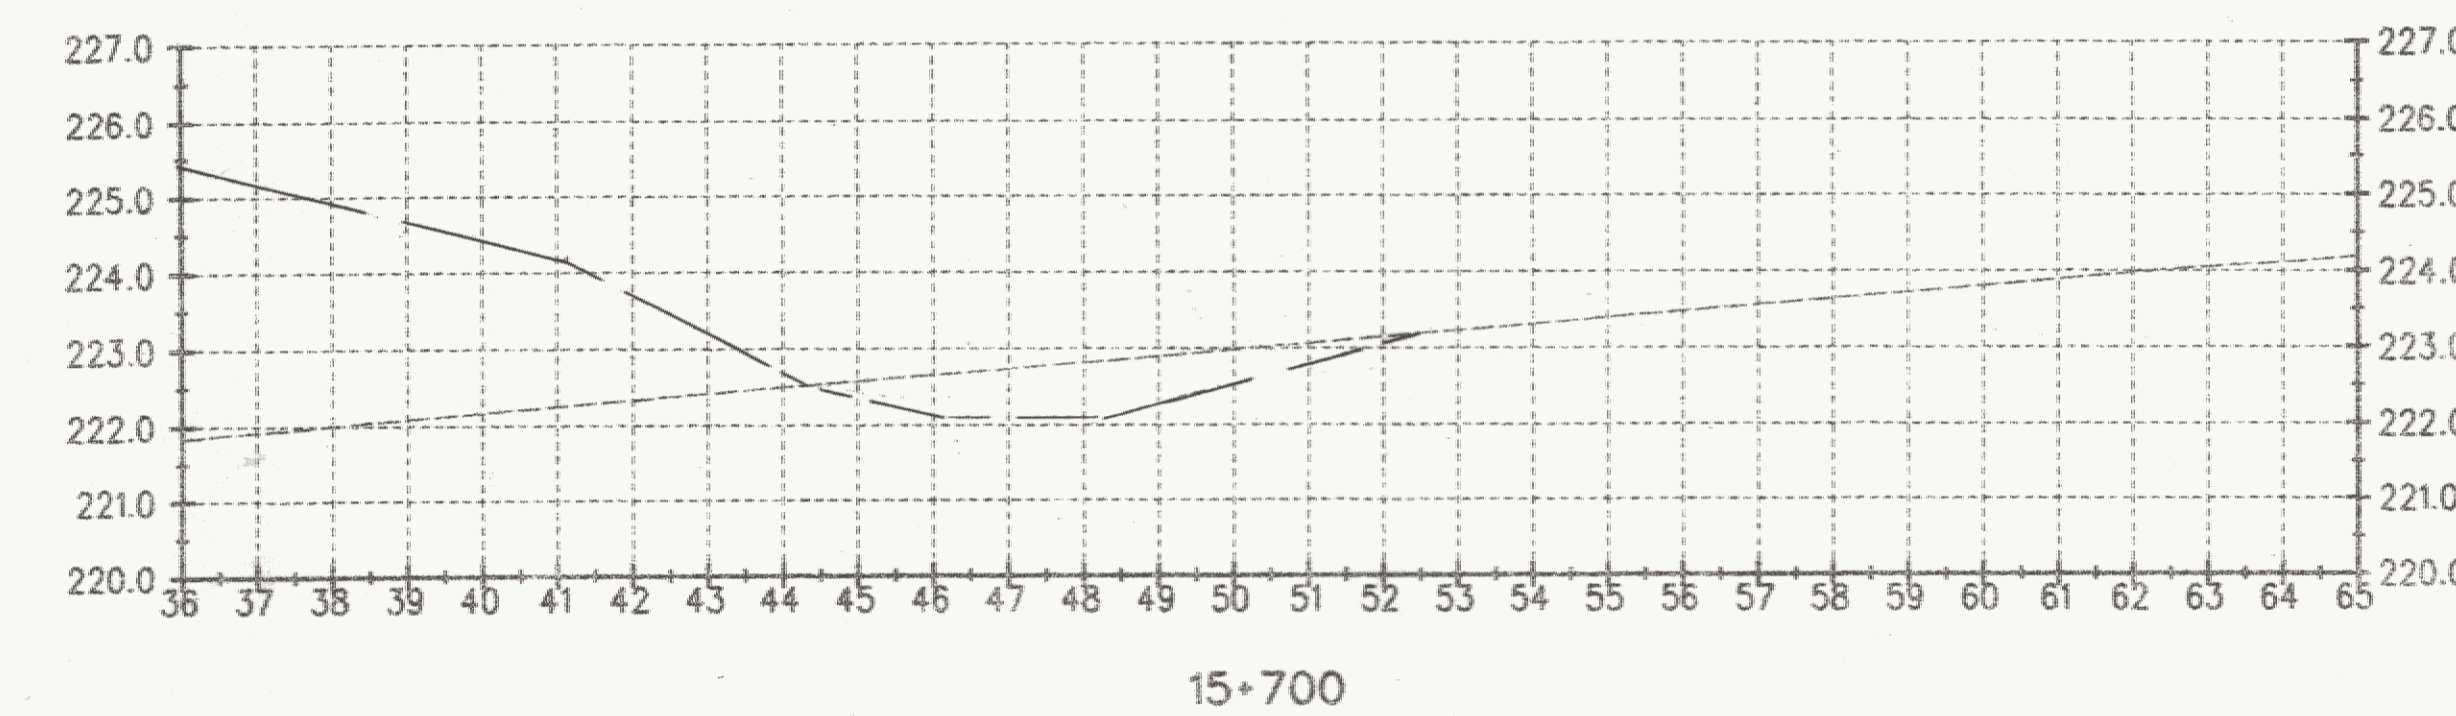

DATUM
VERTICAL NAVD 88
HORIZONTAL NAD 83 (1992)

Both Sections	By	✓ By
O.G.	DH 11/4/03	KRM Z-11-03
TEMP. ELV. + o/s	DH 11/14/03	KRM Z-12-03
F.G.	BL 11/27/05	<i>[Signature]</i>

ALL DIMENSIONS IN MILLIMETERS EXCEPT AS INDICATED

2 0 2 m

H 1:100
V 1:100



SURVEYED BY C.H.A. & V.S.E. DATE 6/95
DESIGNED BY D.E.G. DATE 6/95
DRAWN BY J.S.L. DATE 6/95
CHECKED BY T.P.K. DATE 6/95
DESIGN FILE NO. N/A
PROJ. NAME BENNINGTON - HOOSICK
D.P.I. 0146(1) C/3
PROJ. NO. P.I.N. 1306.60.201
SHEET 432 OF 473 SHEETS DWG No.