



CA 0.72m<sup>2</sup>  
 F=95 7738+1.91= 99.29m<sup>2</sup>  
 R=0

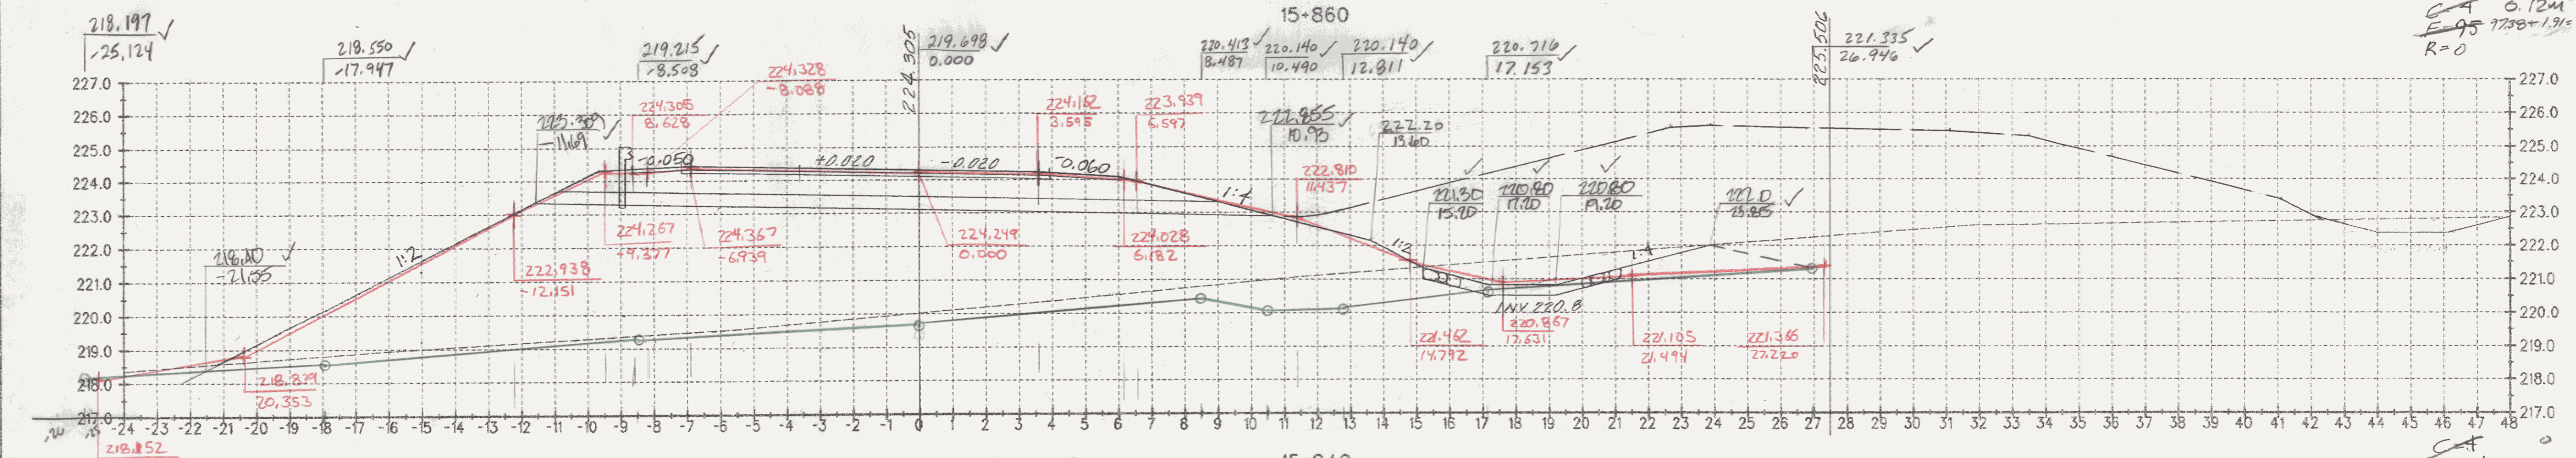


CA 0  
 F=94 136.37m<sup>2</sup>  
 R=0

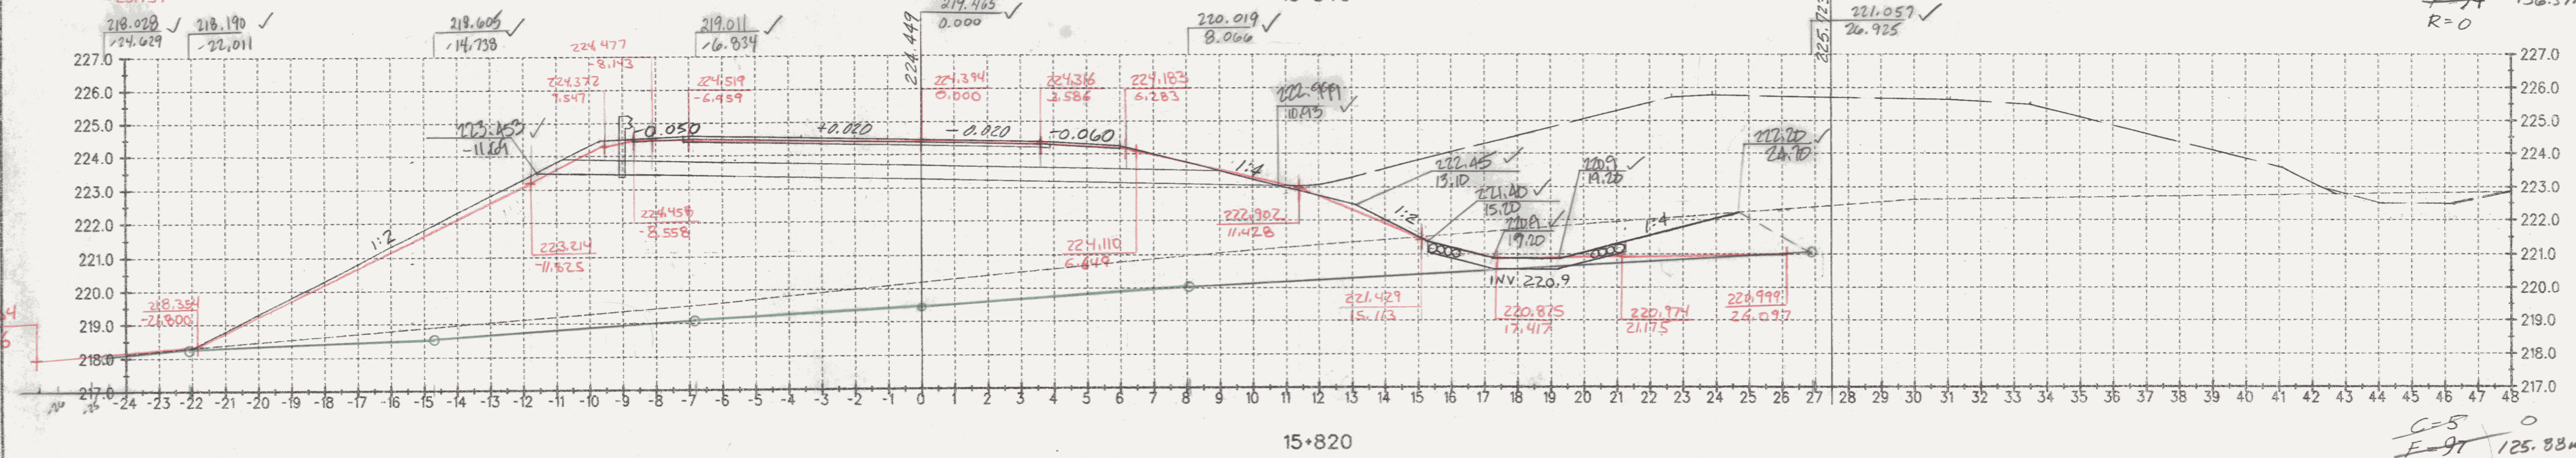

CA 5  
 F=97 125.88m<sup>2</sup>  
 R=0

DATUM  
 VERTICAL NAVD 88  
 HORIZONTAL NAD 83 (1992)

ALL SECT'S	BY	V BY
O.G.	DH 1/14/03	RRM 2-12-03
TEMP.		RRM 2-12-03
ELV. TO/G	TC	RRM 2-12-03
F.G.	BC 2/1/05	Vgn 2/1/05

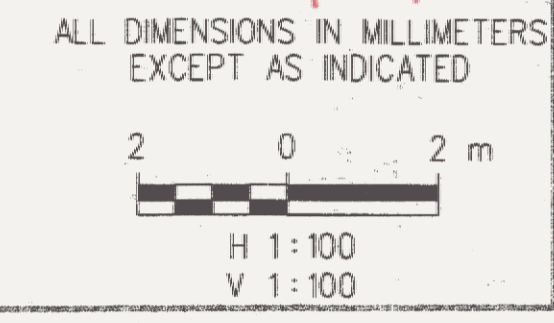

SURVEYED BY C.H.A. & V.S.E. DATE  
 DRAWN BY J.S.L. DATE  
 SQUAD LEADER T.P.K.  
 DESIGN FILE NO. N/A  
 DATE PLOTTED  
 PROJ. NAME BENNINGTON - HOOSICK  
 D.P.I. 0146(1) C/3  
 PROJ. NO. P.I.N. 1306.60.201  
 SHEET 435 OF 473 SHEETS