



C=6.77m²
 E=8* 77.33m²
 R=0

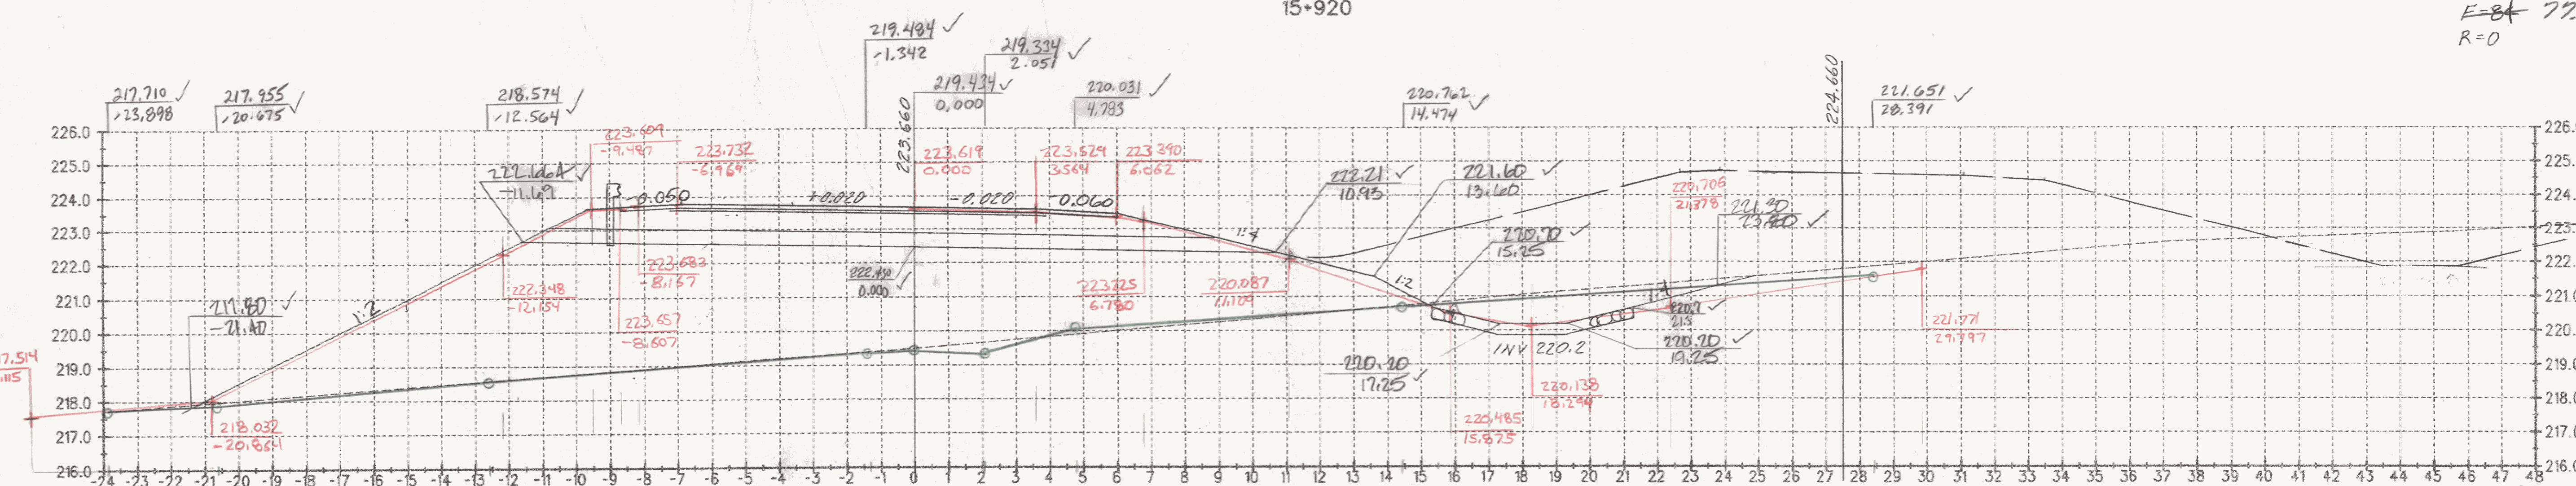

C=5 383m²
 F=92 89.33m²
 R=0

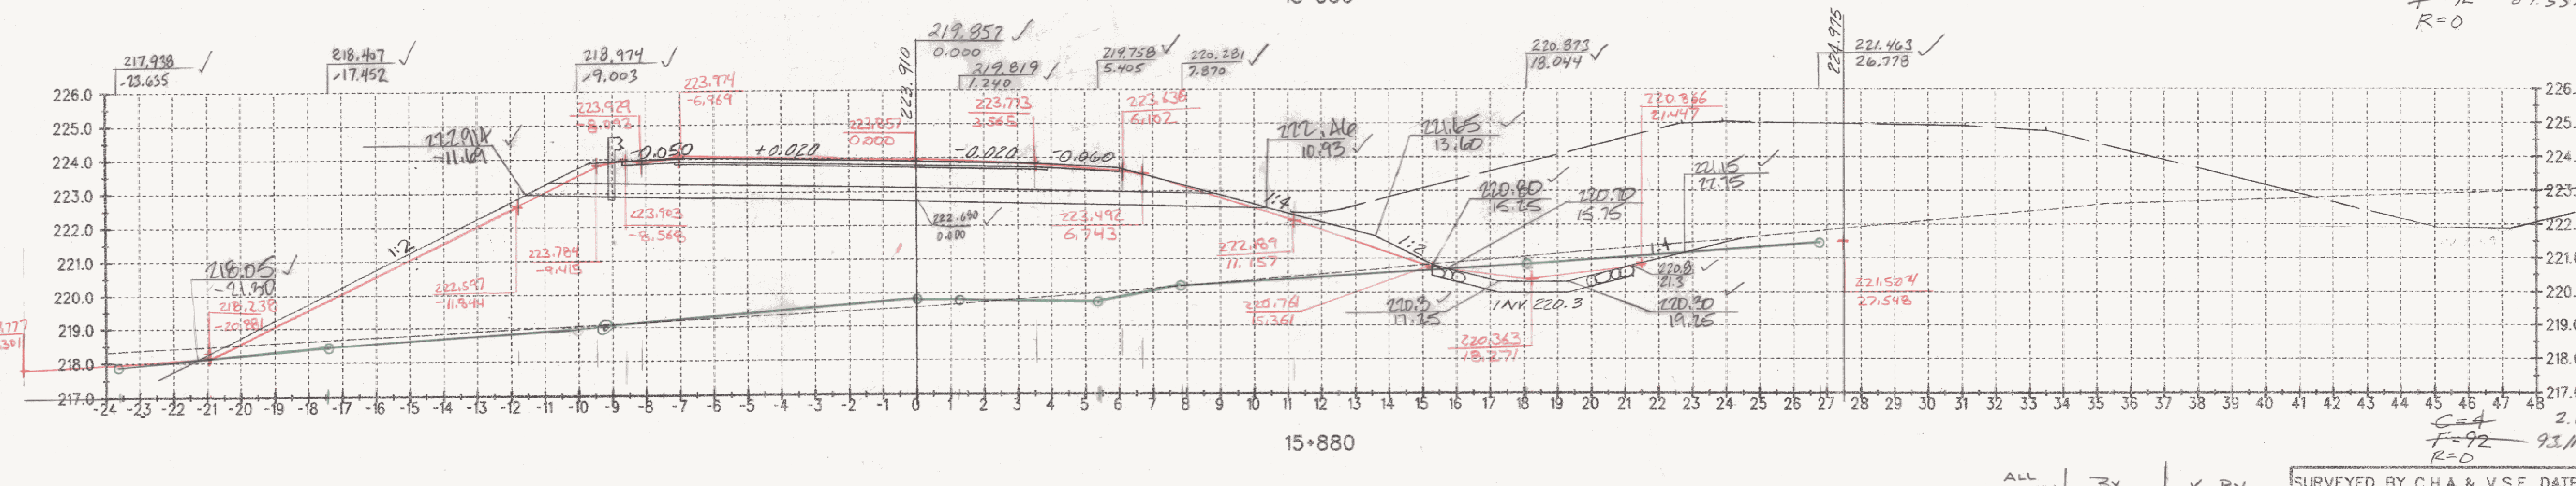

C=4 2.67m²
 F=92 93.11m²
 R=0

DATUM

VERTICAL	NAVD 88
HORIZONTAL	NAD 83 (1992)

ALL SECT'S	BY	V BY
D.G.	DN 1/14/03	RRM 2-12-03
TEMP.		RRM 2-12-03
ELV. +/- S.	TC	
ALL DIMENSIONS IN MILLIMETERS EXCEPT AS INDICATED		
FG	BL 3/2/05	VIP
2 0 2 m		
H 1:100		
V 1:100		

SURVEYED BY	C.H.A. & V.S.E.	DATE	
DRAWN BY	J.S.L.	DATE	
SQUAD LEADER	T.P.K.		
DESIGN FILE NO.	N/A		
PARM FILE		DATE PLOTTED	
PROJ. NAME	BENNINGTON - HOOSICK		
PROJ. NO.	D.P.I. 0146(1) C-13		
P.I.N.	1306.60.201		
SHEET	436	OF 473 SHEETS	