



C=6 7.24m<sup>2</sup>  
 F=91 64.23m<sup>2</sup>  
 R=0

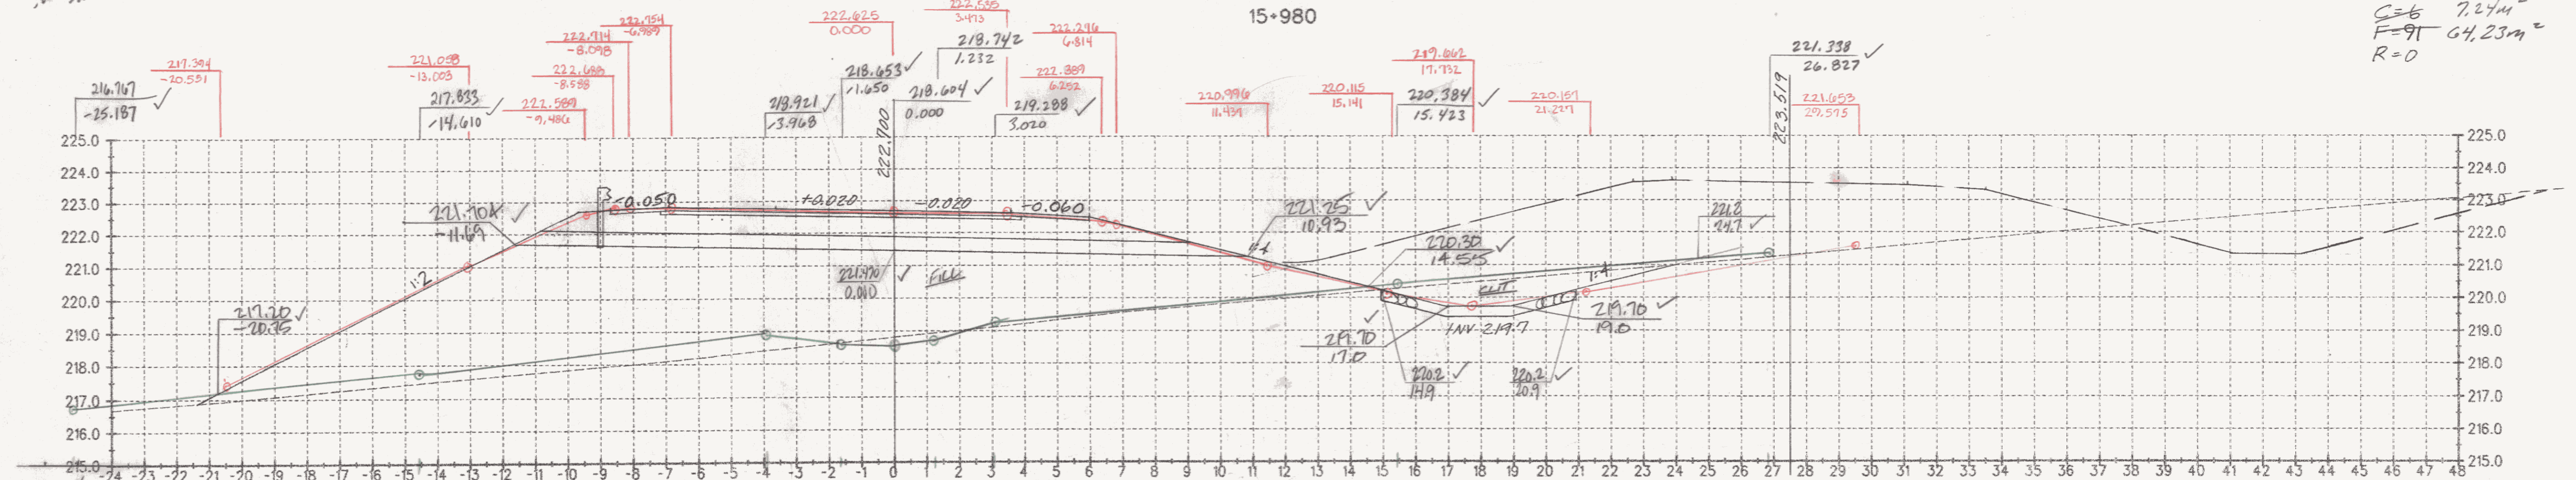

C=6 5.70m<sup>2</sup>  
 F=84 74.62m<sup>2</sup>  
 R=0

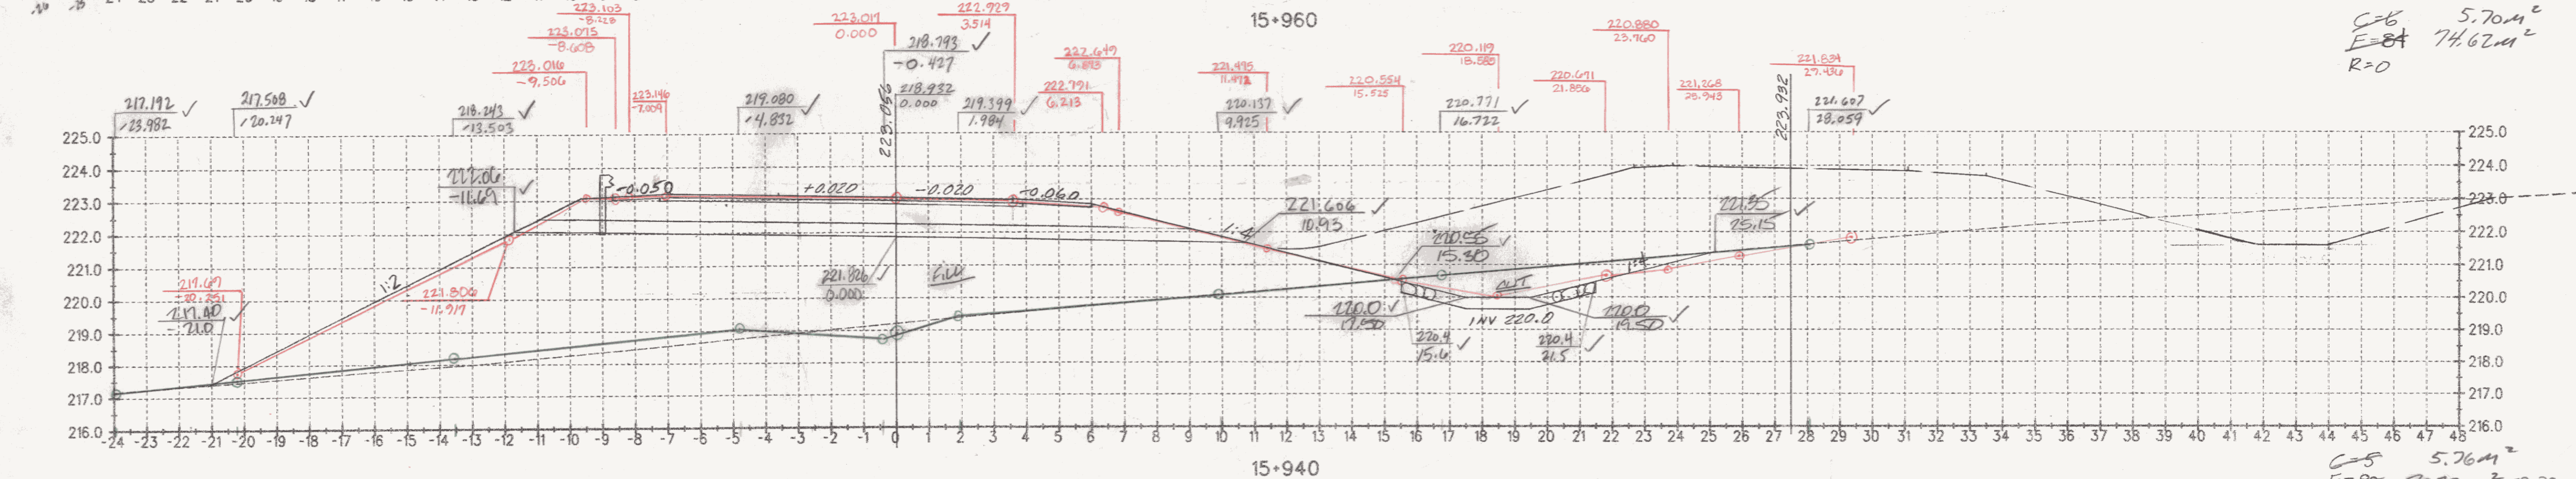

C=5 5.76m<sup>2</sup>  
 F=85 70.75m<sup>2</sup> 78.38  
 R=0

DATUM

VERTICAL	NAVD 88
HORIZONTAL	NAD 83 (1992)

ALL SECT'S	BY	V BY
O.G.	DH 1/14/03	RRM
TEMP	TC	RRM
FLV. +0/S	RRM 3/17/03	RRM
F.G.	RRM 3/17/03	RRM 3/17/03

ALL DIMENSIONS IN MILLIMETERS EXCEPT AS INDICATED

H 1:100  
 V 1:100

SURVEYED BY C.H.A. & V.S.E. DATE  
 DRAWN BY J.S.L. DATE  
 SQUAD LEADER T.P.K.  
 DESIGN FILE NO. N/A  
 IPARM FILE DATE PLOTTED  
 PROJ. NAME BENNINGTON - HOOSICK  
 D.P.I. 0146(1) C/3  
 PROJ. NO. P.I.N. 1306.60.201  
 SHEET 437 OF 473 SHEETS